


DESCRIPTION: WILLIAM D. SALLY & PATRICIA A. SALLY (TO CORRECT DESCRIPTION AND PLAT DATED MAY 24, 1967.)
 COMMENCING AT THE NE CORNER OF LOT 11 OF DROUGHTVILLE PARK, LOCATED IN THE SW 1/4 OF SEC. 25, T4N; R.16E; WALWORTH COUNTY, WISC; THENCE S22°58'43"W 76.38 FEET ALONG THE EAST LINE OF LOTS 11 & 12 TO THE SE CORNER OF LOT 12; THENCE N55°30'07"W 16.91 FEET TO A POINT THAT IS 5.00 FEET AWAY FROM THE SOUTH LINE OF LOT 12 (AS MEASURED AT RIGHT ANGLES THEREFROM); THENCE N72°43'W PARALLEL TO THE SOUTH LINE OF LOT 12 AND 5.00 FEET THEREFROM, 145.06 FEET MORE OR LESS, TO THE SHORE OF LAUDERDALE LAKE; THENCE NEW ALONG SAID SHORELINE 95.00 FEET MORE OR LESS TO THE NORTH LINE OF LOT 11; THENCE S64°01'54"E ALONG THE NORTH LINE OF LOT 11 156.16 FEET MORE OR LESS TO THE PLACE OF BEGINNING.

DESCRIPTION: JOHN E. CORY & BELLE CORY TO WILLIAM D. & PATRICIA A. SALLY
 COMMENCING AT THE SE CORNER OF LOT 12 OF DROUGHTVILLE PARK, LOCATED IN THE SW 1/4 OF SEC. 25, T4N; R.16E; WALWORTH COUNTY, WIS; THENCE S22°58'43"W 10.20 FEET; THENCE N55°30'07"W 17.40 FEET; THENCE N72°43'W 144.83 FEET MORE OR LESS TO THE SHORE OF LAUDERDALE LAKE; THENCE NEW ALONG SAID SHORE 10.00 FEET MORE OR LESS; THENCE S72°43'E 145.06 FEET MORE OR LESS; THENCE S55°30'07"E 16.91 FEET TO THE PLACE OF BEGINNING.

CERTIFICATE:
 I, JOSEPH M. BIAGI, SURVEYOR, DO HEREBY CERTIFY THAT I HAVE SURVEYED THE PROPERTY HEREON DESCRIBED.

SIGNED: NOV. 26, 1974

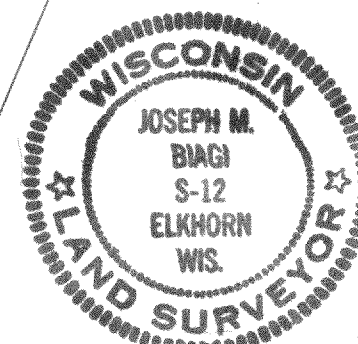

Joseph M. Biagi
 JOSEPH M. BIAGI RLS 12

REVISIONS			MR. DON SALLY	
NO.	DATE	BY	LOTS 11, 12, & P. 13 DROUGHTVILLE PARK	
1				
2				
3			DRAWN BY	SCALE
4			CHK'D	DATE
5			TRACED	APP'D
			G.P.W.	1"=20'
			H.W.G.	11/22/74
			JMB.	123-74

LEGEND

- IRON PIPE FOUND
- ✱ SPIKE FOUND
- IRON PIPE SET

HDP-16