


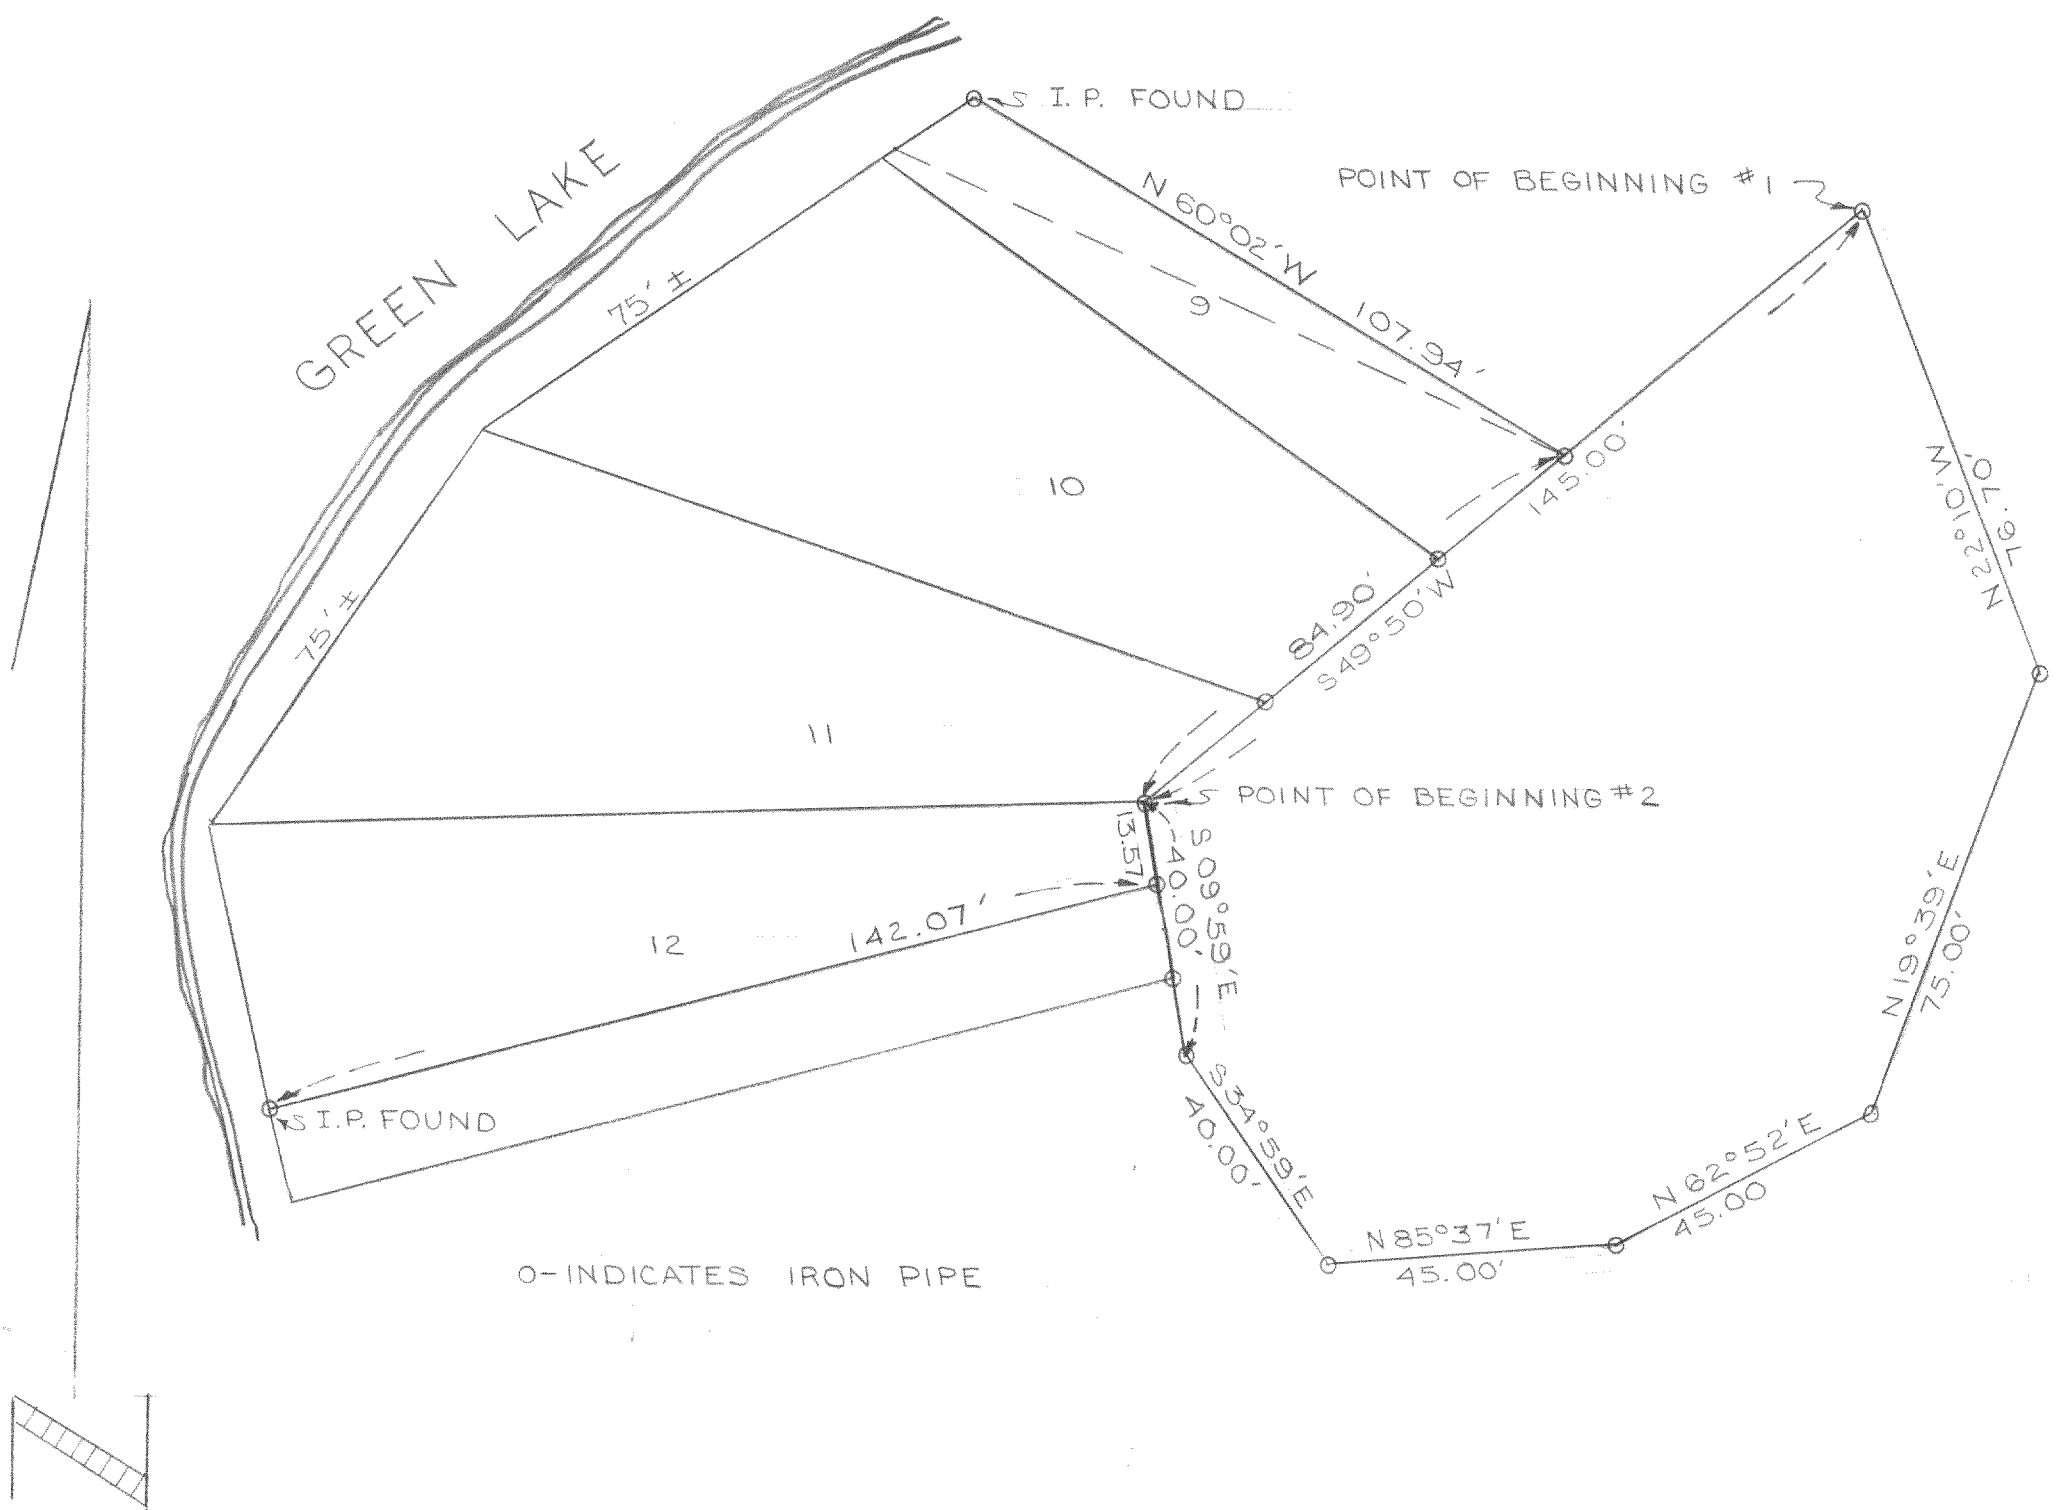

DESCRIPTION: Commencing at eastern most corner of Lot 8, plat of Green Island, (Deakin Isle) T.4N., R.16E., Walworth County, Wisconsin, also the point of beginning of the lands hereinafter described, to wit; thence S 49°50' W along the southeasterly line of Lots 8, 9, 10, and 11, 145.00 feet to the NE corner Lot 12, thence S 09°59' E along the eastern line of Lots 12, and 13, 40.00 feet to the NE corner Lot 14, thence S 34°59' E along the northeastern line of Lots 14, and 15, 40.00 feet to the NW corner of Lot 16, thence N 85°37' E along the northern line of Lots 16, 17, and 18, 45.00 feet to the NW corner of Lot 19, thence N 62°52' E along the northern line of Lots 19, 20, and 21, 45.00 feet to the northeasterly corner of Lot 22, thence N 19°39' E along the western line of Lots 22, 23, and 24, 75.00 feet to the northwesterly corner of Lot 24, thence N 22°10' W, 76.70 feet to the point of beginning.

DESCRIPTION: Commencing at the SE corner of Lot 11, plat of Green Island (Deakin Isle), T.4N., R.16E., Walworth County, Wisconsin, also the point of beginning of the lands hereinafter described, to wit, thence N 49°50' E, along the eastern line of Lots 11, 10, and 9, 84.90 feet, thence N 60°02' W, 107.94 feet, thence southwesterly and southerly along the shore of Green Lake to an iron pipe which is 75.00 feet northerly of the SW corner of Lot 13, thence northeasterly 142.07 feet to a point on the eastern line of Lot 12 which is S 09°59' E, 13.57 feet from the NE corner of said Lot 12, thence N 09°59' W along the east line of Lot 12, 13.57 feet to the point of beginning.

CERTIFICATE: I, James F. Biagi, surveyor, do hereby certify that I have surveyed the lands hereon described.

April 17, 1970

James F. Biagi
James F. Biagi R.L.S. 272