

Wisconsin Registered Land Surveyor S-1594


Rt. 3, Box 273
Elkhorn, Wisconsin 53121
Phone: (414) 723-4260 (office)
(414) 723-4813 (residence)

UNIT 12 OF LAUDERDALE SHORES A
RECREATIONAL VEHICLE CONDOMINIUM LOCATED
IN THE NORTHWEST 1/4 OF SECTION 25, TOWN 4
NORTH, RANGE 16 EAST, WALWORTH COUNTY,
WISCONSIN.

ORDERED BY: EDWARD HACHMEISTER
RT. 1 PB 2
ELKHORN, WI. 53121

NOTE:


EXISTING RV TRAILER NOT
SHOWN ON PAD

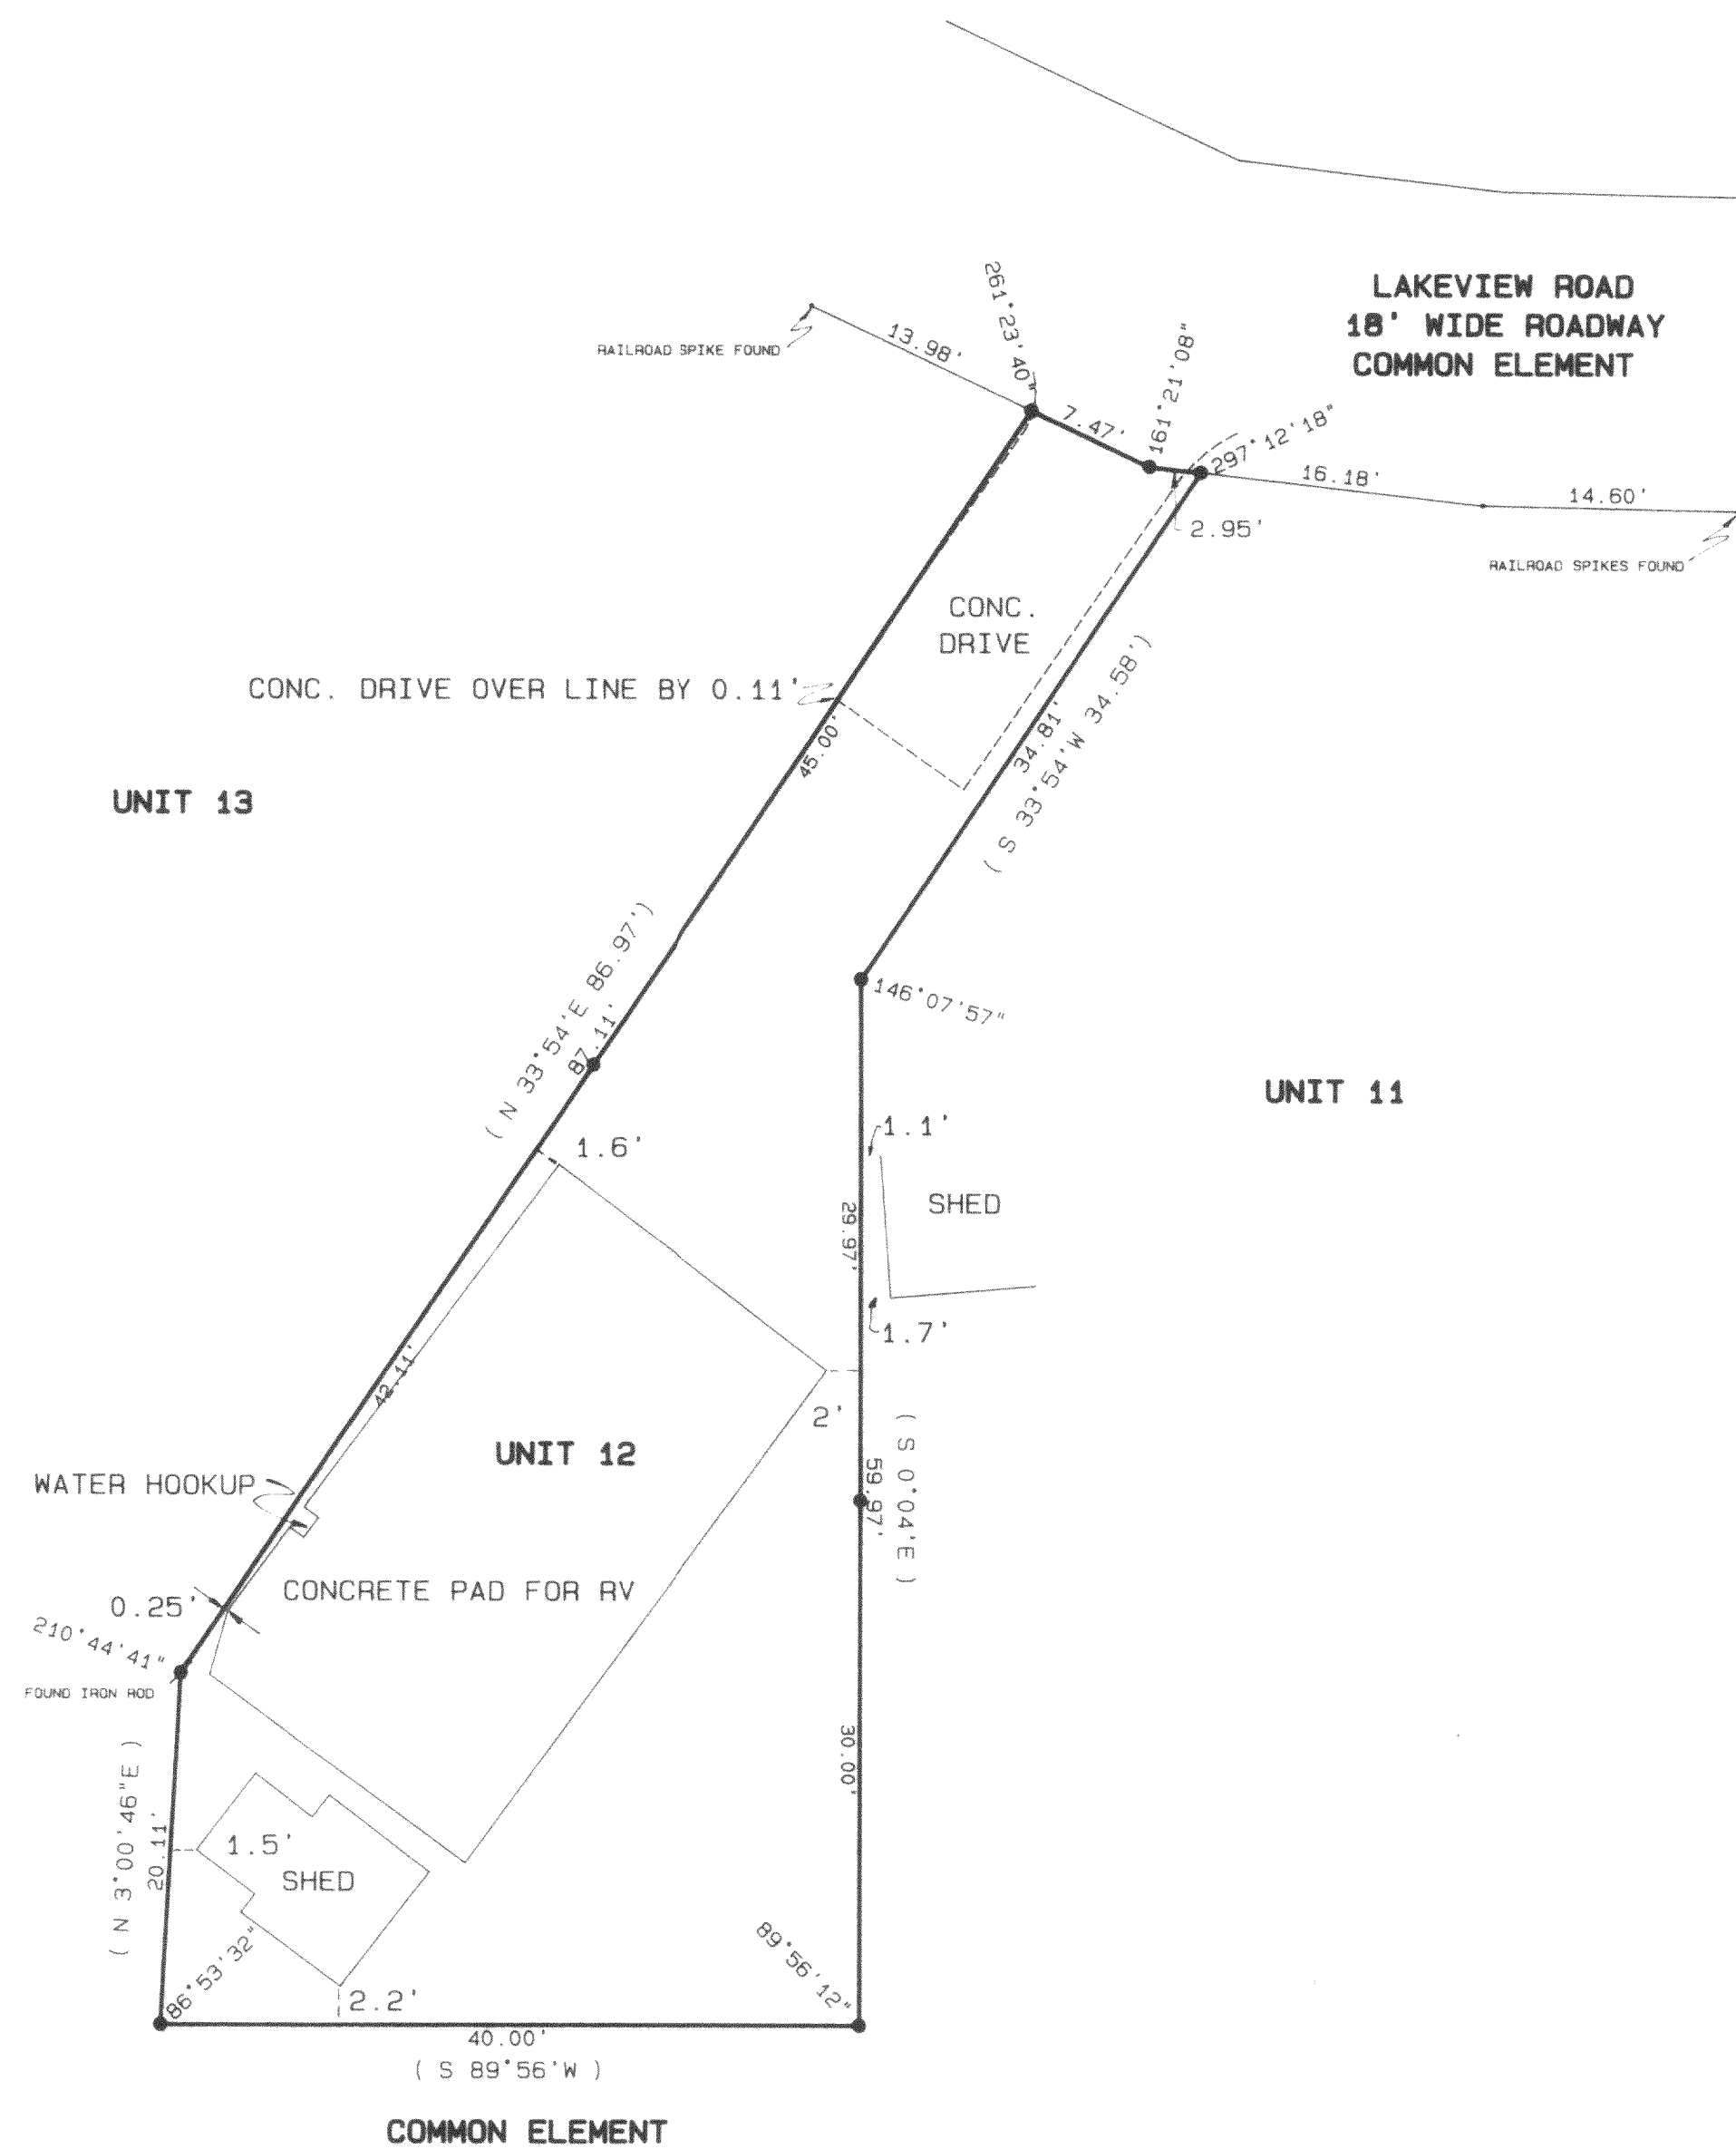

SCALE 1" = 10 FEET

Legend

- FOUND IRON PIPE
● FOUND IRON ROD
FOUND BRASS CAPPED MONUMENT
✕ FOUND CONCRETE MONUMENT
+ CHISEL CUT IN CONCRETE
● SET IRON ROD, 24" LONG, WEIGHING
1.5 LBS., LINEAL FT., 3/4" DIA.
● SET IRON ROD, 30" LONG, WEIGHING
4.5 LBS., LINEAL FT., 1-11/16" DIA.
(xx) RECORDED AS DIMENSION
—X—X— EXISTING FENCE

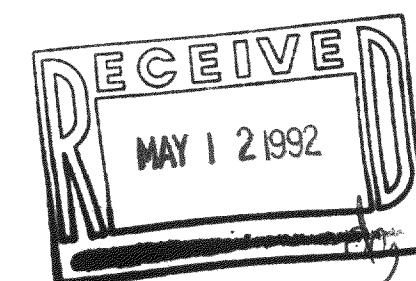

SCALE: 1" = 10 FEET

"I hereby certify that I have surveyed the above described property and that the above map is a true representation thereof and shows the size and location of the property, its exterior boundaries, the location of all visible structures and dimensions of all principal buildings thereon, boundary fences, apparent easements, roadways and visible encroachments, if any."

"This survey is made for the use of the present owners of the property, and also those who purchase, mortgage, or guarantee the title thereto within one year from date hereoff."

Kenneth B. Abernathy, Jr.
WISCONSIN REGISTERED LAND SURVEYOR,
S-1594

Date: SEPTEMBER 25, 1991 Job No. 91.919

416-803

HLAS-12