

PLAT OF SURVEY

Lot 10 of Farm Village Subdivision, Located in the Southwest 1/4 of Section 25, Town 4 North, Range 16 East, La Grange Township, Walworth County, Wisconsin.


ORDERED BY: MICHAEL R. ZUEHLKE  
RT. 5 BOX 393A  
ELKHORN, WI. 53121

BEARINGS ARE REFERENCED TO SUBDIVISION PLAT

LOT 9

LOT 10  
5.49 ACRES

LOT 11

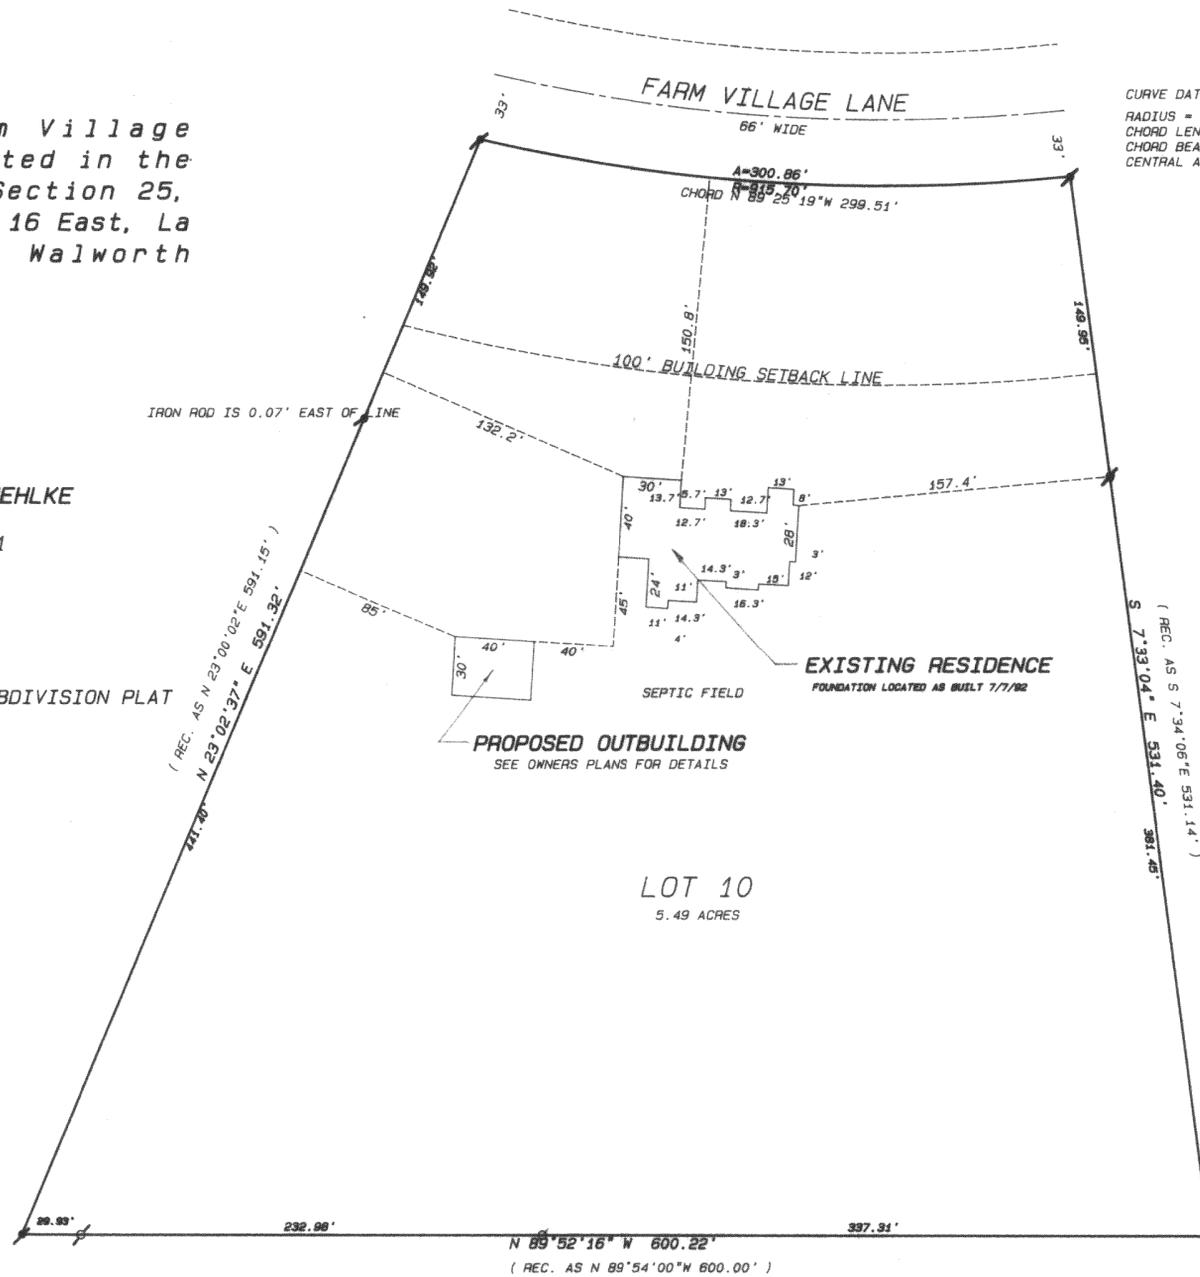


CURVE DATA:  
RADIUS = 915.70'  
CHORD LENGTH = 299.54'  
CHORD BEARING = (N 89° 25' 19" W)  
CENTRAL ANGLE = 18° 50' 00"



SCALE 1" = 60 FEET

Legend

- ⊗ FOUND IRON PIPE
- ⊙ FOUND IRON ROD
- FOUND BRASS CAPPED MONUMENT
- FOUND CONCRETE MONUMENT
- + CHISEL CUT IN CONCRETE
- SET IRON ROD, 24" LONG, WEIGHING 1.5 LBS./LINEAL FT., 3/8" DIA.
- SET IRON ROD, 30" LONG, WEIGHING 4.5 LBS./LINEAL FT., 1-11/16" DIA.
- (XX) RECORDED AS DIMENSION
- - - - - EXISTING FENCE

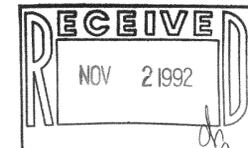

SCALE: 1" = 60 FEET



"I hereby certify that I have surveyed the above described property and that the above map is a true representation thereof and shows the size and location of the property, its exterior boundaries, the location of all visible structures and dimensions of all principal buildings thereon, boundary fences, apparent easements, roadways and visible encroachments, if any."  
"This survey is made for the use of the present owners of the property, and also those who purchase, mortgage, or guarantee the title thereto within one year from date hereof."

*Kenneth B. Abernathy Jr.*

KENNETH B. ABERNATHY, JR.  
WISCONSIN REGISTERED LAND SURVEYOR,  
S-1594

Date: 7/9/92 Job No. 90.512

REVISE 7/28/92 AS BUILT

ABERNATHY and ASSOCIATES

Kenneth B. Abernathy Jr.

Wisconsin Registered Land Surveyor S-1594

Rt. 3, Box 273  
Elkhorn, Wisconsin 53121  
Phone: (414) 723-4260 (office)  
(414) 723-4813 (residence)

PLAT OF SURVEY

**LEGAL DESCRIPTION**  
Lot 10 of Farm Village  
Subdivision, Located in the  
Southwest 1/4 of Section 25,  
Town 4 North, Range 16 East, La  
Grange Township, Walworth  
County, Wisconsin.


ORDERED BY: MICHAEL R. ZUEHLKE  
RT. 5 BOX 393A  
ELKHORN, WI. 53121

BEARINGS ARE REFERENCED TO SUBDIVISION PLAT

LOT 9

LOT 10  
5.49 ACRES

LOT 11

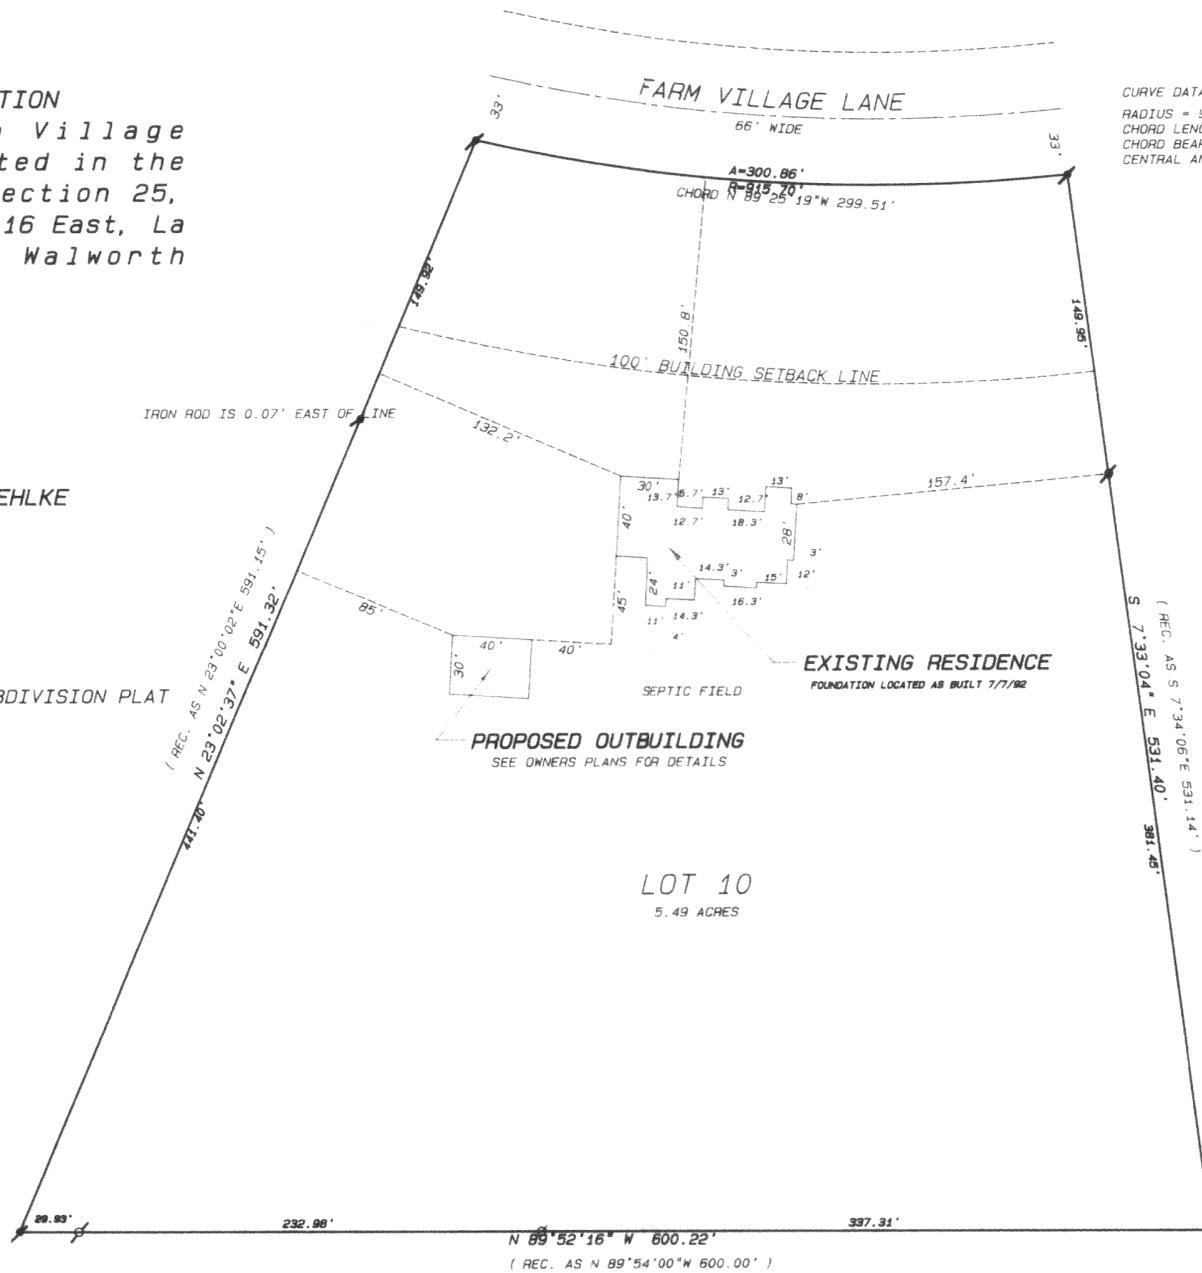

SCALE 1" = 60 FEET

Legend

- FOUND IRON PIPE
- FOUND IRON ROD
- FOUND BRASS CAPPED MONUMENT
- FOUND CONCRETE MONUMENT
- + CHISEL CUT IN CONCRETE
- SET IRON ROD, 24" LONG, WEIGHING 1.5 LBS./LINEAL FT., 3/4" DIA.
- SET IRON ROD, 30" LONG, WEIGHING 4.5 LBS./LINEAL FT., 1-11/16" DIA.
- (xx) RECORDED AS DIMENSION
- - - EXISTING FENCE



SCALE: 1" = 60 FEET

WALNUT HILLS SUBDIVISION



"I hereby certify that I have surveyed the above described property and that the above map is a true representation thereof and shows the site and location of the property, its exterior boundaries, the location of all visible structures and dimensions of all principal buildings thereon, boundary fences, apparent easements, roadways and visible encroachments, if any."  
 "This survey is made for the use of the present owners of the property, and also those who purchase, mortgage, or guarantee the title thereto within one year from date hereof."

*Kenneth B. Abernathy Jr.*  
 KENNETH B. ABERNATHY, JR.  
 WISCONSIN REGISTERED LAND SURVEYOR,  
 S-1594

Date: 7/9/92 Job No. 90.512

AS BUILT