

ABERNATHY and ASSOCIATES

Kenneth B. Abernathy Jr.

Wisconsin Registered Land Surveyor S-1594

Rt. 3, Box 273
Elkhorn, Wisconsin 53121
Phone: (414) 723-4260 (office)
(414) 723-4813 (residence)

PLAT OF SURVEY

LOT 16 OF DUNBAR ESTATES
SUBDIVISION, LOCATED IN SECTION 36,
TOWN 4 NORTH, RANGE 16 EAST, TOWN OF
LAGRANGE, WALNORTH COUNTY, WISCONSIN.

ORDERED BY: KTR SALES
RT. 1 BOX 377
WALNORTH, WIS. 53184

LOT 17

BURIED CABLE ALONG THIS LINE

EXISTING GRAVEL DRIVE UNDER CONSTRUCTION

MALLARD DRIVE
66' WIDE

SEPTIC VENT

LOT 15

SEPTIC CLEANOUT
SEPTIC

EXISTING RESIDENCE


LOT 16
1.69 ACRES

UNPLATTED LANDS OWNED BY OTHERS

SCALE 1" = 30 FEET

Legend

- FOUND IRON PIPE
- FOUND IRON ROD
- FOUND BRASS CAPPED MONUMENT
- FOUND CONCRETE MONUMENT
- CHISEL CUT IN CONCRETE
- SET IRON ROD, 24" LONG, WEIGHING 1.5 LBS./LINEAL FT., 3/4" DIA.
- SET IRON ROD, 30" LONG, WEIGHING 4.5 LBS./LINEAL FT., 1-11/16" DIA.
- (xx) RECORDED AS DIMENSION
- EXISTING FENCE

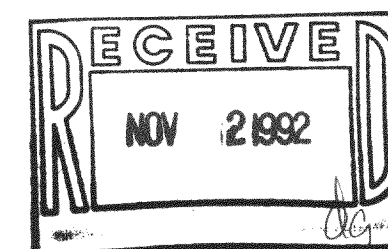

SCALE: 1" = 30 FEET

"I hereby certify that I have surveyed the above described property and that the above map is a true representation thereof and shows the size and location of the property, its exterior boundaries, the location of all visible structures and dimensions of all principal buildings thereon, boundary fences, apparent easements, roadways and visible encroachments, if any."

"This survey is made for the use of the present owners of the property, and also those who purchase, mortgage, or guarantee the title thereto within one year from date hereof."

Kenneth B. Abernathy Jr.
KENNETH B. ABERNATHY, JR.
WISCONSIN REGISTERED LAND SURVEYOR,
S-1594
Date: 9/29/92 Job No. 92-702

