


#134B-65

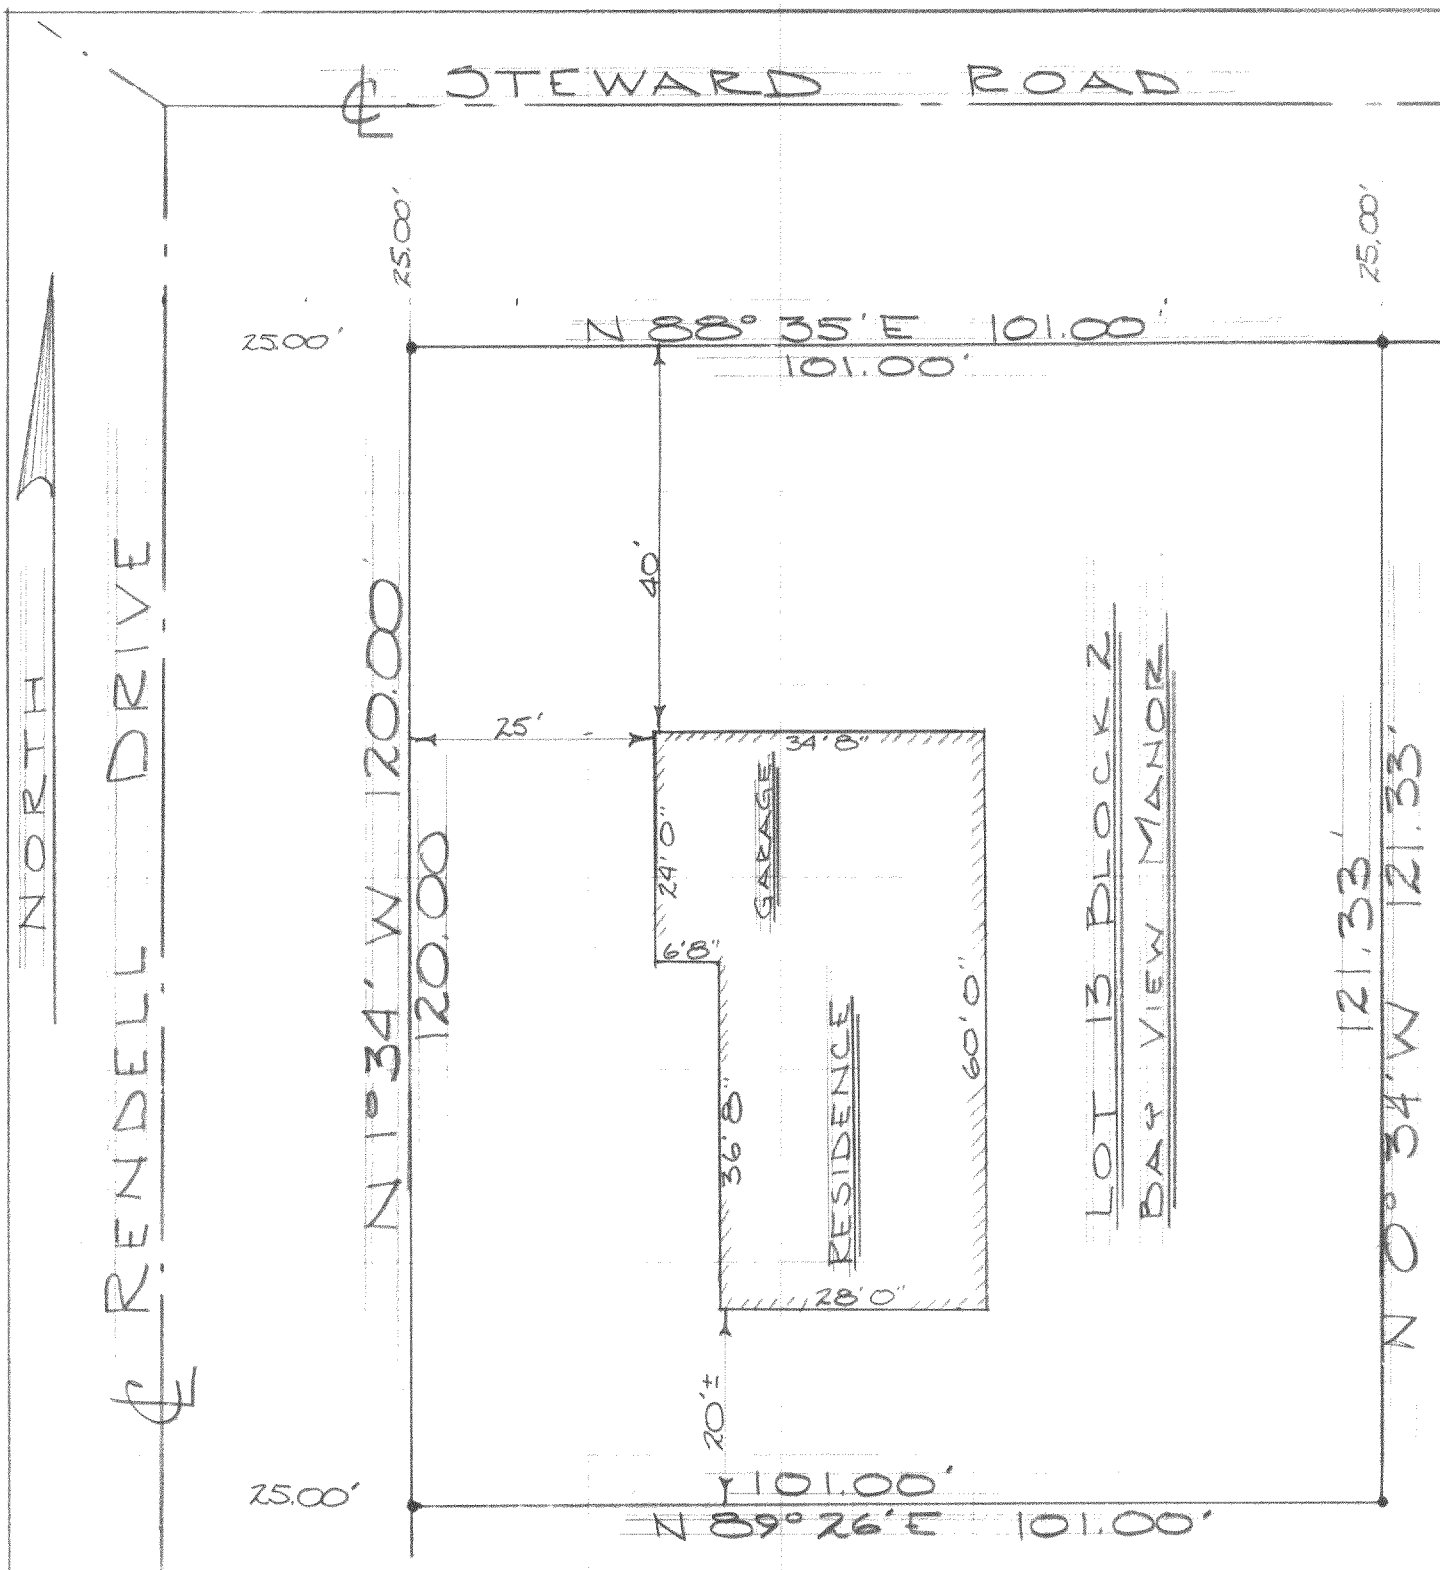


DESCRIPTION: Lot 13 of Block 2 of Bay View Manor in Section 36, Town 4 North, Range 16 East, Walworth County, Wisconsin.

CERTIFICATE: I, James F. Biagi, surveyor, do hereby certify that I have surveyed the property hereon described and that the location of the improvements are as shown.

April 16, 1965

James F. Biagi

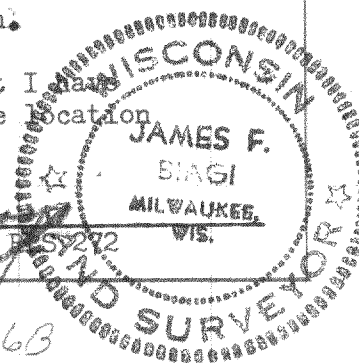

4B-38

416-86B