


**ABELL
SURVEYING & MAPPING**
DELAVER, WISCONSIN 53115
414-728-6737

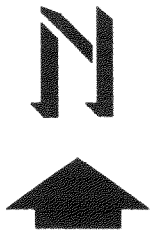

SCALE 1"=20'


LEGEND

- ⊙ - IRON PIPE FOUND
- - IRON PIPE SET, FOUND 8/25/92
- △ - UTILITY POLE
- - OVERHEAD UTILITY LINES
- () - RECORDED AS


PLAT OF SURVEY OF

LOT 118, BUBBLING SPRINGS SUBDIVISION
2nd ADDITION, LOCATED IN T4N, R16E,
WALWORTH COUNTY, WISCONSIN.

REVISED: AUGUST 26, 1992 TO SHOW THE
LOCATION OF THE NEW WELL.

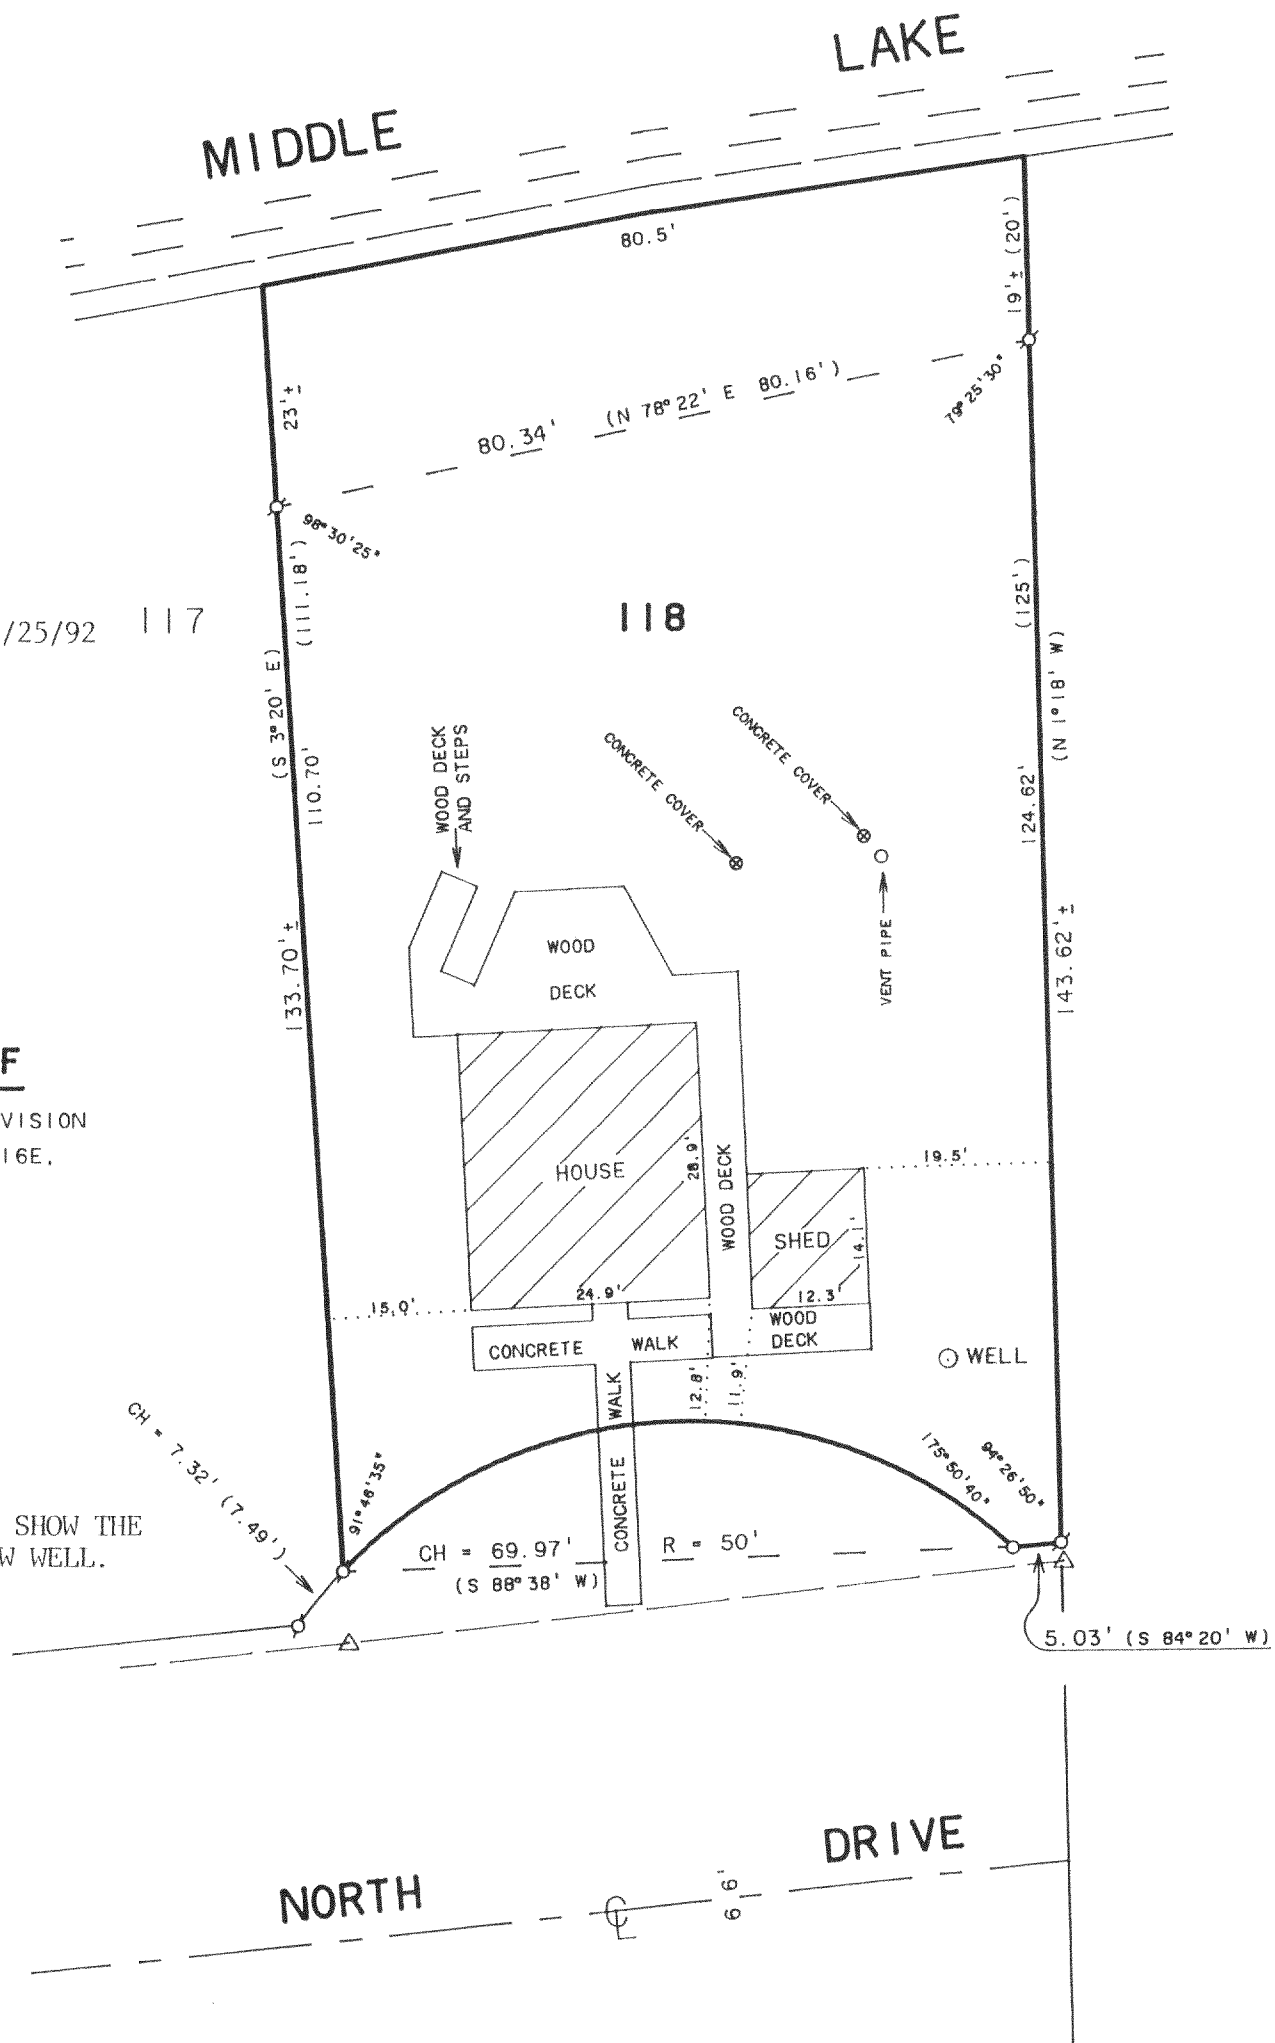

ORDERED BY: COLONY REALTY
16 E. WALWORTH ST.
ELKHORN, WI. 53121

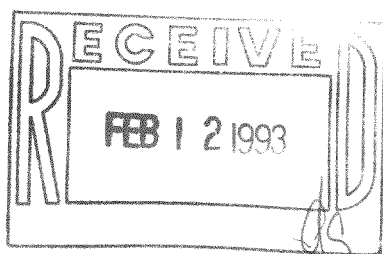

I HEREBY CERTIFY THAT I HAVE SURVEYED THE ABOVE DESCRIBED PROPERTY AND THAT THE ABOVE MAP IS A TRUE REPRESENTATION THEREOF AND SHOWS THE SIZE AND LOCATION OF THE PROPERTY, ITS EXTERIOR BOUNDARIES, THE LOCATION OF ALL VISIBLE STRUCTURES AND DIMENSIONS OF ALL PRINCIPAL BUILDINGS THEREON, BOUNDARY FENCES, APPARENT EASEMENTS, ROADWAYS AND VISIBLE ENCROACHMENTS, IF ANY, TO THE BEST OF MY KNOWLEDGE AND BELIEF.

THIS SURVEY IS MADE FOR THE USE OF THE PRESENT OWNERS OF THE PROPERTY, AND ALSO THOSE WHO PURCHASE, MORTGAGE, OR GUARANTEE THE TITLE THERETO WITHIN ONE (1) YEAR FROM DATE HEREOF.

David F. Abell
DAVID F. ABELL

WISCONSIN REGISTERED LAND SURVEYOR, S-1596

September 18, 1991

DATE JOB NUMBER - 91198

NOTE: THIS IS NOT A CERTIFIED COPY UNLESS SEALED.