
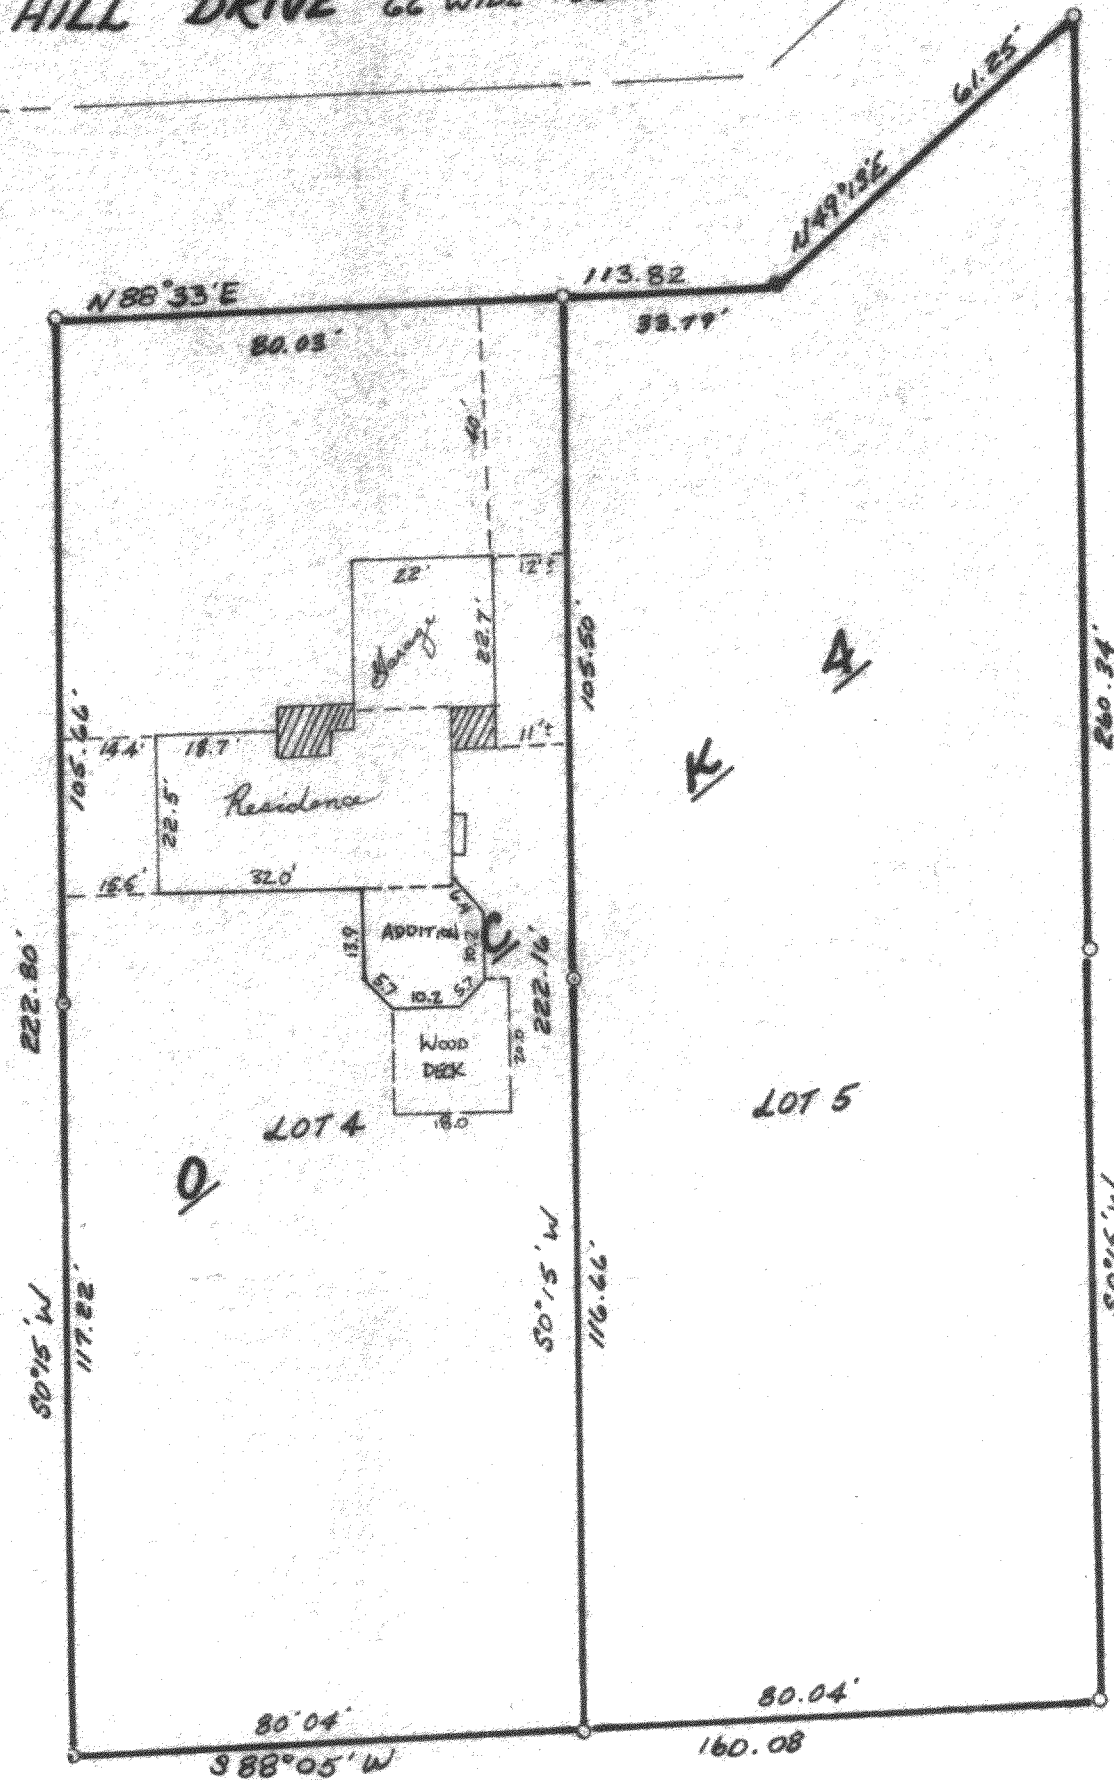


PLAT OF SURVEY OF LOTS 3, 4, & 5
BLOCK 4 OF COOL HILL PARK SUBDIVISION LOCATED IN
SECTION 35, T4N, R16E, WALWORTH COUNTY, WISCONSIN.

COOL HILL DRIVE 66' WIDE PUBLIC

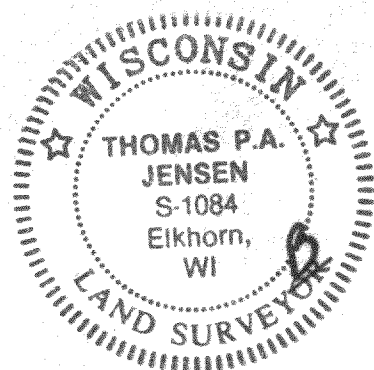

JENSEN SURVEYING & MAPPING S.C.

P.O. Box 322

ELKHORN, WISC. 53121

PHONE (414) 723-3434

45 S. WISC. ST.

LEGEND

- FOUND 1 1/4" IRON PIPE
- FOUND 2" IRON PIPE

Recertified December 2, 1988.


Thomas P.A. Jensen
Thomas P.A. Jensen S-1084

Lots 4 & 5

1988.136

Lots 4 & 5 recertified January 7,
1992 for current owners:
Rudolph & Donna Zwolfer
2217 North LeClaire
Chicago, Illinois. 60639

Thomas P.A. Jensen R.L.S.-1084
Job reference no. 1992.003

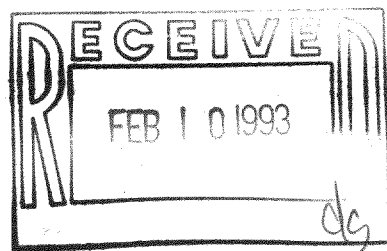

July 22, 1985



Thomas P.A. Jensen
THOMAS P.A. JENSEN S-1084

1985.066

HCH-23

HCH-24

416-892