


KOLB LAND CONSULTING, INC.
LAND SURVEYING • SUBDIVIDING • LAND PLANNING

929 WILLIAMS STREET

LAKE GENEVA, WISCONSIN 53147

414-248-3697

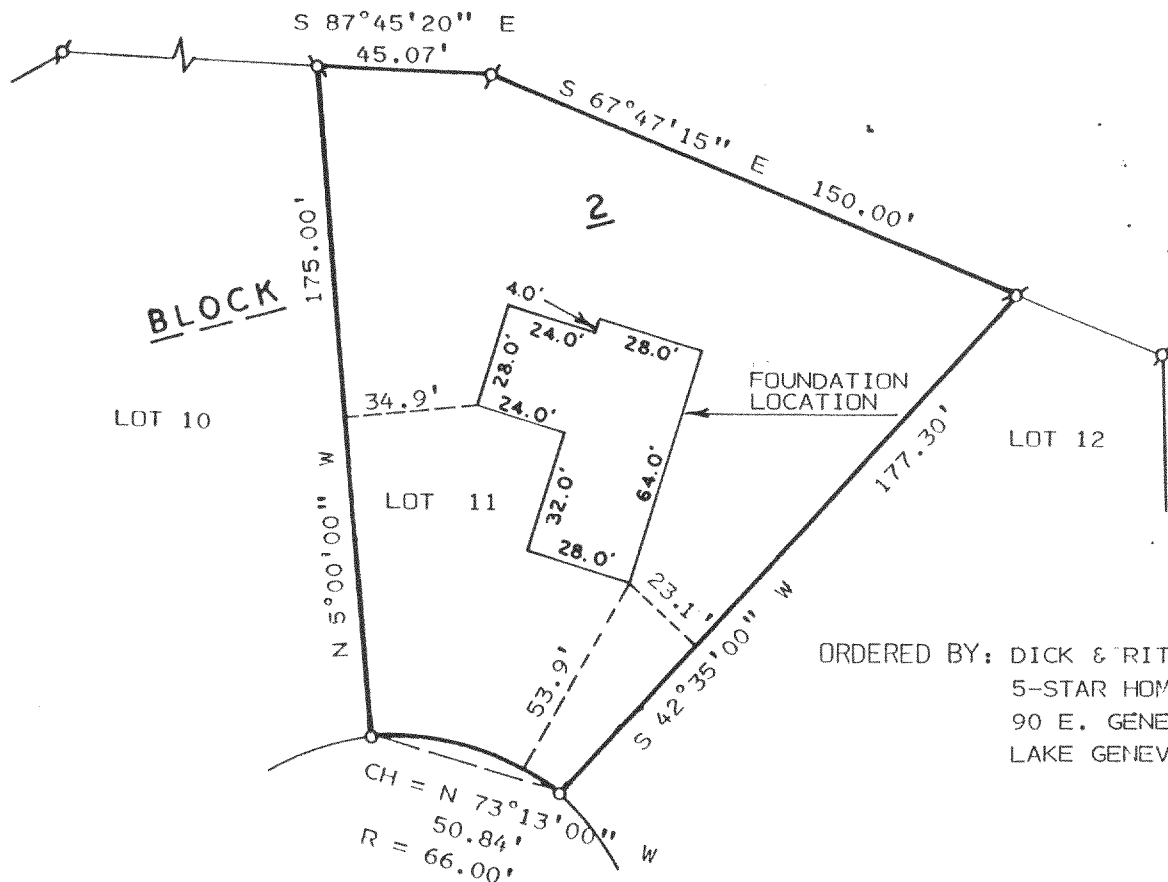


SCALE: 1" = 50'

LEGEND

- Ø - IRON PIPE FOUND
○ - IRON PIPE SET

PLAT OF SURVEY OF

LOT 11, BLOCK 2 OF PEBBLE BEACH A
SUBDIVISION LOCATED IN SECTIONS 25
AND 26, T4N, R16E, TOWN OF LAGRANGE,
WALWORTH COUNTY, WISCONSIN.

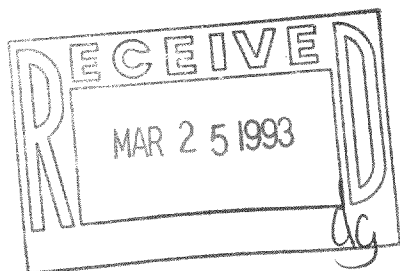

I, HAROLD H. KOLB, DO HEREBY CERTIFY
THAT I HAVE SURVEYED THE PROPERTY
HEREON DESCRIBED ACCORDING TO THE
OFFICIAL RECORDS AND THAT THE PLAT
HEREON IS A CORRECT REPRESENTATION
OF THE LOT LINES TO THE BEST OF MY
KNOWLEDGE AND BELIEF.
SURVEY NOT VALID UNLESS SURVEYOR'S SIGNATURE
IS IN RED.

HAROLD H. KOLB

WISCONSIN REGISTERED LAND SURVEYOR, S-187

DATE DECEMBER 11, 1991

REVISED JANUARY 22, 1992

REVISED APRIL 15, 1992

416-908


HPE-34

KOLB LAND CONSULTING, INC.
LAND SURVEYING • SUBDIVIDING • LAND PLANNING


929 WILLIAMS STREET

LAKE GENEVA, WISCONSIN 53147

414-248-3697

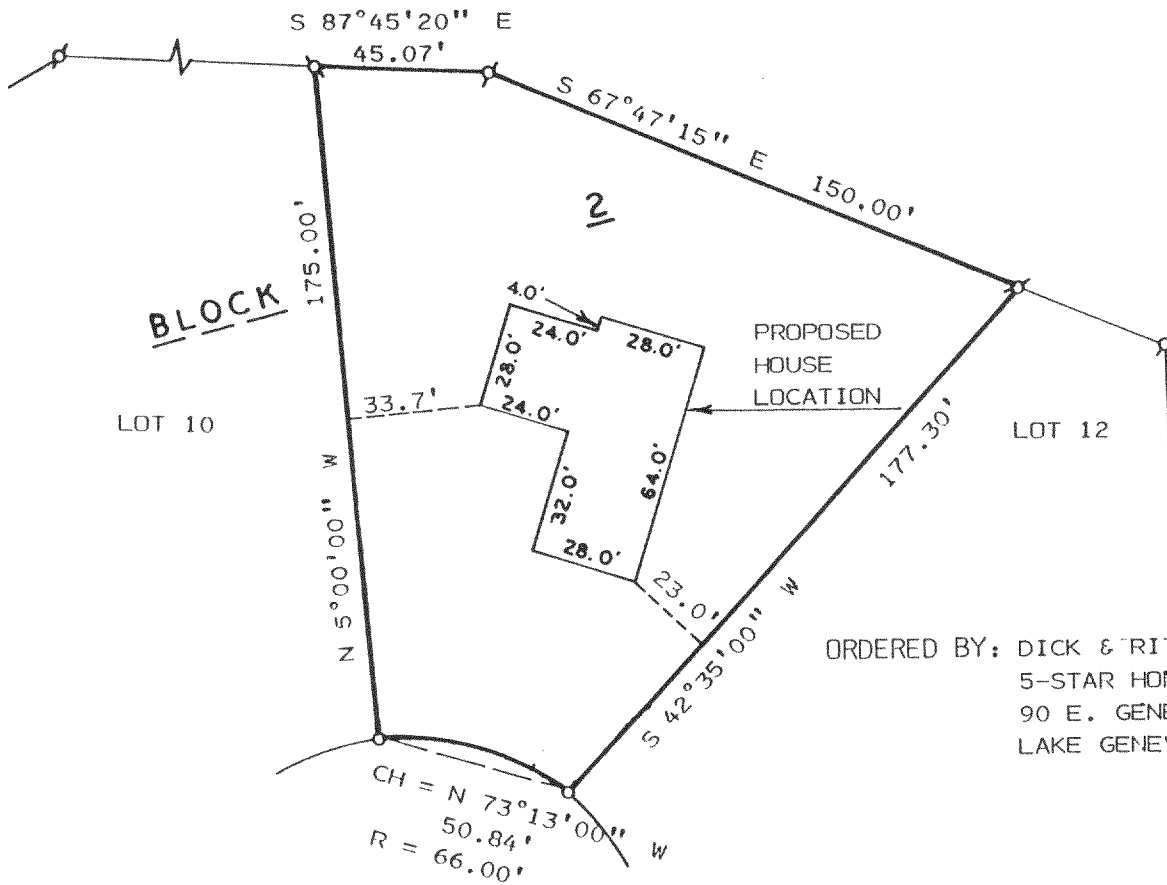

ORDERED BY: DICK & RITA O'DONNELL %
5-STAR HOMES
90 E. GENEVA, SQUARE
LAKE GENEVA, WI. 53147

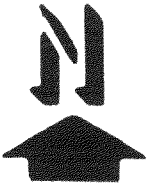


SCALE: 1" = 50'

LEGEND

♣ - IRON PIPE FOUND
o - IRON PIPE SET

PLAT OF SURVEY OF

LOT 11, BLOCK 2 OF PEBBLE BEACH A
SUBDIVISION LOCATED IN SECTIONS 25
AND 26, T4N, R16E, TOWN OF LAGRANGE,
WALWORTH COUNTY, WISCONSIN.

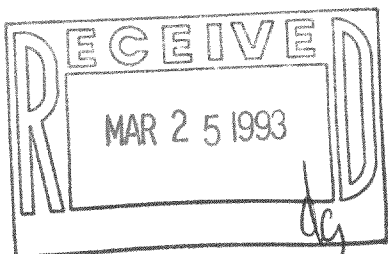

I, HAROLD H. KOLB, DO HEREBY CERTIFY
THAT I HAVE SURVEYED THE PROPERTY
HEREON DESCRIBED ACCORDING TO THE
OFFICIAL RECORDS AND THAT THE PLAT
HEREON IS A CORRECT REPRESENTATION
OF THE LOT LINES TO THE BEST OF MY
KNOWLEDGE AND BELIEF.
SURVEY NOT VALID UNLESS SURVEYOR'S SIGNATURE
IS IN RED.

HAROLD H. KOLB

WISCONSIN REGISTERED LAND SURVEYOR, S-187

DATE DECEMBER 11, 1991

REVISED JANUARY 22, 1992

REVISED

416-908

HPE-34