
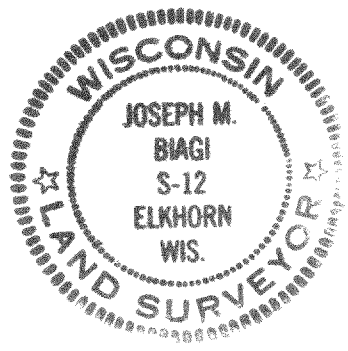


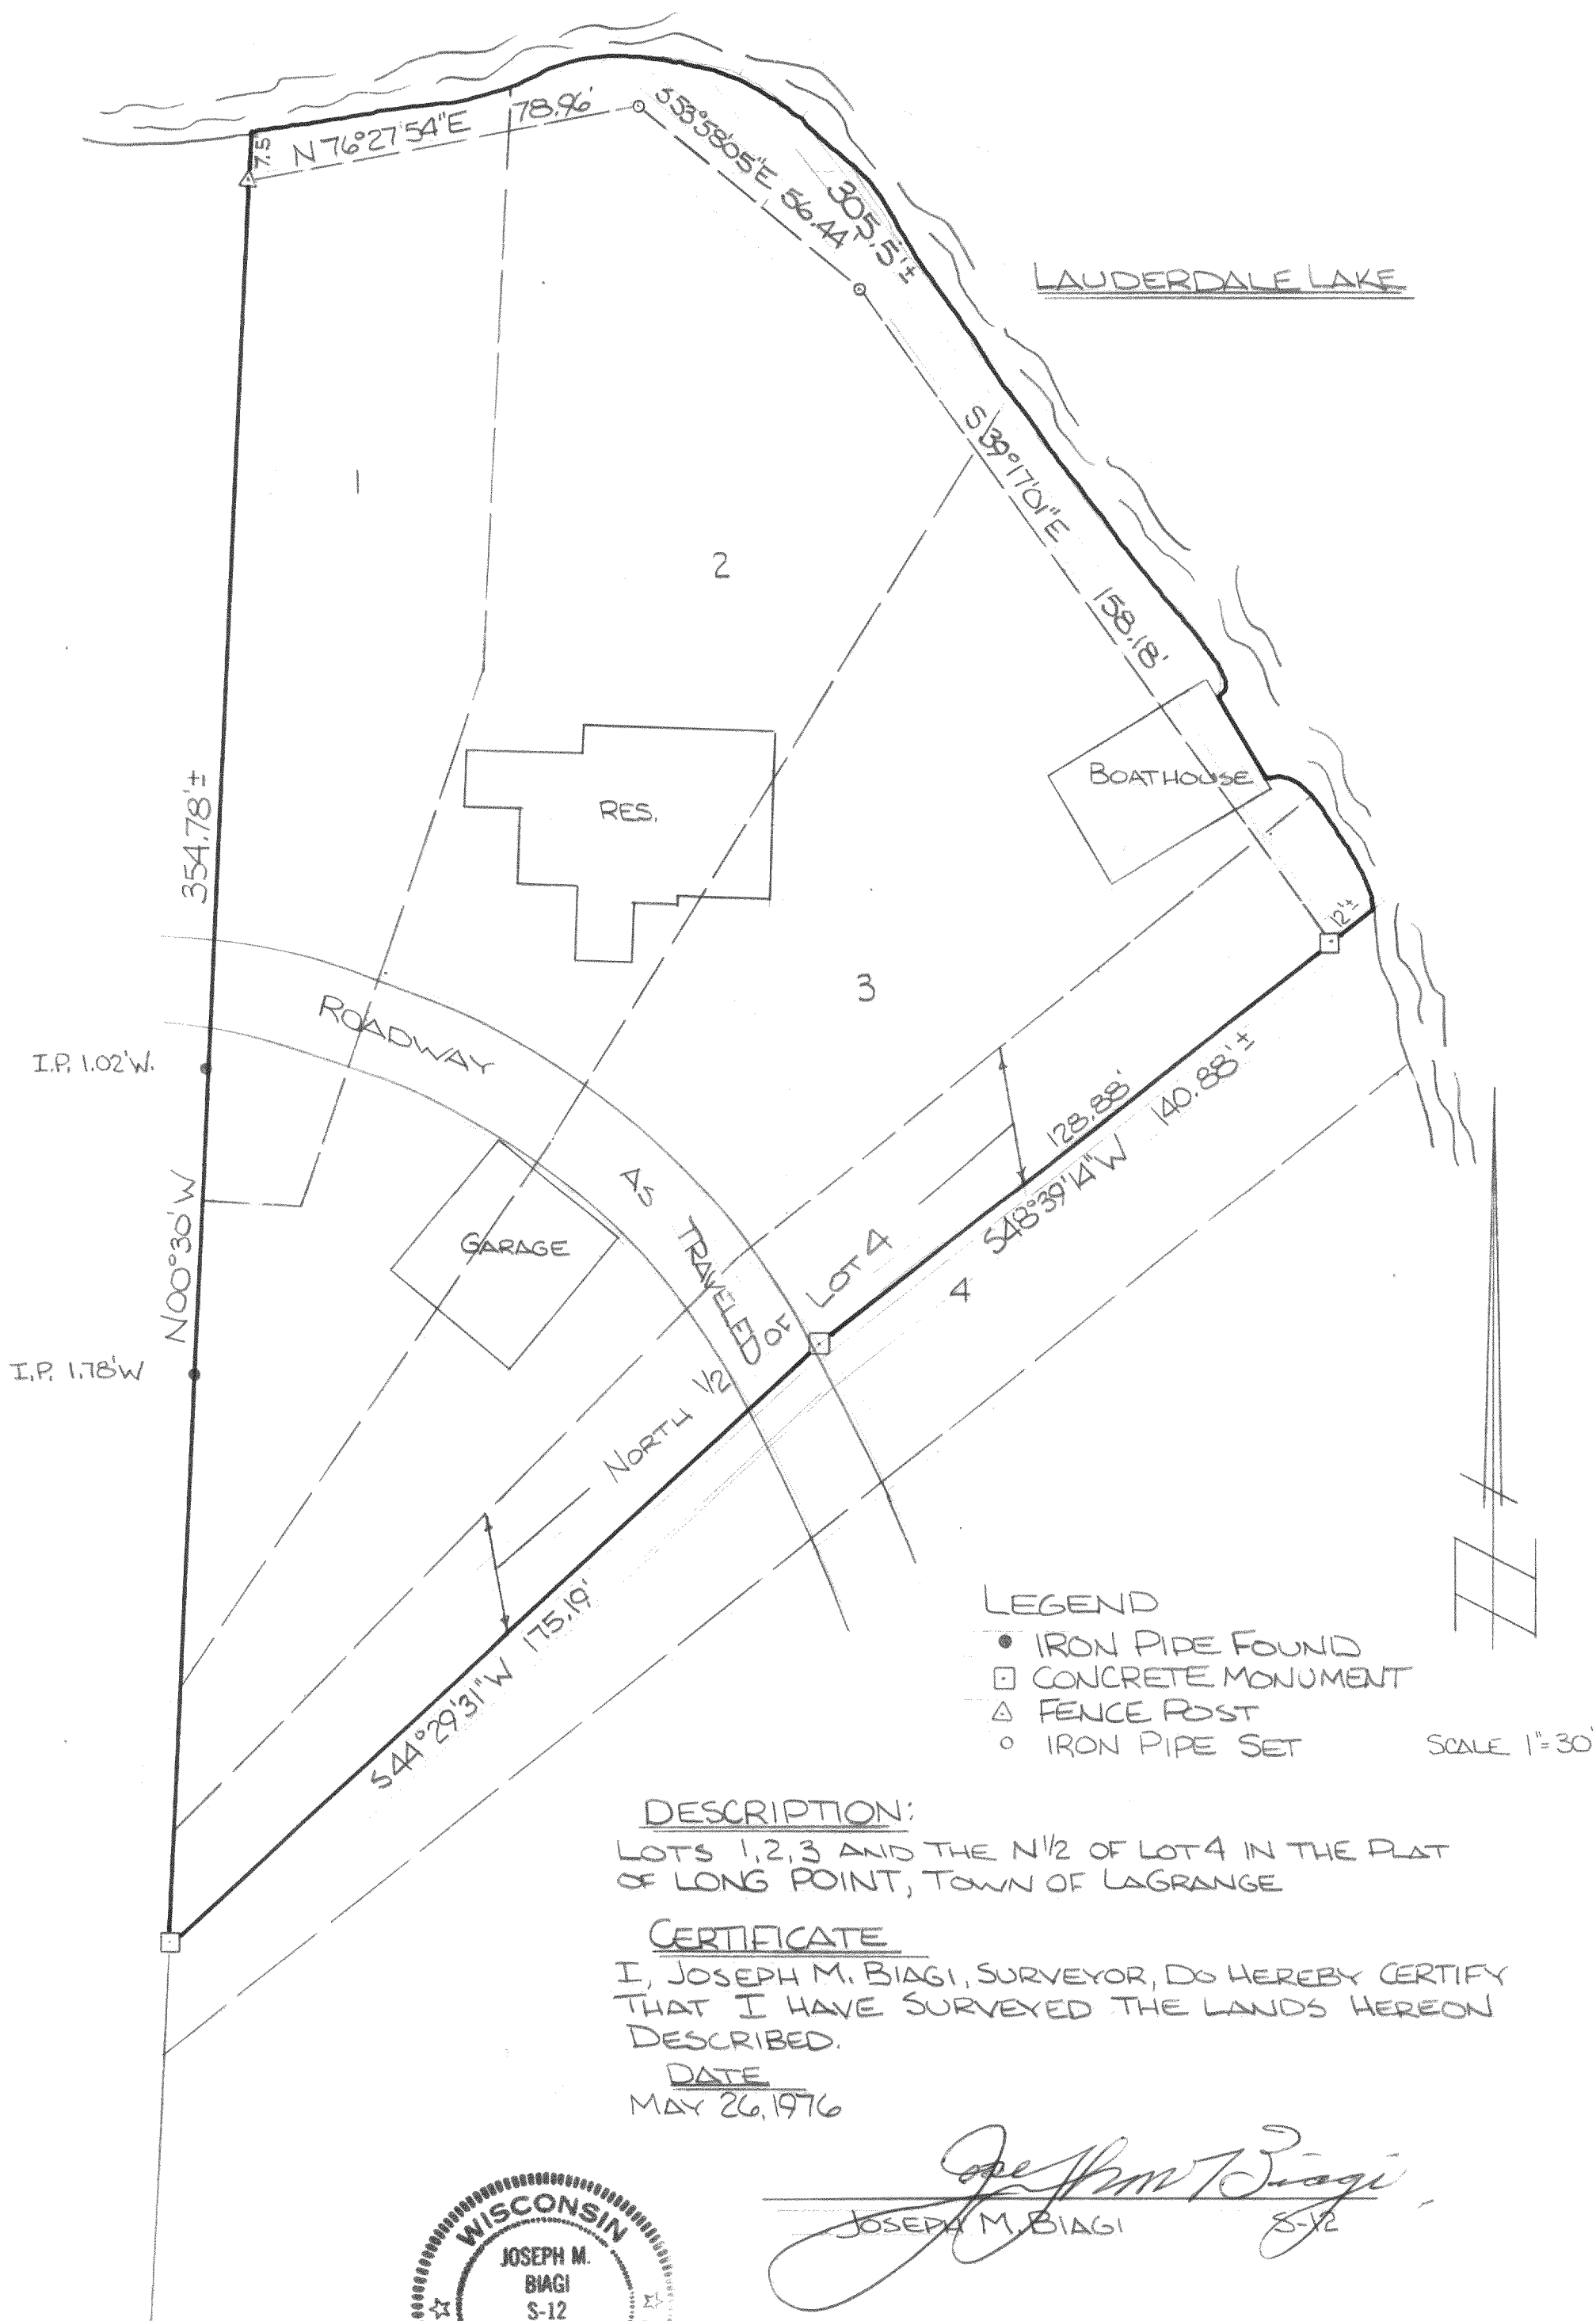

HLPN-1

416-918