
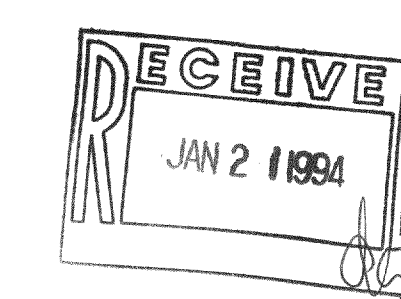


*Lot 8 of Block 3 of Bay View Manor
Subdivision, located in part of the
Northwest 1/4 of Section 36, Town 4 North,
Range 16 East, Town of La Grange, County of
Walworth, State of Wisconsin.*


Owners: Mary Jane Abel
James Rio
Beverly Rio
Route 1, Box 74
Elkhorn, Wisconsin 53121

Ordered by: Peter Olivas
Lakeview Financial Services, Inc.
N7511 Sterlingworth Drive
Elkhorn, Wisconsin 53121-2752

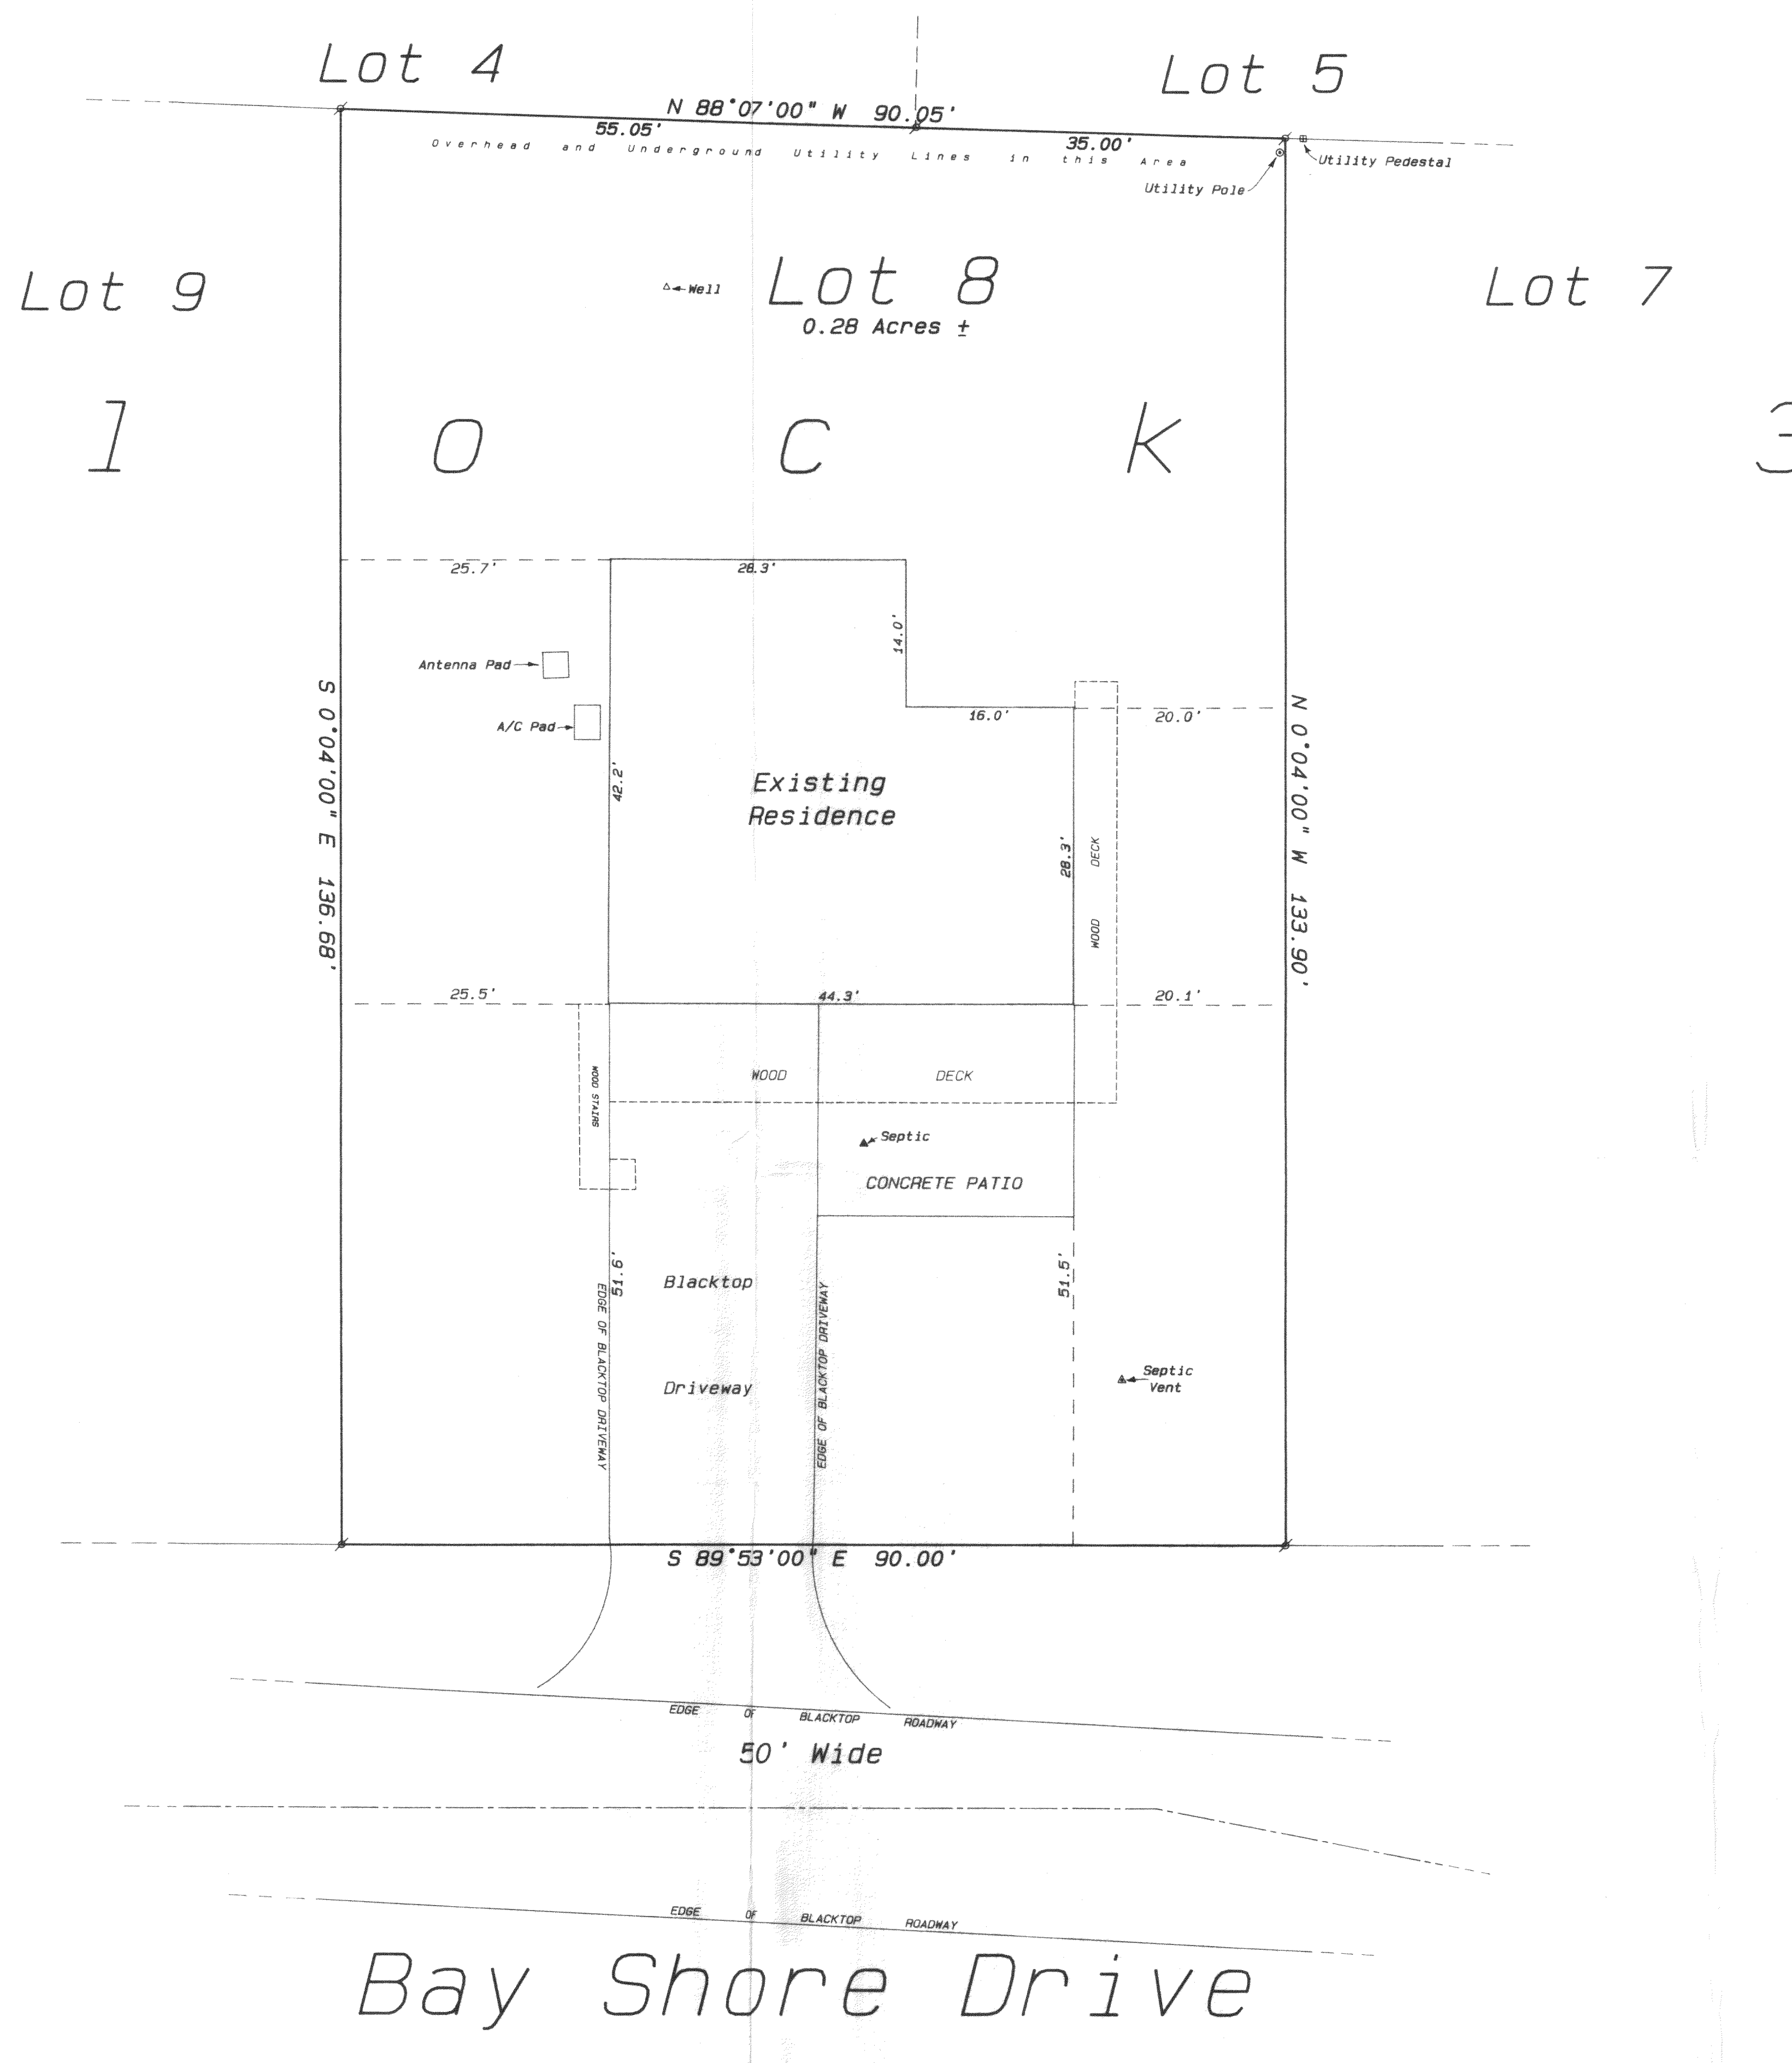

Legend

- 🔍 FOUND IRON PIPE
 - 🔍 FOUND IRON ROD
 - 📏 FOUND BRASS CAPPED MONUMENT
 - 🔍 FOUND CONCRETE MONUMENT
 - ✚ CHISEL CUT IN CONCRETE
 - SET IRON ROD, 24" LONG, WEIGHIN
1.5 LBS./LINEAL FT., 3/16" DIA.
 - SET IRON ROD, 30" LONG, WEIGHIN
4.5 LBS./LINEAL FT., 1-11/16" DIA.
- (xx) RECORDED AS DIMENSION
EXISTING FENCE

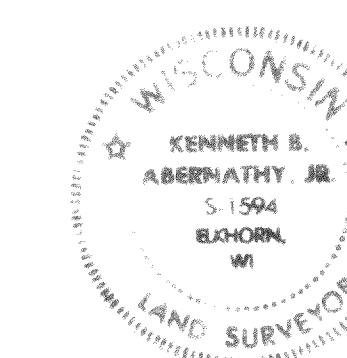

SCALE: 1"= 10 FEET

I hereby certify that the above described property has been surveyed by me or under my direction and that the above map is a true representation thereof and shows the size and location of the property, its exterior boundaries, the location of all visible structures and dimensions of all principal buildings thereon, boundary fences, appurtenant easements, roadways and visible encroachments, if any."

KENNETH B. ABERNATHY, JR.
WISCONSIN REGISTERED LAND SURVEYOR
S-1594

Date: November 30, 1993 Job No. 1993.11