


ABELL
SURVEYING & MAPPING
DELAVAN, WISCONSIN 53115
414-728-6737

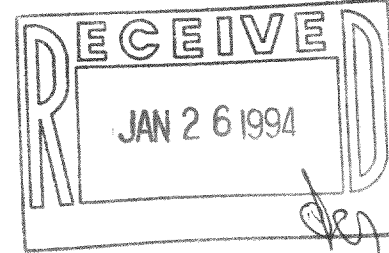

ORDERED BY: CENTURY 21 - WALTON REALTY
202 EAST MAIN STREET
WHITEWATER, WI. 53190

LOT 3

LOT 2

LOT 1

CLOVER LANE

N

SCALE 1"=40'

LEGEND

- - IRON PIPE FOUND
- - UTILITY PEDS.
- CS - CONCRETE STOOP
- * - WIRE FENCE
- () - RECORDED AS

NOTE: BEARINGS ARE REFERENCED TO THE
RECORDED SUBDIVISION PLAT.

S 89°08'50" W 108.48'
(S 89°11'11" W 108.53')

CERTIFIED SURVEY
MAP NO. 736

S 88°25'52" W 266.86'
(S 88°27' W 266.83')

PLAT OF SURVEY OF

LOT 2, CLOVERLEAF ACRES, LOCATED IN
T4N, R16E, WALWORTH COUNTY, WISCONSIN.

I HEREBY CERTIFY THAT I HAVE SURVEYED THE ABOVE DESCRIBED PROPERTY AND THAT THE ABOVE MAP IS A TRUE REPRESENTATION THEREOF AND SHOWS THE SIZE AND LOCATION OF THE PROPERTY, ITS EXTERIOR BOUNDARIES, THE LOCATION OF ALL VISIBLE STRUCTURES AND DIMENSIONS OF ALL PRINCIPAL BUILDINGS THEREON, BOUNDARY FENCES, APPARENT EASEMENTS, ROADWAYS AND VISIBLE ENCROACHMENTS, IF ANY, TO THE BEST OF MY KNOWLEDGE AND BELIEF.

THIS SURVEY IS MADE FOR THE USE OF THE PRESENT OWNERS OF THE PROPERTY, AND ALSO THOSE WHO PURCHASE, MORTGAGE, OR GUARANTEE THE TITLE THERETO WITHIN ONE (1) YEAR FROM DATE HEREON.

David F. Abell

DAVID F. ABELL
WISCONSIN REGISTERED LAND SURVEYOR, S-1596

October 25, 1993

DATE JOB NUMBER - 93252
NOTE: THIS IS NOT A CERTIFIED COPY UNLESS SEALED.