


ABELL
SURVEYING & MAPPING
DELAVAL, WISCONSIN 53115
414-728-6737

SHEET 1 OF 2 SHEETS

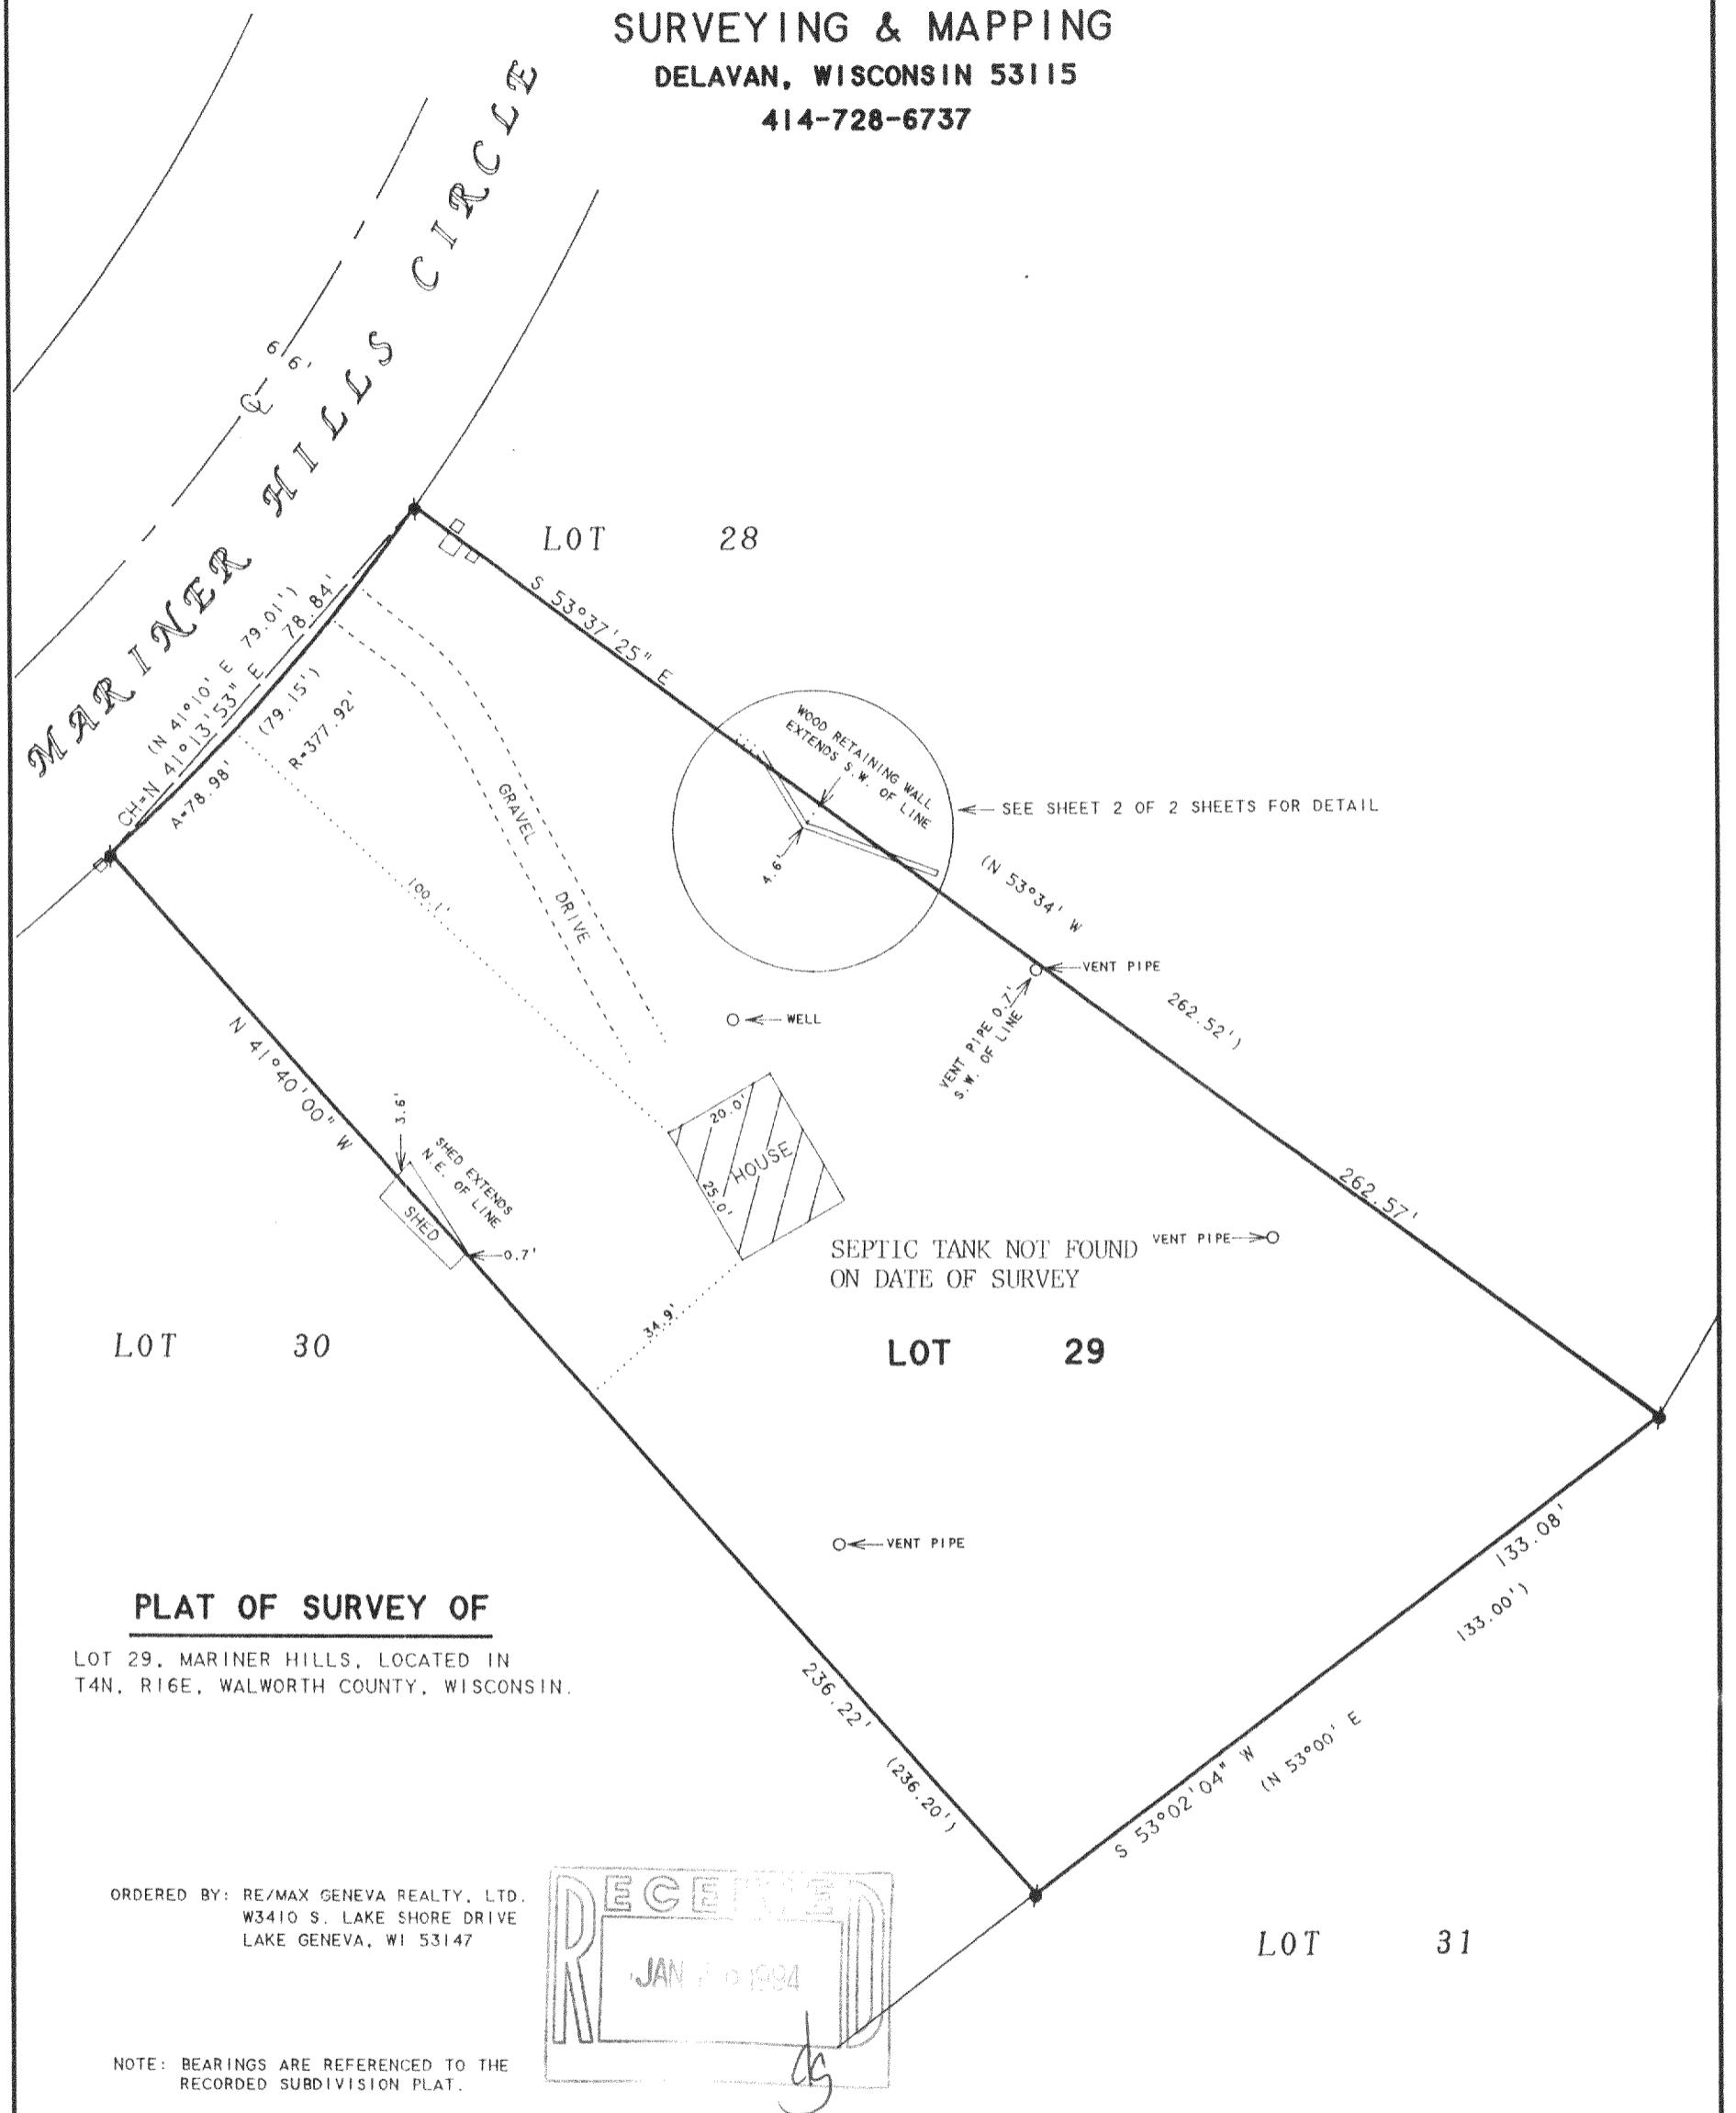

PLAT OF SURVEY OF

LOT 29. MARINER HILLS, LOCATED IN
T4N. R16E, WALWORTH COUNTY, WISCONSIN.

ORDERED BY: RE/MAX GENEVA REALTY, LTD.
W3410 S. LAKE SHORE DRIVE
LAKE GENEVA, WI 53147

NOTE: BEARINGS ARE REFERENCED TO THE
RECORDED SUBDIVISION PLAT.

I HEREBY CERTIFY THAT I HAVE SURVEYED THE ABOVE DESCRIBED PROPERTY AND THAT THE ABOVE MAP IS A TRUE REPRESENTATION THEREOF AND SHOWS THE SIZE AND LOCATION OF THE PROPERTY, ITS EXTERIOR BOUNDARIES, THE LOCATION OF ALL VISIBLE STRUCTURES AND DIMENSIONS OF ALL PRINCIPAL BUILDINGS THEREON, BOUNDARY FENCES, APPARENT EASEMENTS, ROADWAYS AND VISIBLE ENCROACHMENTS, IF ANY, TO THE BEST OF MY KNOWLEDGE AND BELIEF.

THIS SURVEY IS MADE FOR THE USE OF THE PRESENT OWNERS OF THE PROPERTY, AND ALSO THOSE WHO PURCHASE, MORTGAGE, OR GUARANTEE THE TITLE THERETO WITHIN ONE (1) YEAR FROM DATE HEREON.

FROM DATE HEREON.
David F. Abell

DAVID F. ABELL
WISCONSIN REGISTERED LAND SURVEYOR, S-1596

SCALE 1"=30'

SCALE 1" = 30'

█ - IRON ROD FOUND
□□ - UTILITY PEDS
() - RECORDED AS

LEGEND



January 6, 1994 REVISED: 1/7/94
DATE JOB NUMBER - 93290
NOTE: THIS IS NOT A CERTIFIED COPY UNLESS SEALED.

HMH-29

416-988

ABELL
SURVEYING & MAPPING
DELAVAL, WISCONSIN 53115
414-728-6737

SHEET 2 OF 2 SHEETS

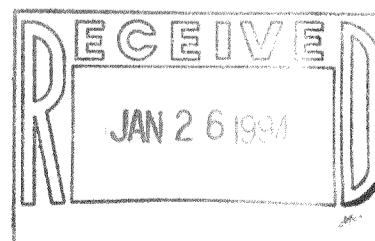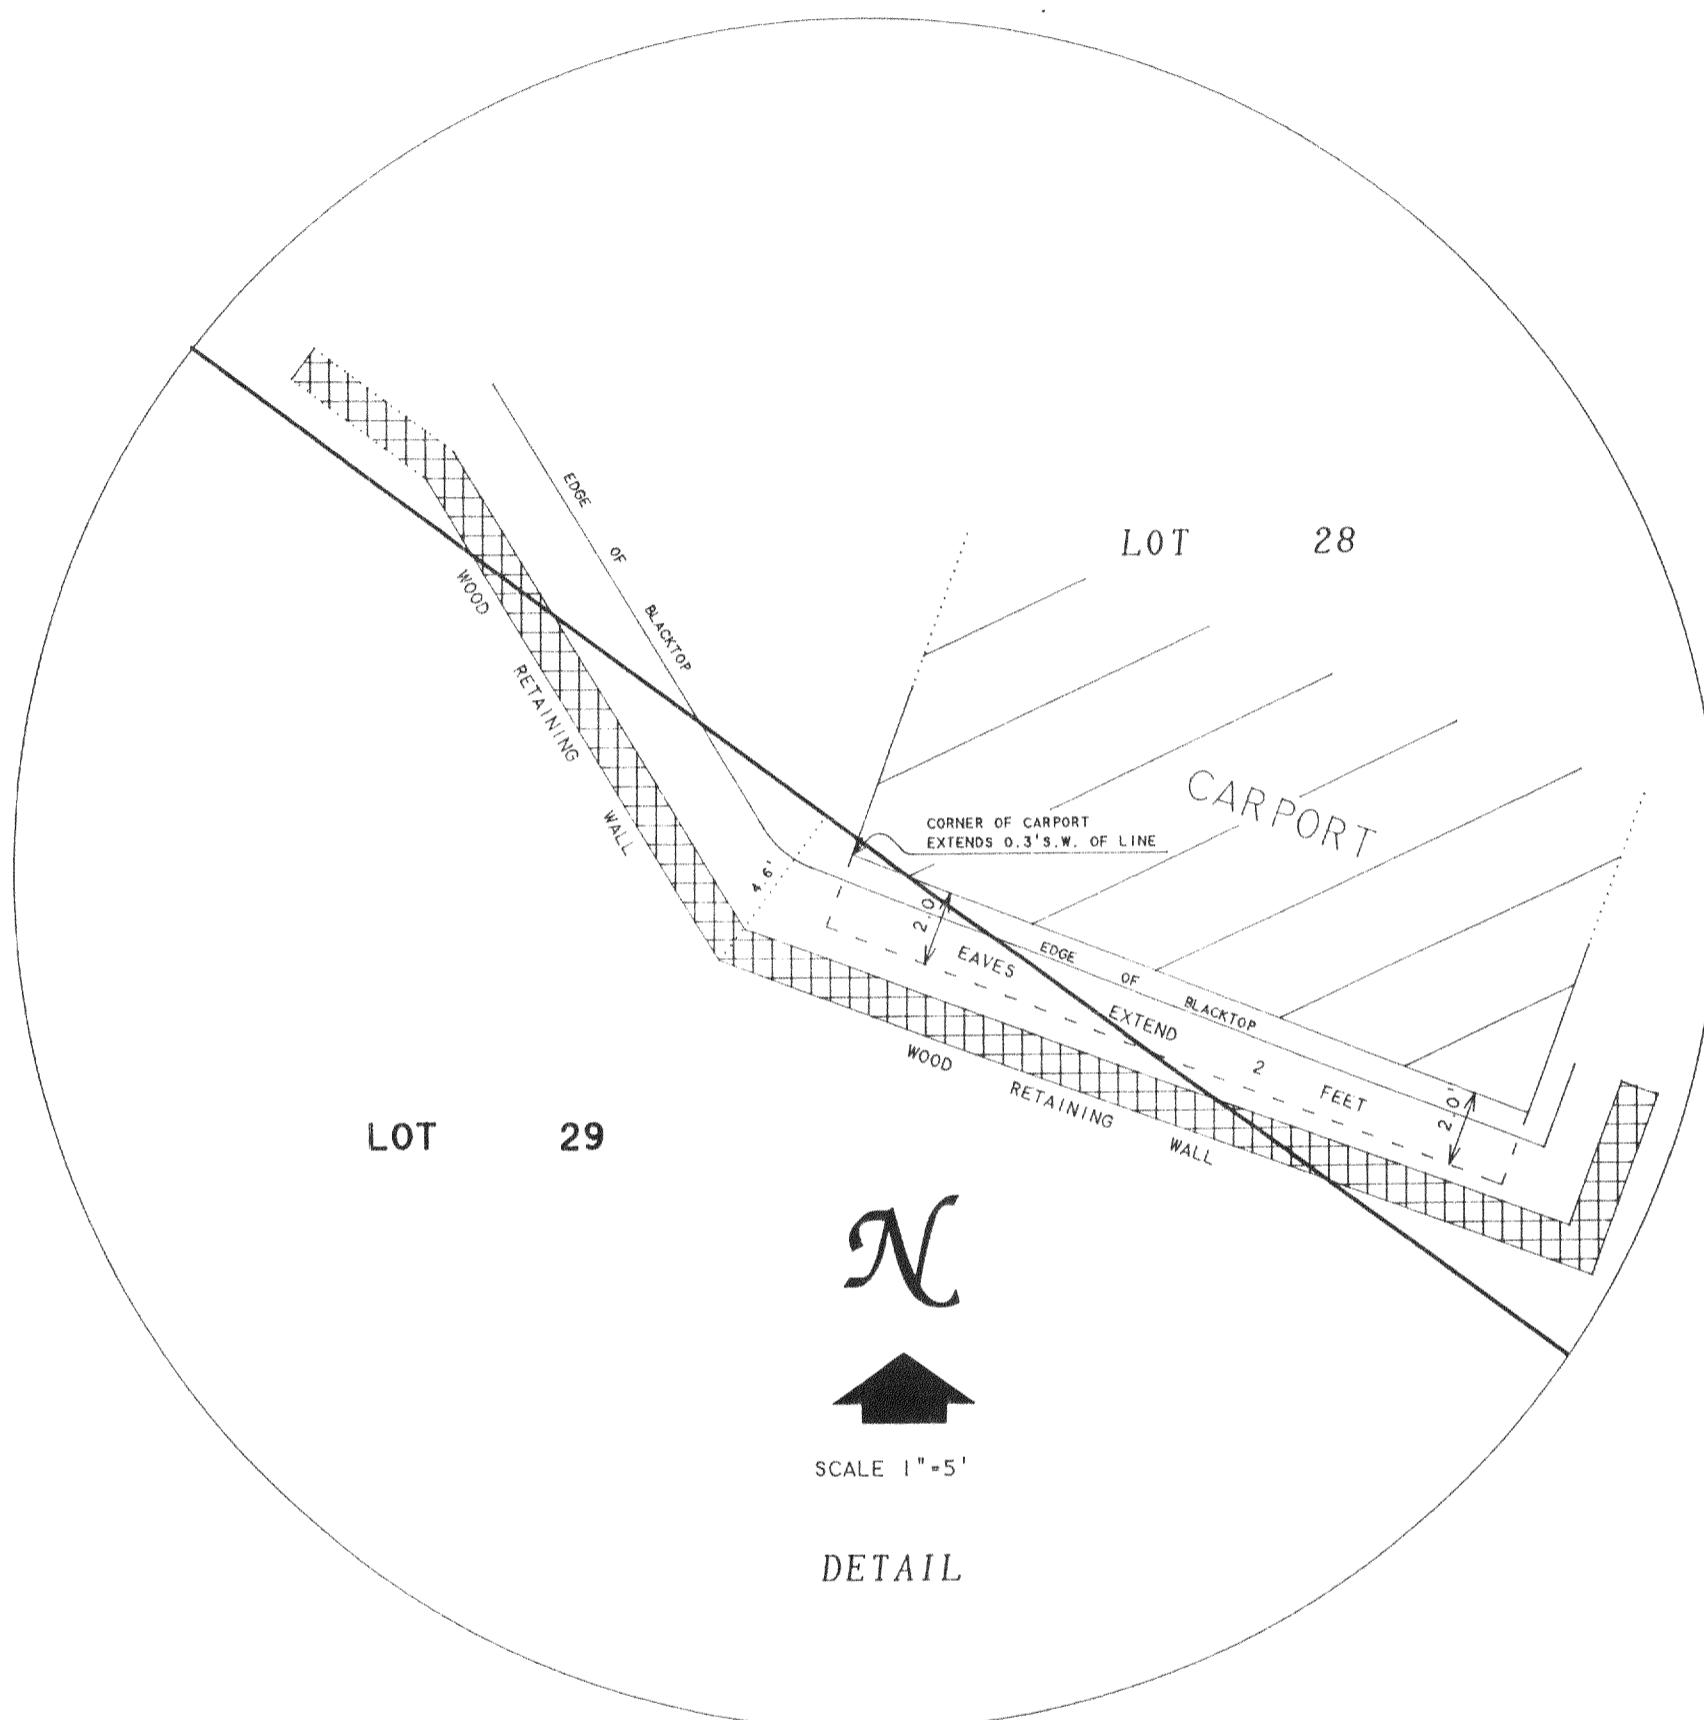



David F. Abell

DAVID F. ABELL
WISCONSIN REGISTERED LAND SURVEYOR, S-1596

January 6, 1994 REVISED: 1/7/94
DATE: JAN 26 1994 JOB NUMBER - 93290
NOTE: THIS IS NOT A CERTIFIED COPY UNLESS SEALED.

ABELL
SURVEYING & MAPPING
DELAVAL, WISCONSIN 53115
414-728-6737

SHEET 2 OF 2 SHEETS

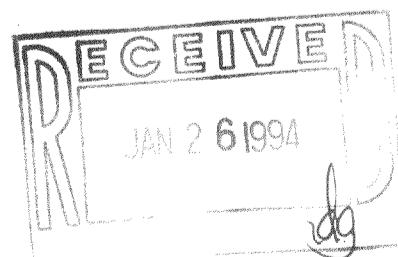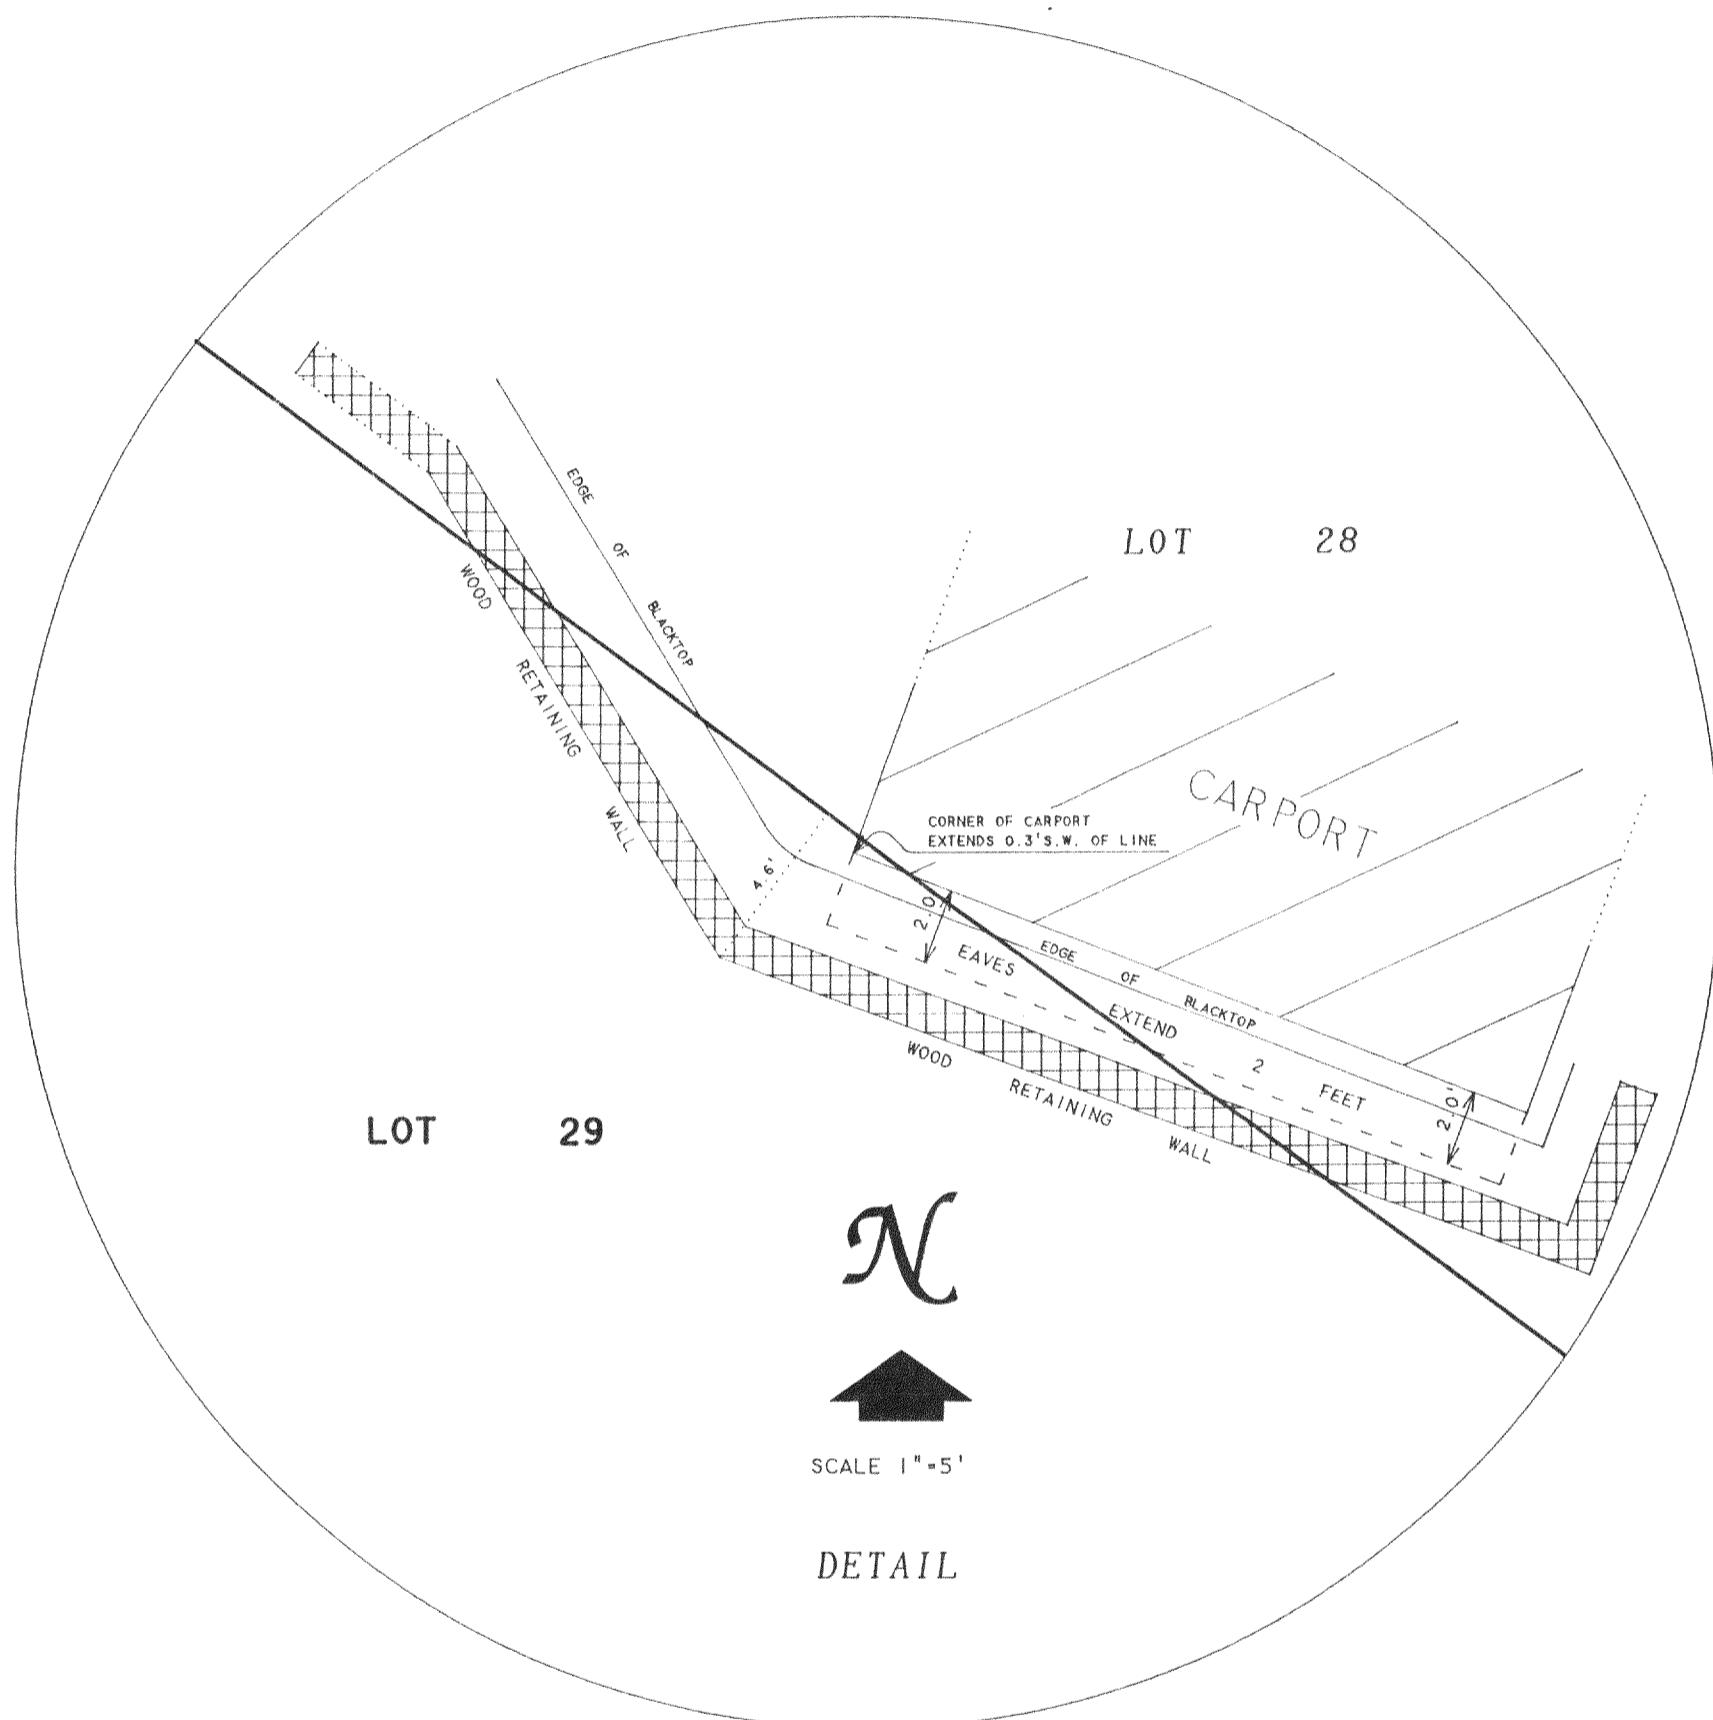

David F. Abell

DAVID F. ABELL
WISCONSIN REGISTERED LAND SURVEYOR, S-1596

January 6, 1994

DATE JOB NUMBER - 93290
NOTE: THIS IS NOT A CERTIFIED COPY UNLESS SEALED.