
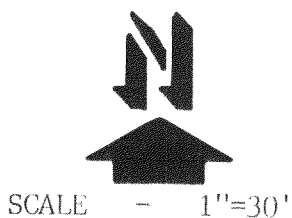


ABELL
SURVEYING & MAPPING
DELAVER, WISCONSIN 53115
414-728-6737

PLAT OF SURVEY OF

LOT 21, BUBBLING SPRINGS SUBDIVISION,
LOCATED IN SECTION 34, T4N, R16E,
WALWORTH COUNTY, WISCONSIN.

ORDERED BY: SAL LAURIE
1323 SEVEN PINES
SHAMBURG, IL. 60193

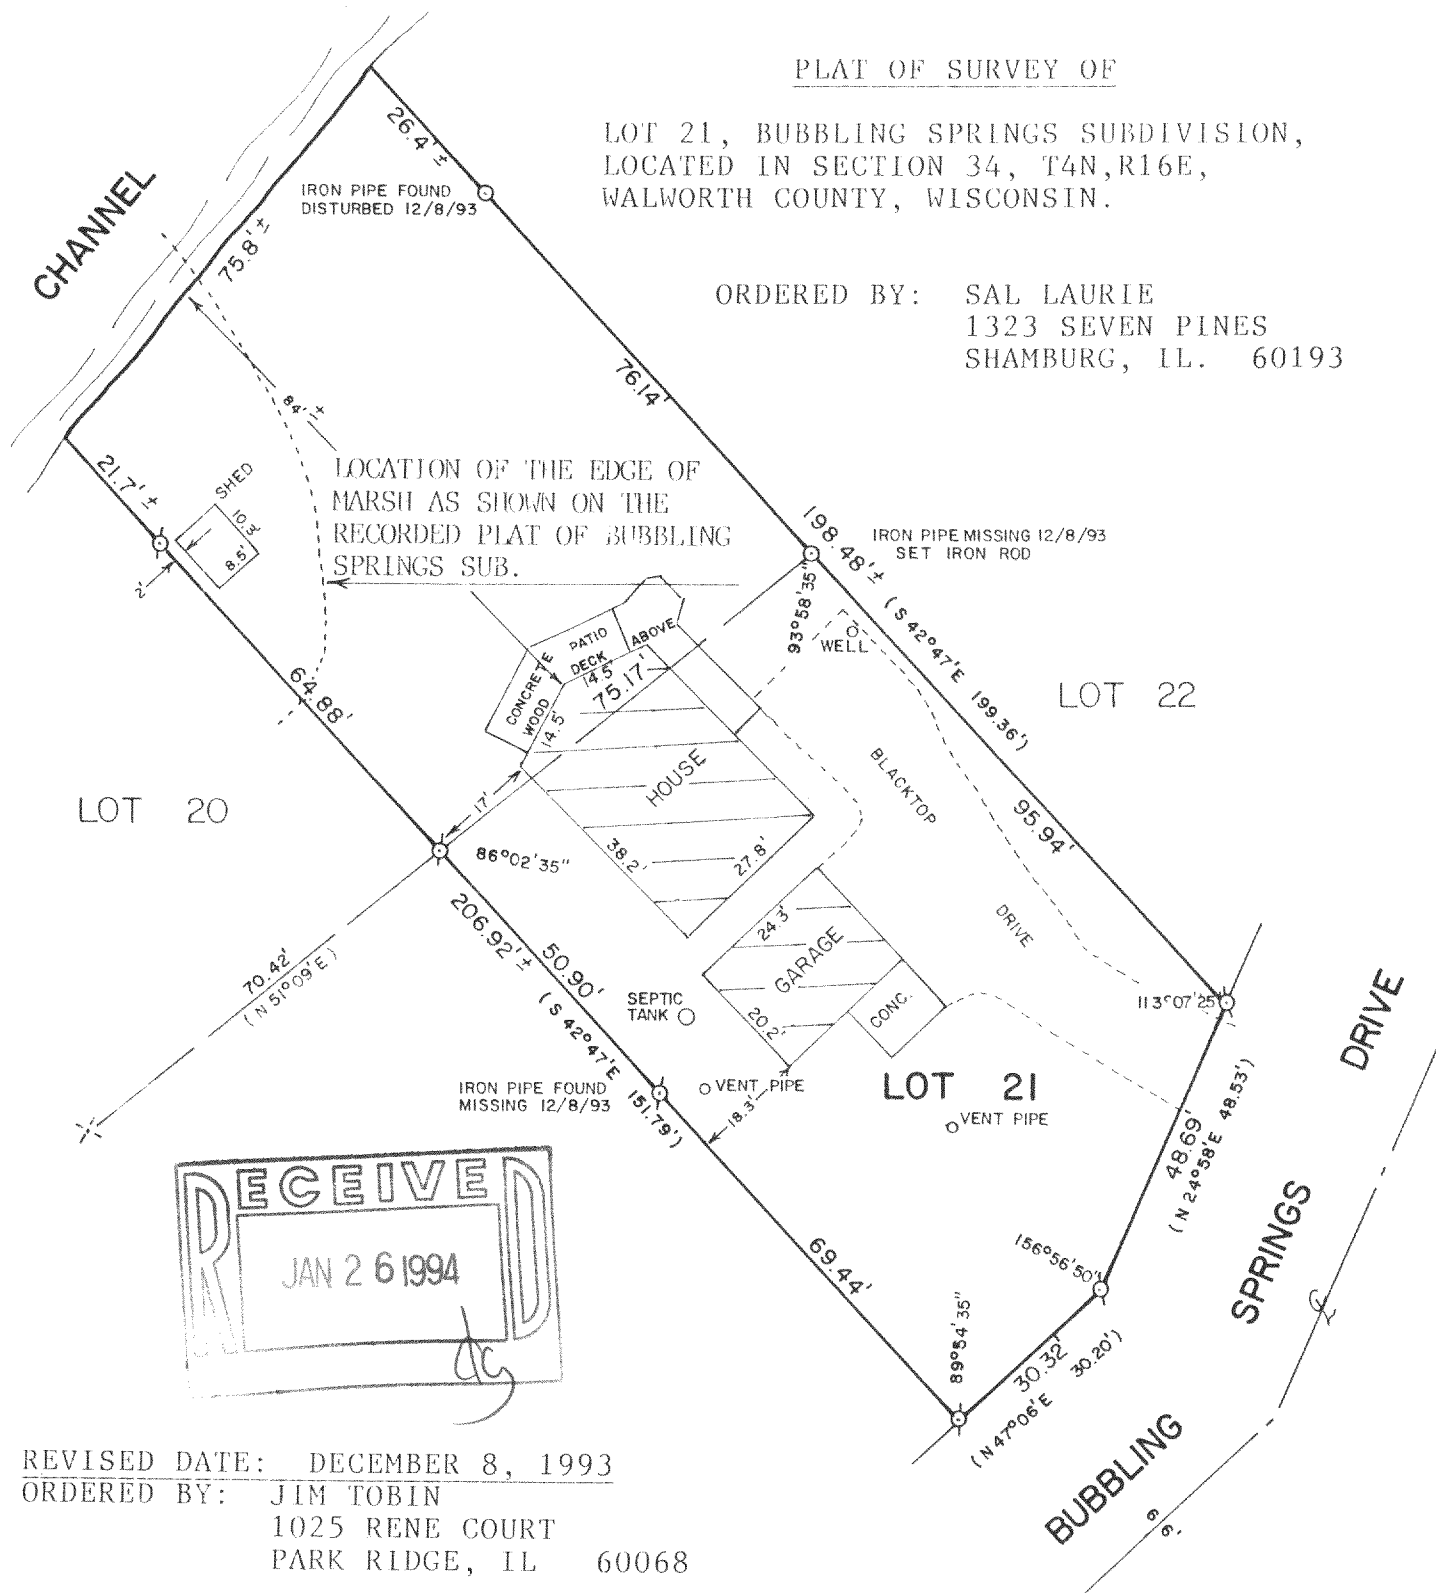

- LEGEND
- ⊗ - IRON PIPE FOUND
 - - IRON PIPE SET
 - × - NAIL FOUND
 - () - RECORDED AS

I, DAVID F. ABELL, DO HEREBY CERTIFY
THAT I HAVE SURVEYED THE PROPERTY
HEREON DESCRIBED ACCORDING TO THE
OFFICIAL RECORDS AND THAT THE PLAT
HEREON IS A CORRECT REPRESENTATION
OF THE PROPERTY LINES TO THE BEST OF
MY KNOWLEDGE AND BELIEF.

David F. Abell
DAVID F. ABELL
WISCONSIN REGISTERED LAND SURVEYOR, S-1596

December 21, 1988
DATE JOB NUMBER -88288

NOTE: THIS IS NOT A CERTIFIED COPY UNLESS SEALED.