


PLAT OF SURVEY **-OF-**

LOT 18, BOOTH LAKE HEIGHTS SUBDIVISION
LOCATED IN PART OF THE SECTIONS 13 AND
24, TOWN 4 NORTH, RANGE 17 EAST, TOWN-
SHIP OF TROY, WALWORTH COUNTY, WISCONSIN.

SURVEY FOR: REALTY EXECUTIVES
SURVEY LOCATION: N8586 BOOTH LAKE HEIGHTS RD.

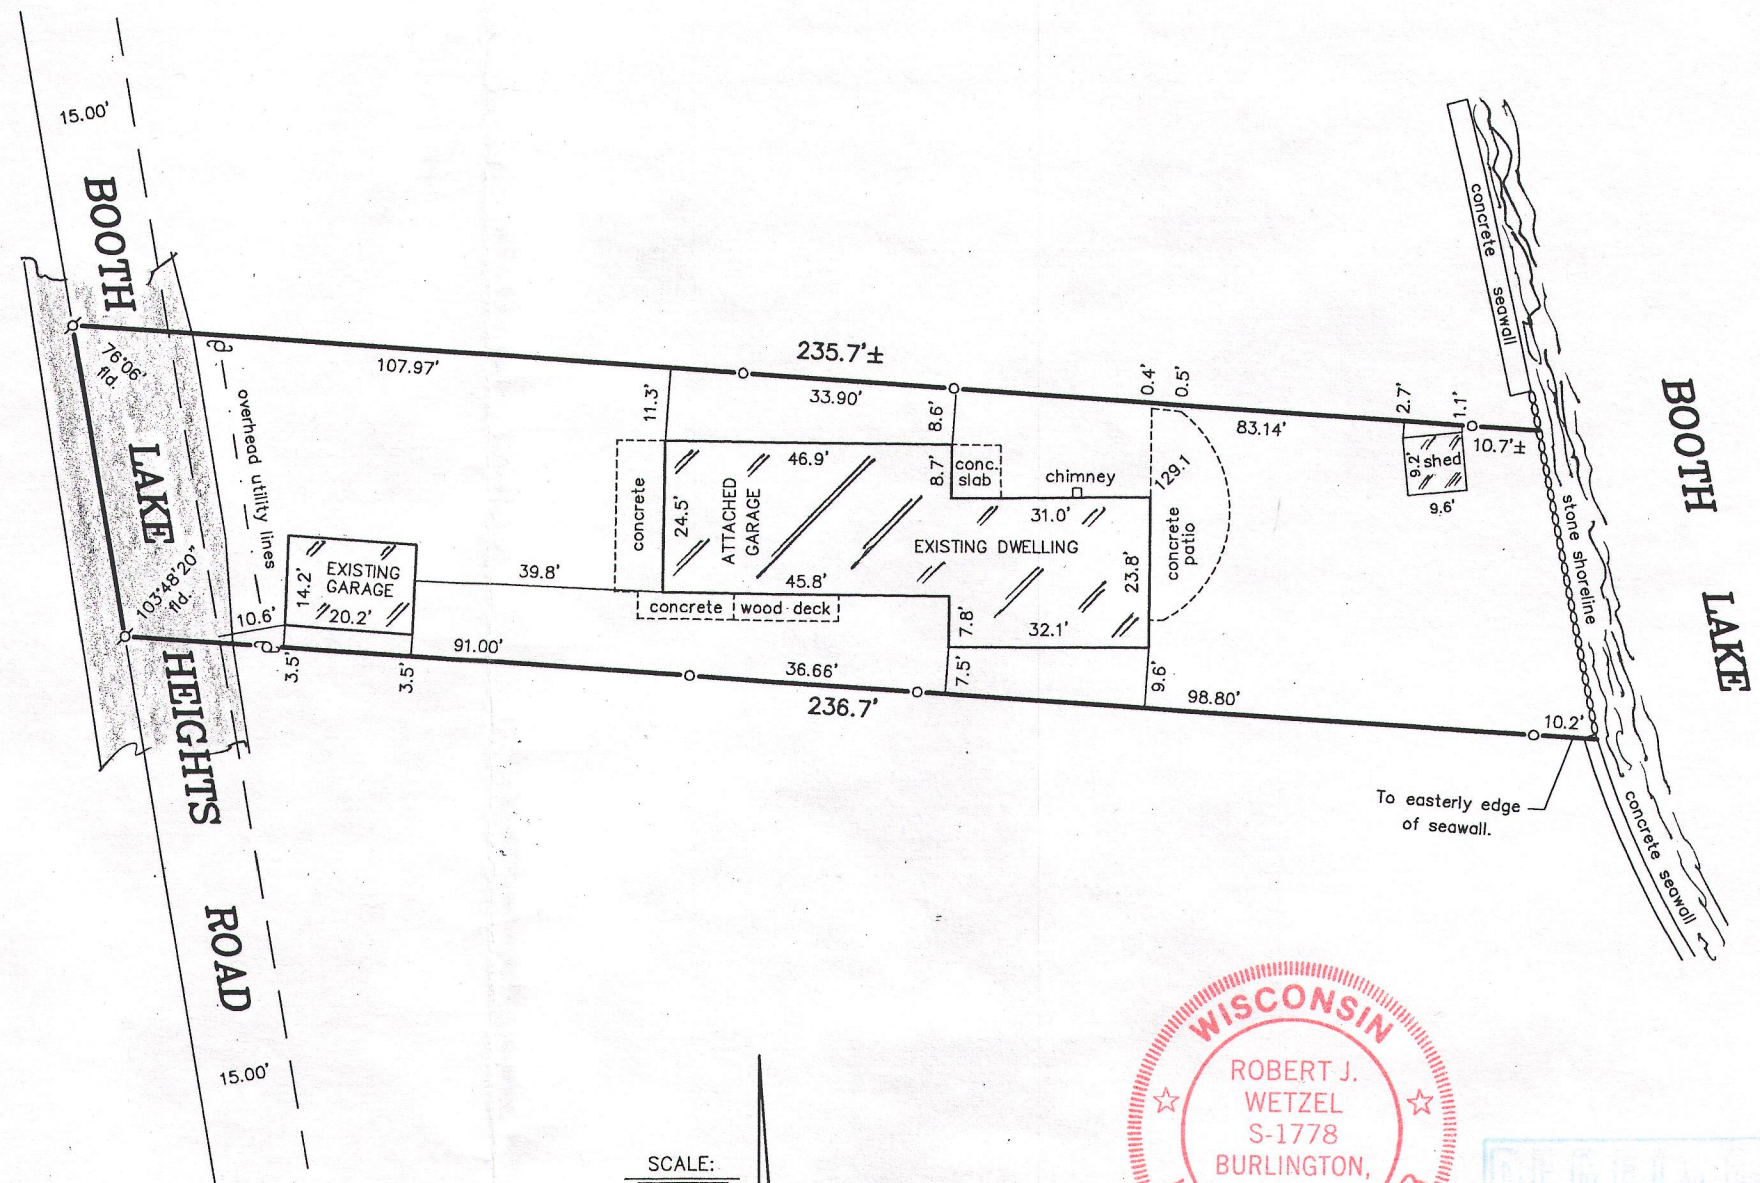



"I hereby certify that I have surveyed the above described property and that the above map is a correct representation thereof and shows the size and location of the property, its exterior boundaries, the location of all visible structures and dimensions of all principal buildings thereon, boundary fences, apparent easements, roadways and encroachments, if any."

"This survey is made for the use of the present owners of the property, and those who purchase, mortgage, or guarantee the title thereto within one year from date hereof."

SCALE: 1" = 30'

LEGEND

- ⊕ FOUND MASONRY NAIL
- FOUND IRON PIPE
- ⊙ UTILITY POLE

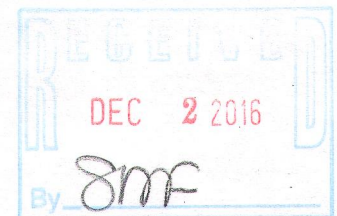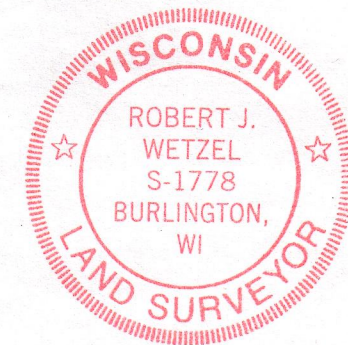


THIS IS NOT AN ORIGINAL PRINT
UNLESS THIS SEAL IS RED.

Robert J. Wetzel
ROBERT J. WETZEL S-1778

JUNE 29, 2016
DATE

9156
JOB NUMBER

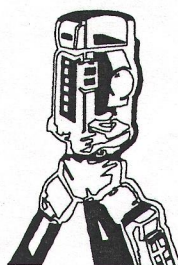

B.W. SURVEYING, INC.

LAND SURVEYS
MAPPING AND PLANNING
412 N. PINE STREET
BURLINGTON, WI 53105
(262)-767-0225

LBL-16

417-1031