

FARRIS, HANSEN & ASSOCIATES, INC.
ENGINEERING — ARCHITECTURE — SURVEYING
7 RIDGWAY COURT P.O. BOX 437
ELKHORN, WISCONSIN 53121
OFFICE (408) 767-0900 FAX (408) 767-5886

REVISIONS
08/23/17-SB ORIGINAL DRAFT
01/22/2018 - LB AS BUILT

PROJECT NO. 9708
DATE 08/22/17
SHEET NO. 1 OF 1


PART OF THE SW 1/4 OF THE NE 1/4 OF
SECTION 19, TOWN 4 NORTH, RANGE 17 EAST,
WALWORTH COUNTY, WISCONSIN

LOT 2
C.S.M. 183

ZIMMERMAN ROAD
{66' WIDE R.O.W.}

AS BUILT
RESIDENCE

STATE TRUNK HIGHWAY "20"
{VARIABLE WIDTH R.O.W.}

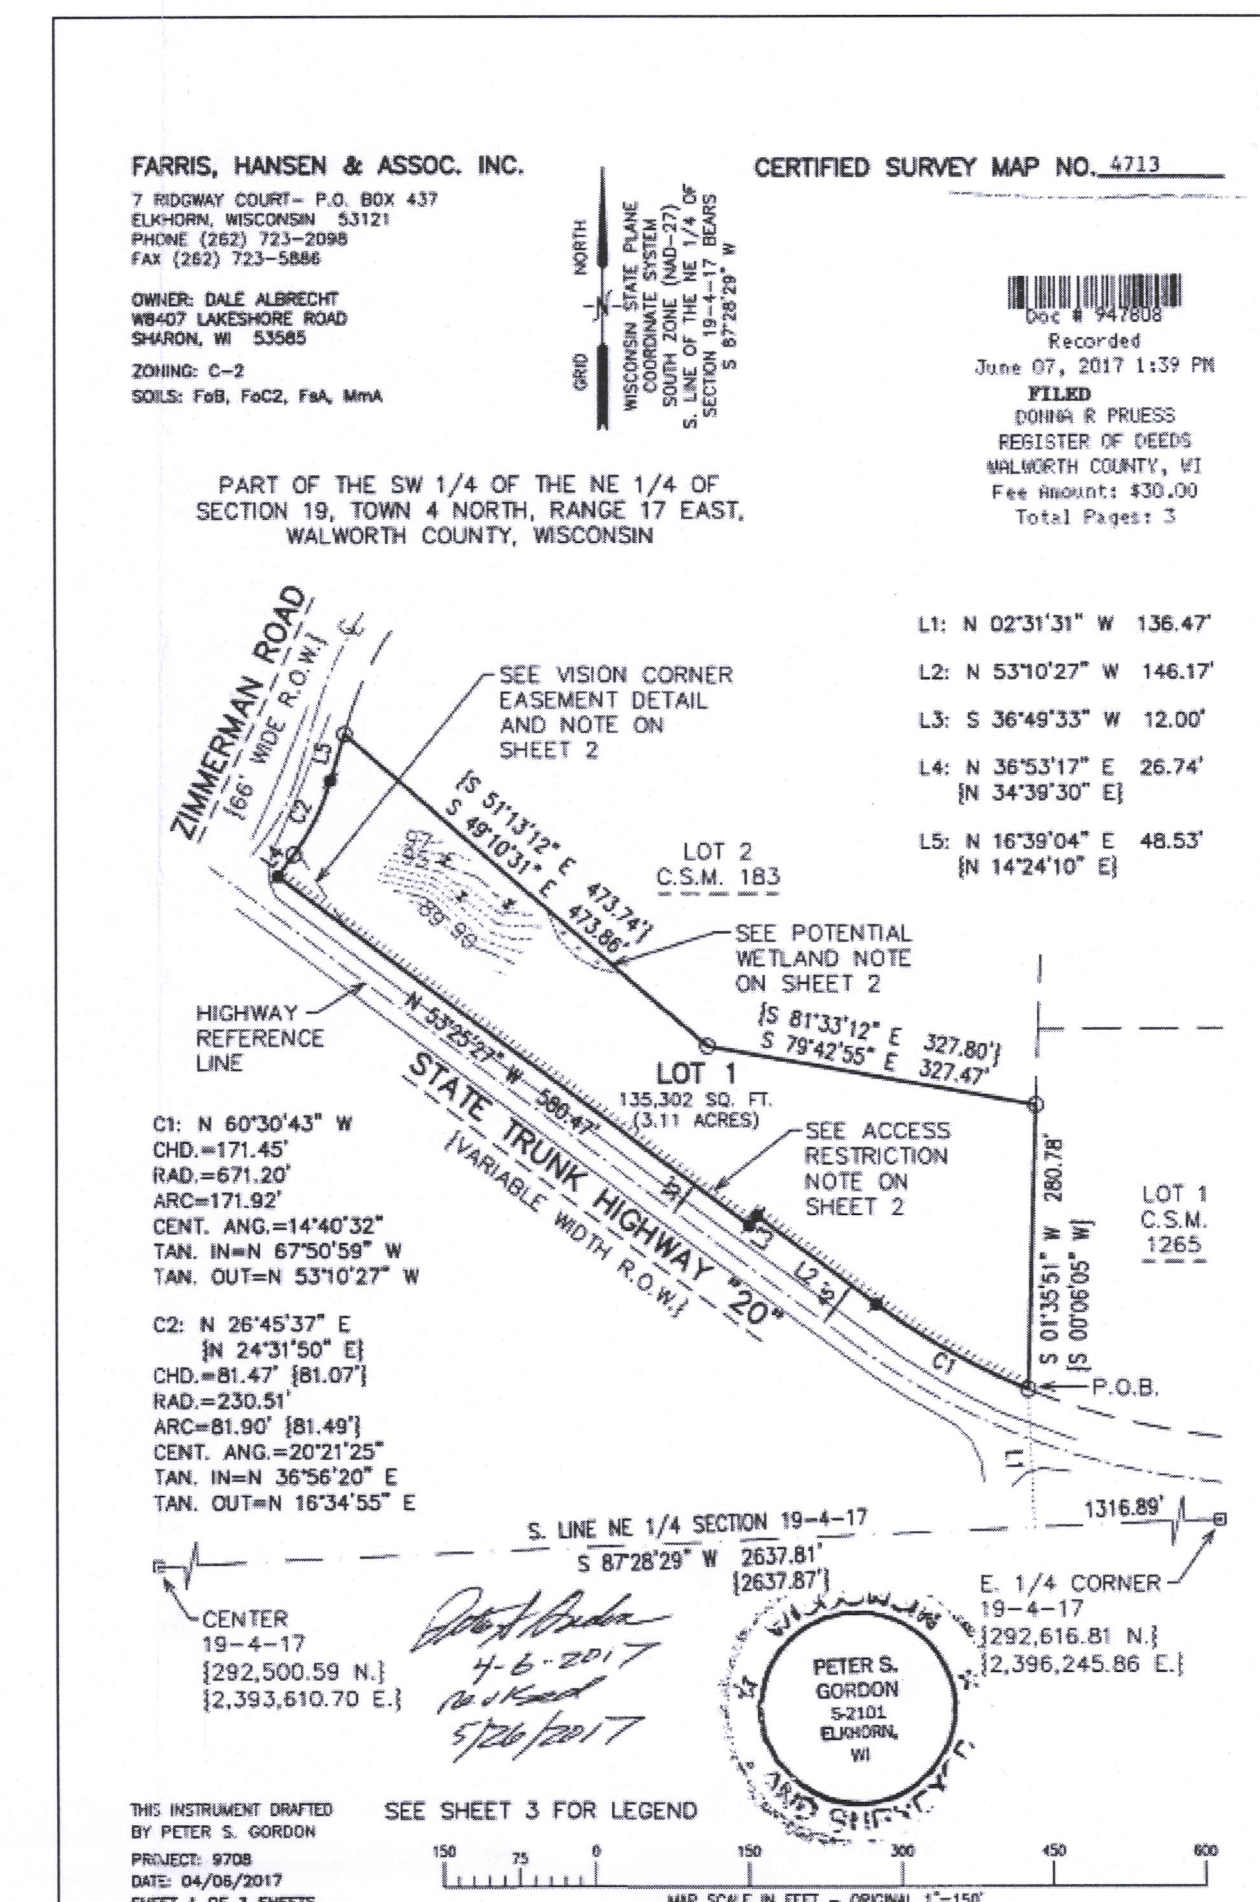

LEGEND

○ = FOUND IRON PIPE STAKE, 1 3/8" O.D.

■ = FOUND CONCRETE COUNTY MONUMENT WITH BRASS CAP

✦ = SET IRON REBAR STAKE, 3/4" x 18" x 1.13 lbs./ft.

◆ = SOIL TEST BORING LOCATED

—X—X— = TOPOGRAPHIC CONTOURS

{XXX} = RECORDED AS

NOTE: COPIES OF THIS MAP TO WHICH THE FOLLOWING CERTIFICATE WILL APPLY SHOW THE SURVEYOR'S ORIGINAL SEAL AND SIGNATURE IN RED INK. COPIES BY ANY OTHER MEANS MAY HAVE ALTERATIONS WHICH DO NOT REPRESENT THE SURVEYOR'S WORK PRODUCT.

I HEREBY CERTIFY THAT THE ABOVE DESCRIBED PROPERTY HAS BEEN SURVEYED UNDER MY DIRECTION AND THAT THE ABOVE MAP IS A TRUE REPRESENTATION THEREOF AND SHOWS THE SIZE AND LOCATION OF THE PROPERTY AND ITS EXTERIOR BOUNDARIES. THIS SURVEY IS MADE FOR THE USE OF THE PRESENT OWNERS OF THE PROPERTY, AND ALSO THOSE WHO PURCHASE, MORTGAGE, OR GUARANTEE THE TITLE THERETO WITHIN ONE YEAR FROM THE DATE HEREOF.

DATED: 01/22/2018

BRIAN M. CARLSON P.L.S. 2039

LA4713-1

417-1060

MAP SCALE IN FEET - ORIGINAL 1"=20'

K:\Projects\9708\ACAD\9708.DWG