


**Wisconsin Professional Land Surveyor S-2582**

**N9330 Knuteson Drive  
Whitewater, WI 53190  
Phone:(262)495-3284  
MARKMIRITZ@  
LAND-MARKSURVEYING.COM**


# PLAT OF SURVEY

**LOT 1 OF CERTIFIED SURVEY MAP NO. 3722, LOCATED  
IN THE SOUTHEAST 1/4 OF THE NORTHWEST 1/4 OF  
SECTION 4, TOWN 4 NORTH, RANGE 17 EAST, TOWN  
OF TROY, WALWORTH COUNTY, WISCONSIN.**

**SCALE: 1 INCH = 20 FEET**

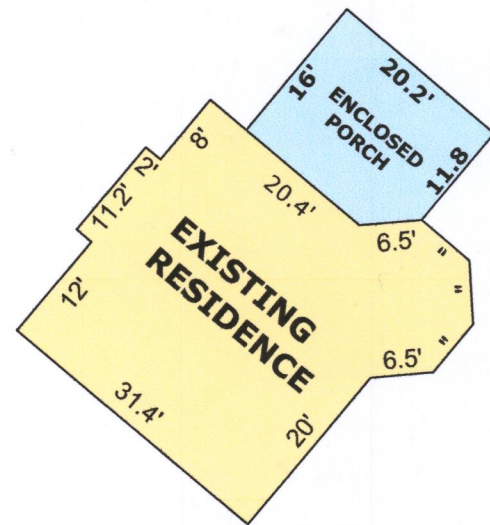

75,214 S.F. ( 1.73 AC.) TOTAL  
62,134 S.F. ( 1.43 AC. ) C-2  
13,080 S.F ( 0.30 AC.) C-4

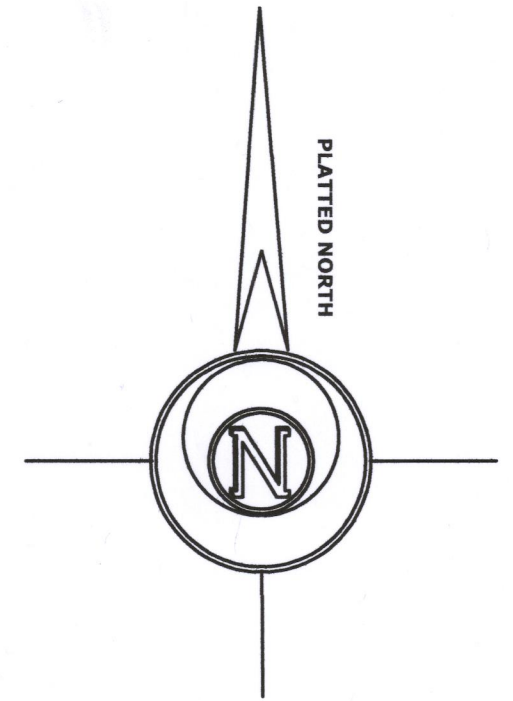

|                                                                                       |                              |
|---------------------------------------------------------------------------------------|------------------------------|
|  | <b>FOUND IRON PIPE</b>       |
|  | <b>FOUND IRON ROD</b>        |
|  | <b>FOUND COUNTY MONUMENT</b> |
| <b>( x x )</b>                                                                        | <b>RECORDED AS DIMENSION</b> |

**SCALE: 1 INCH = 60 FEET**

"I hereby certify that the above described property has been surveyed by me or under my direction and that the above map is a true representation thereof and shows the size and location of the property, its exterior boundaries, the location of all visible structures and dimensions of all principal buildings thereon, boundary fences, apparent easements, roadways and visible encroachments, if any."

"This survey is made for the use of the present owners of the property, and also those who purchase, mortgage, or guarantee the title thereto within one year from date hereof."

*Mark L. Miritz*  
 MARK L. MIRITZ  
 WISCONSIN PROFESSIONAL  
 LAND SURVEYOR S-2582

DATE: OCT. 12, 2005      JOB NO. 02.1202

REVISED JUNE 30, 2018 TO  
SHOW PROPOSED ADDITION  
REVISED OCT. 10, 2018 TO  
SHOW ENCLOSED PORCH "AS BUILT"

LA3722-1 417-1075

