


# PLAT OF SURVEY

LOT 1 CERTIFIED SURVEY MAP No. 3008, AS RECORDED IN VOLUME 16 ON PAGE 82  
 CERTIFIED SURVEY MAPS, A CERTIFIED SURVEY MAP LOCATED IN GOVERNMENT LOT 1 IN  
 THE NORTHWEST ¼ AND SOUTHWEST ¼ OF THE NORTHEAST ¼ OF SECTION 24, TOWNSHIP 4  
 NORTH, RANGE 17 EAST, TOWN OF EAST TROY, WALWORTH COUNTY, WISCONSIN

**LEGEND:**

(100.00')	RECORDED DISTANCE
100.00'	MEASURED DISTANCE
●	1" FOUND IRON PIPE, UNLESS NOTED
⊗	¾" x 18" IRON PIPE SET, 1.13 lbs./l.f.
⊕	WELL
⊙	SEPTIC TANK
⊖	SEPTIC VENT
⊗	LIGHT POLE
⊕	ELECTRIC TRANSFORMER
⊖	ELECTRIC PEDESTAL
⊕	TELEPHONE PEDESTAL
⊖	CABLE TV PEDESTAL

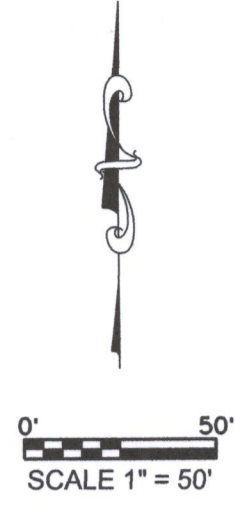

THIS SURVEY IS MADE FOR THE USE OF THE  
 PRESENT OWNERS OF THE PROPERTY, AND  
 ALSO THOSE WHO PURCHASE, MORTGAGE OR  
 GUARANTEE TITLE TO WITHIN ONE (1) YEAR  
 FROM DATE HEREOF.  
 I, MICHAEL A. GRESSON, P.L.S. #2770, HEREBY CERTIFY THAT  
 THIS SURVEY WAS MADE IN ACCORDANCE WITH THE  
 (CHAPTER 19.10) FOR THE STATE OF WISCONSIN AND  
 HAS BEEN PREPARED UNDER MY DIRECTION AND  
 CONTROL AND IS CORRECT TO THE BEST OF MY  
 KNOWLEDGE AND BELIEF.



SURVEY DATE: 08/20/2020  
 SURVEY MADE FOR:  
 HAROLD GRAMER  
 W2848 HWY 20  
 EAST TROY, WI 53120  
**V2G**  
 SURVEYING LLC  
 MANITOWISH WISCONSIN

LA3008-1

417-1121