


PLAT OF SURVEY

CERTIFIED SURVEY MAP NO 303, BEING A PART OF THE SOUTHEAST 1/4 OF SECTION 11, TOWN 4 NORTH, RANGE 17 EAST, TOWN OF TROY, WALWORTH COUNTY, WISCONSIN.



SURVEYED FOR: KRAIG TABOR
SURVEY ADDRESS: W2998 C.T.H. "J"

NORTHWEST CORNER OF
THE SOUTHEAST 1/4 OF
SECTION 11-4-17

NORTHEAST CORNER OF
THE SOUTHEAST 1/4 OF
SECTION 11-4-17

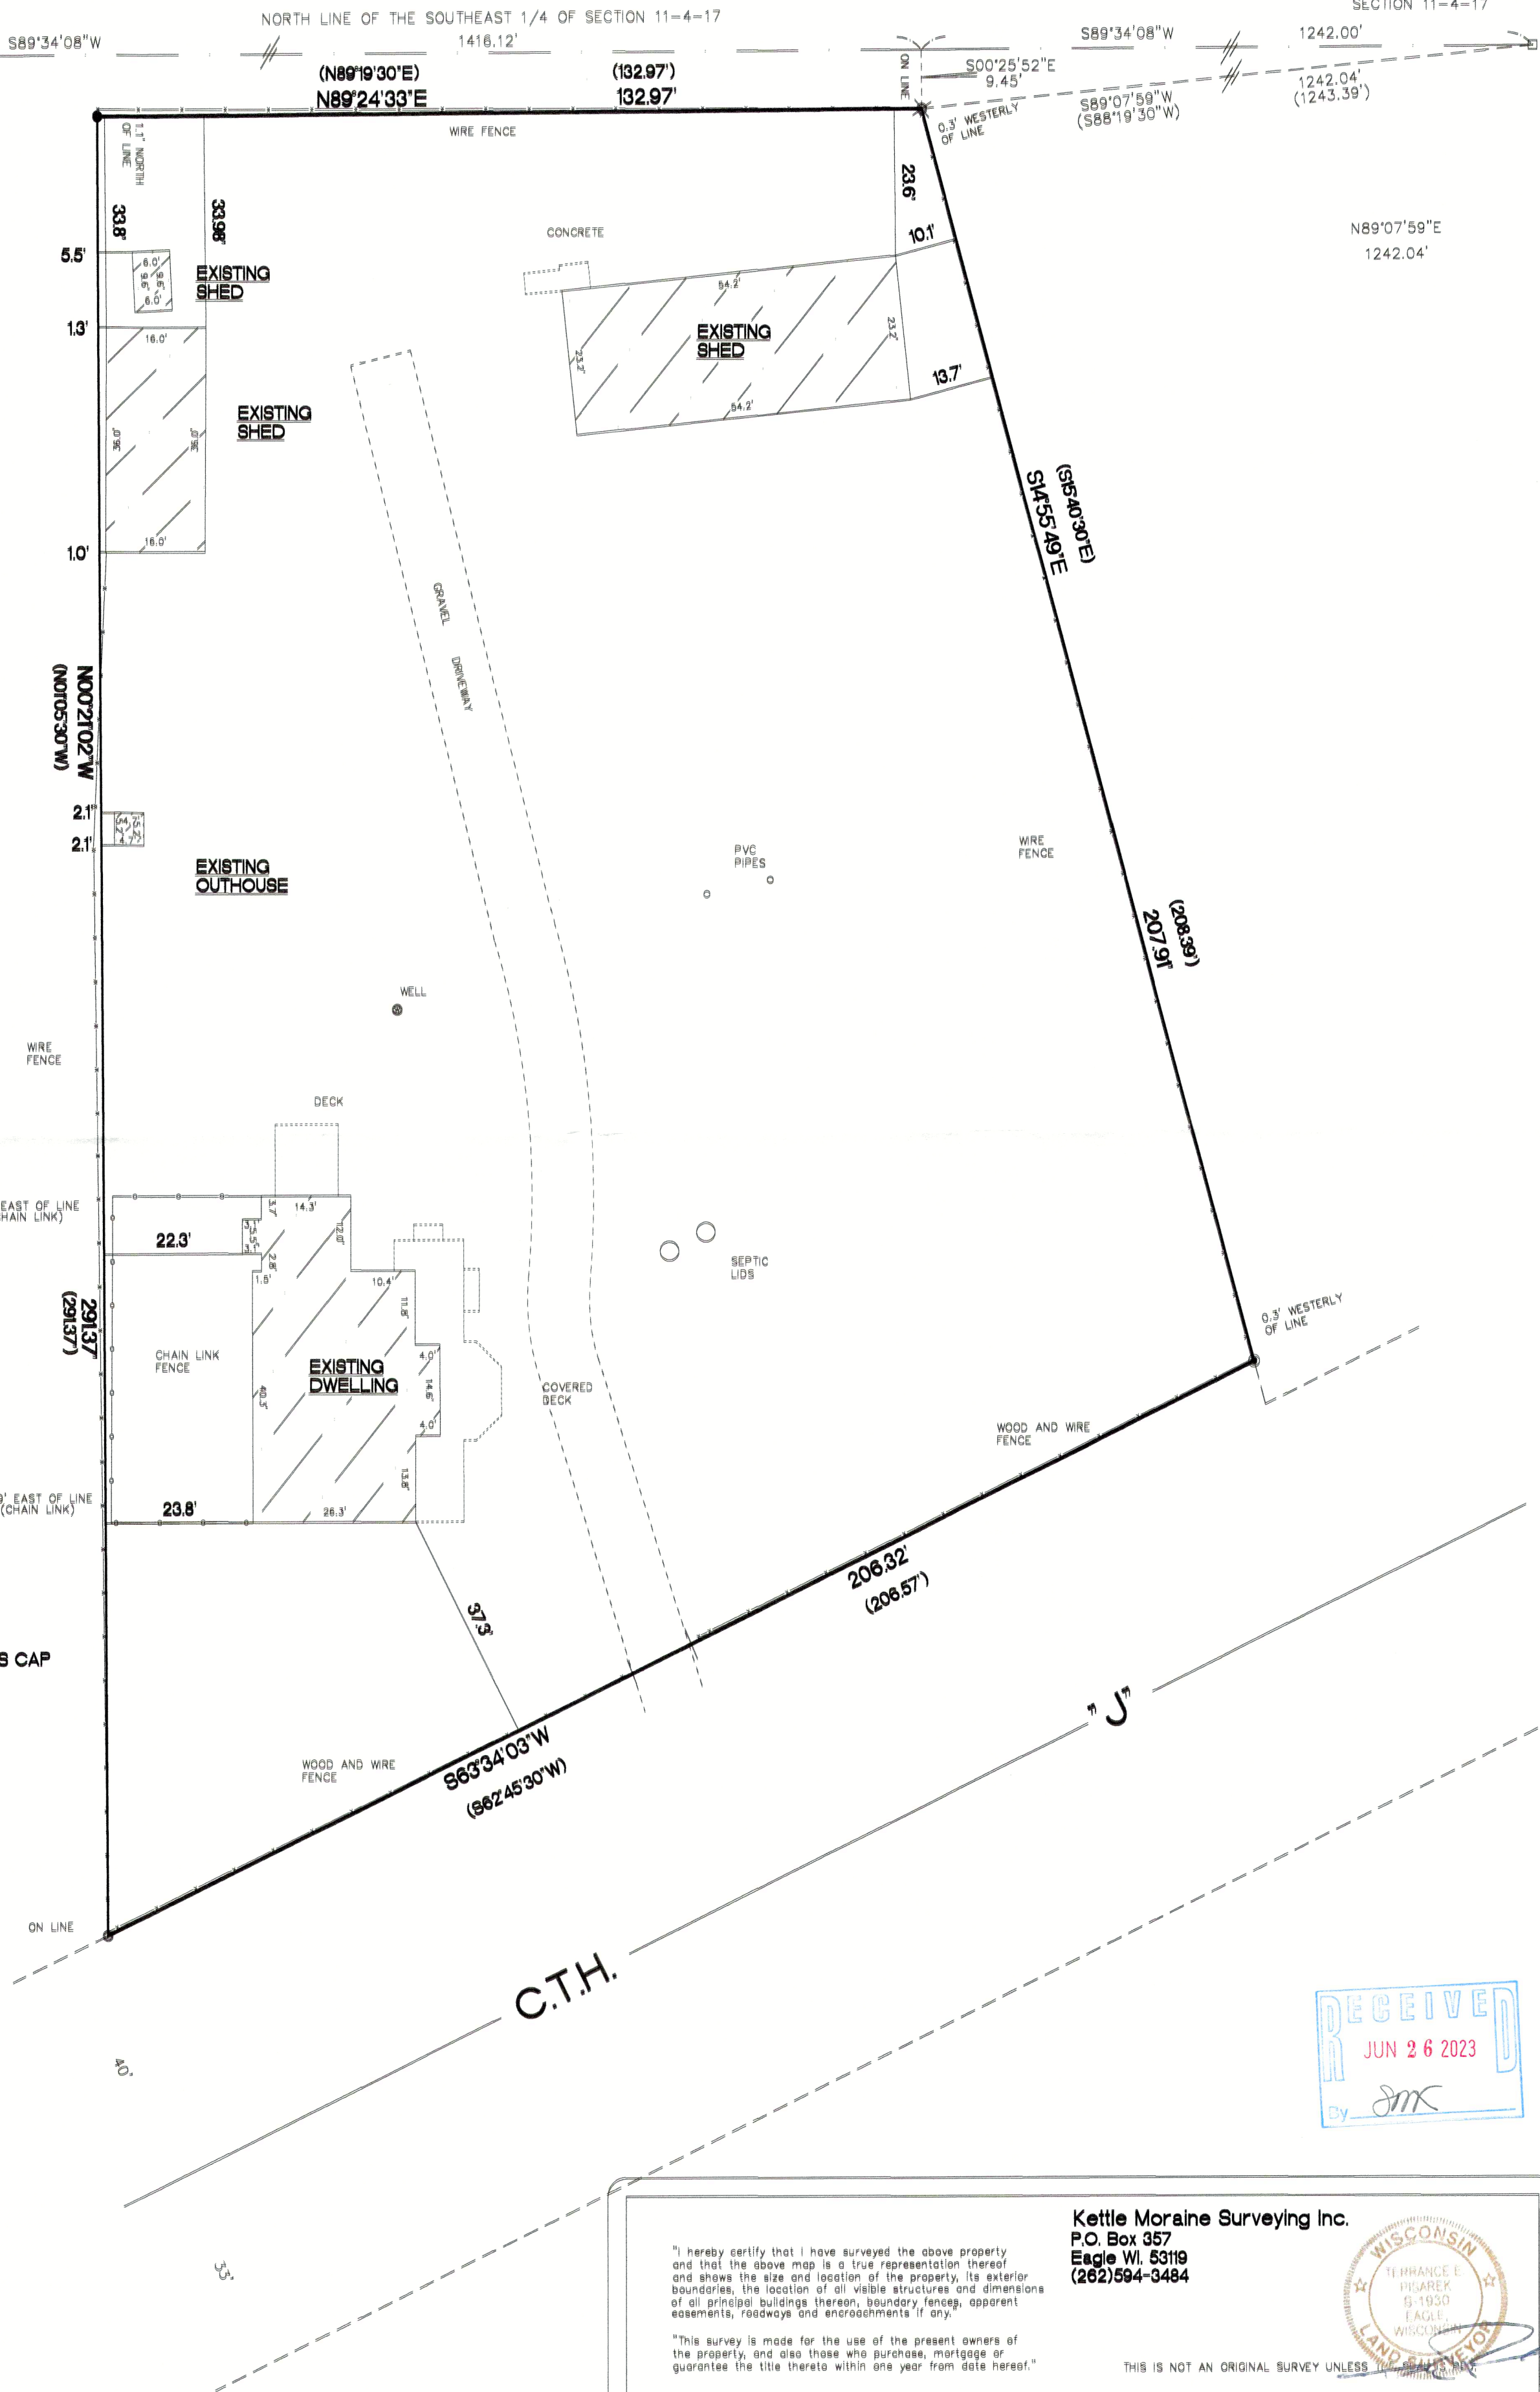

- FOUND 6" CONC. MON. W/BRASS CAP
- FOUND 2" O.D. IRON PIPE
- FOUND 1 1/4" O.D. IRON PIPE
- FOUND 1" O.D. IRON PIPE
- SET 1 1/4" O.D. IRON PIPE
- RECORDED AS DIMENSIONS

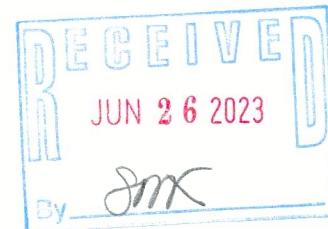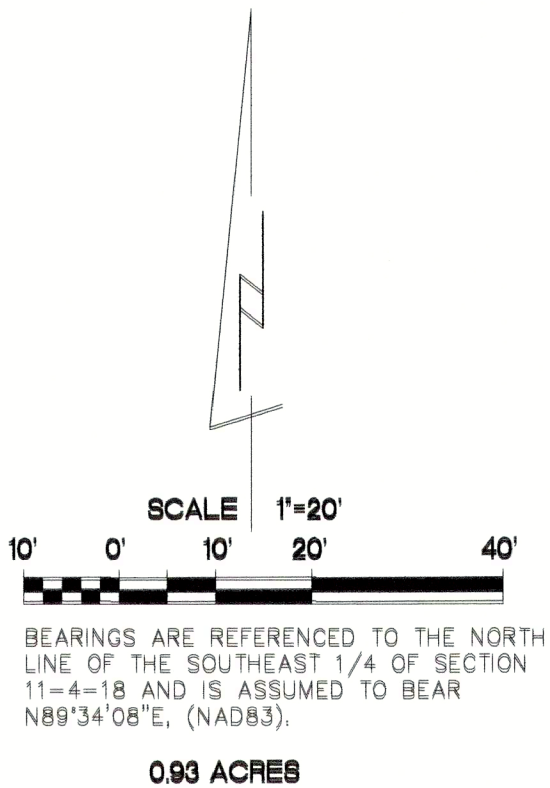

Kettle Moraine Surveying Inc.
P.O. Box 357
Eagle WI, 53119
(262)594-3484

"I hereby certify that I have surveyed the above property and that the above map is a true representation thereof and shows the size and location of the property, its exterior boundaries, the location of all visible structures and dimensions of all principal buildings thereon, boundary fences, apparent easements, roadways and encroachments if any."

"This survey is made for the use of the present owners of the property, and also those who purchase, mortgage or guarantee the title thereto within one year from date hereof."

THIS IS NOT AN ORIGINAL SURVEY UNLESS THE SEAL IS PRESENT

4/14/2023 DATE TEP FIELD WORK BY TEP DRAWN BY 23018 JOB NUMBER

LA 303-1

477-1181