



417-

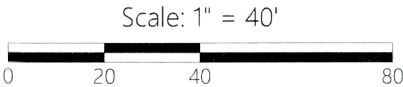

DISTANCE UNITS BASED ON THE UNITED STATES SURVEY FOOT

BEARINGS BASED ON THE WISCONSIN COORDINATE REFERENCE SYSTEM, WALWORTH ZONE. THE EAST LINE OF BLOCK 16 BEARING S 0°40'33" W.

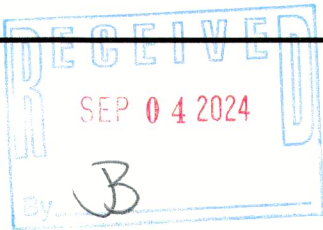


PLAT OF SURVEY

OF PART OF HILL CREST AND VAUGHN DRIVE RIGHT-OF-WAY AS SHOWN HEREON, IN FOUR LAKES BEACH, BEING PART OF THE SW 1/4 OF THE SW 1/4 OF SECTION 8, T. 4 N., R. 17 E., OF THE 4TH P.M., TOWN OF TROY, WALWORTH COUNTY, WISCONSIN.

SURVEYOR'S NOTE:

THE RIGHT-OF-WAY AS SURVEYED AND SHOWN HEREON HAS BEEN ESTABLISHED BY ACCEPTING THE LOCATION OF FOUNDATION MONUMENTATION AT LOT AND BLOCK CORNERS.

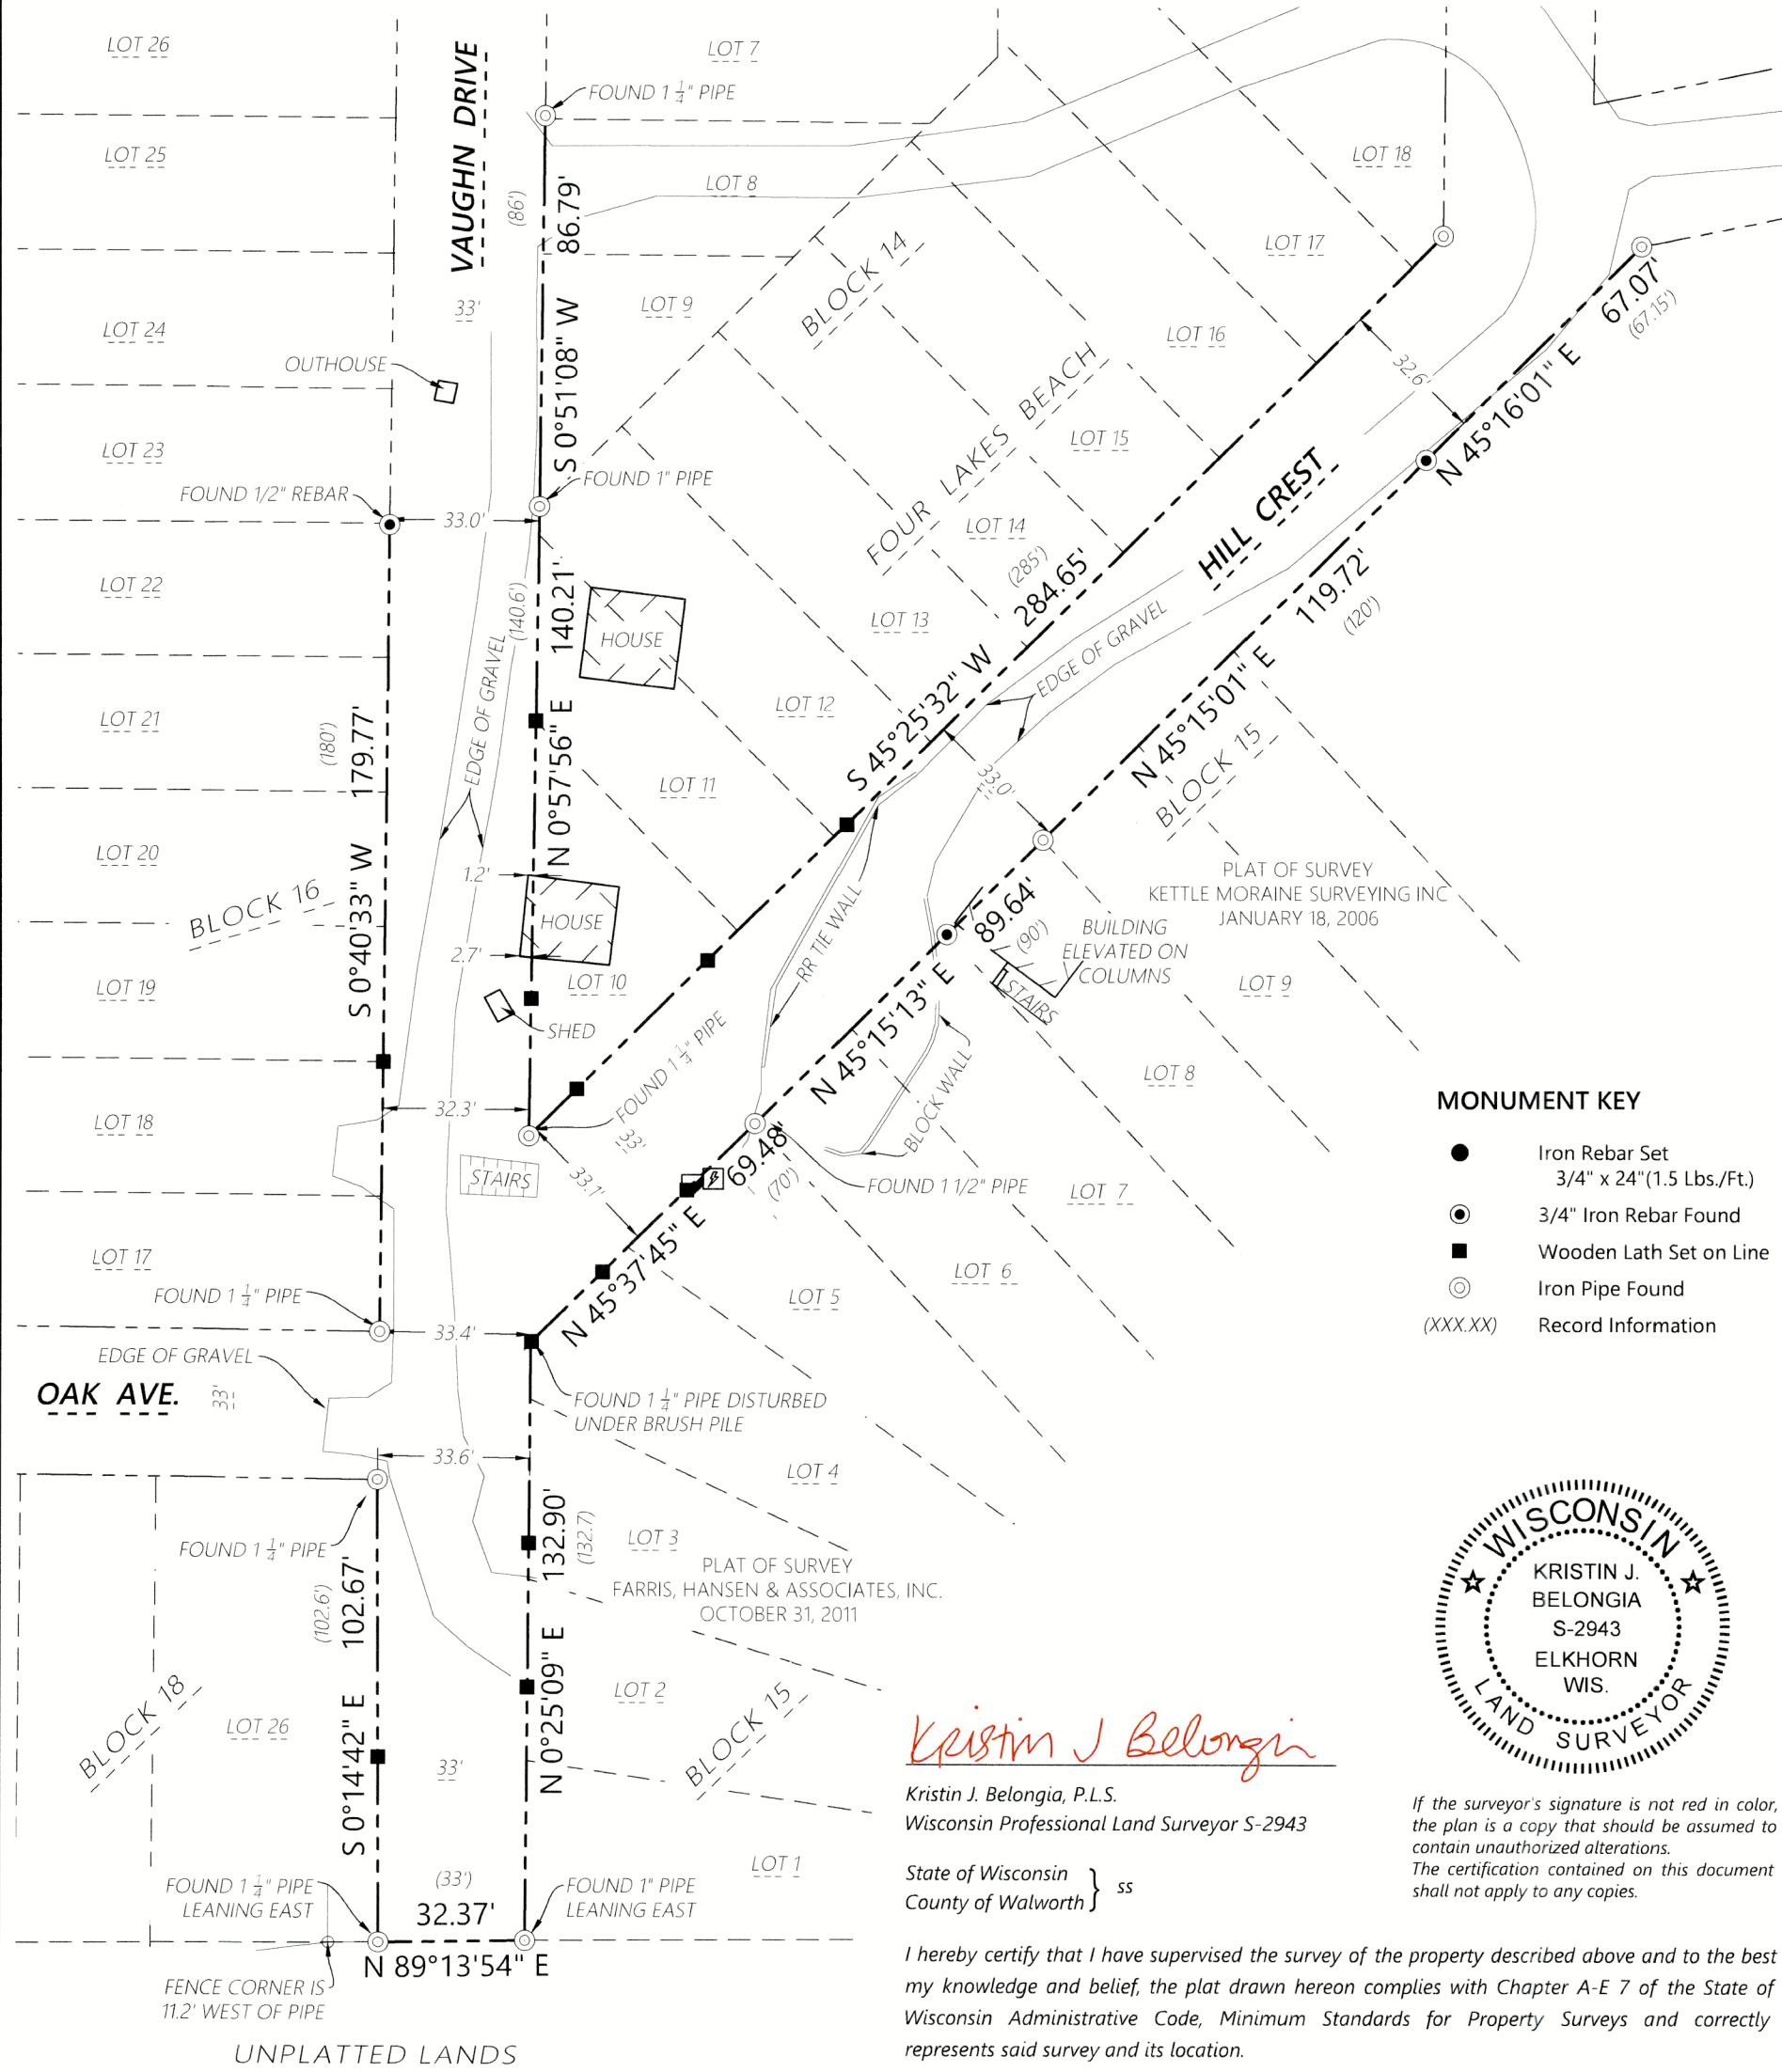

MONUMENT KEY

- Iron Rebar Set 3/4" x 24" (1.5 Lbs./Ft.)
- ⊙ 3/4" Iron Rebar Found
- Wooden Lath Set on Line
- ⊙ Iron Pipe Found
- (XXX.XX) Record Information



Kristin J Belongia

Kristin J. Belongia, P.L.S.
Wisconsin Professional Land Surveyor S-2943

State of Wisconsin } ss
County of Walworth }

I hereby certify that I have supervised the survey of the property described above and to the best of my knowledge and belief, the plat drawn hereon complies with Chapter A-E 7 of the State of Wisconsin Administrative Code, Minimum Standards for Property Surveys and correctly represents said survey and its location.

Given under my hand and seal this 21st day of May, 2024 at Beloit, Wisconsin.
Last day of field work May 2nd, 2024.

If the surveyor's signature is not red in color, the plan is a copy that should be assumed to contain unauthorized alterations.
The certification contained on this document shall not apply to any copies.

ORDER NO: 34205

FIELD CREW: DGM
DRAWN BY: DGM
SHEET 1 OF 1

FOR THE EXCLUSIVE USE OF:

JEFF POIRIOR
W9708 RIPLEY ROAD
CAMBRIDGE, WI 53523

PLAT OF SURVEY

Batterman

engineers surveyors planners
BELOIT | ELKHORN | JANESVILLE
2857 S. Bartells Dr., Beloit, WI 53511
608.365.4464 | www.rhbatterman.com

