


PLAT OF SURVEY
LOTS 8, 9, 11, 12, 13, & 14 OF BLOCK 14 OF FOUR LAKES BEACH, A SUBDIVISION
LOCATED IN PART OF THE SOUTHWEST 1/4 OF SECTION 8, TOWN 4 NORTH, RANGE 17 EAST, WALWORTH COUNTY, WISCONSIN

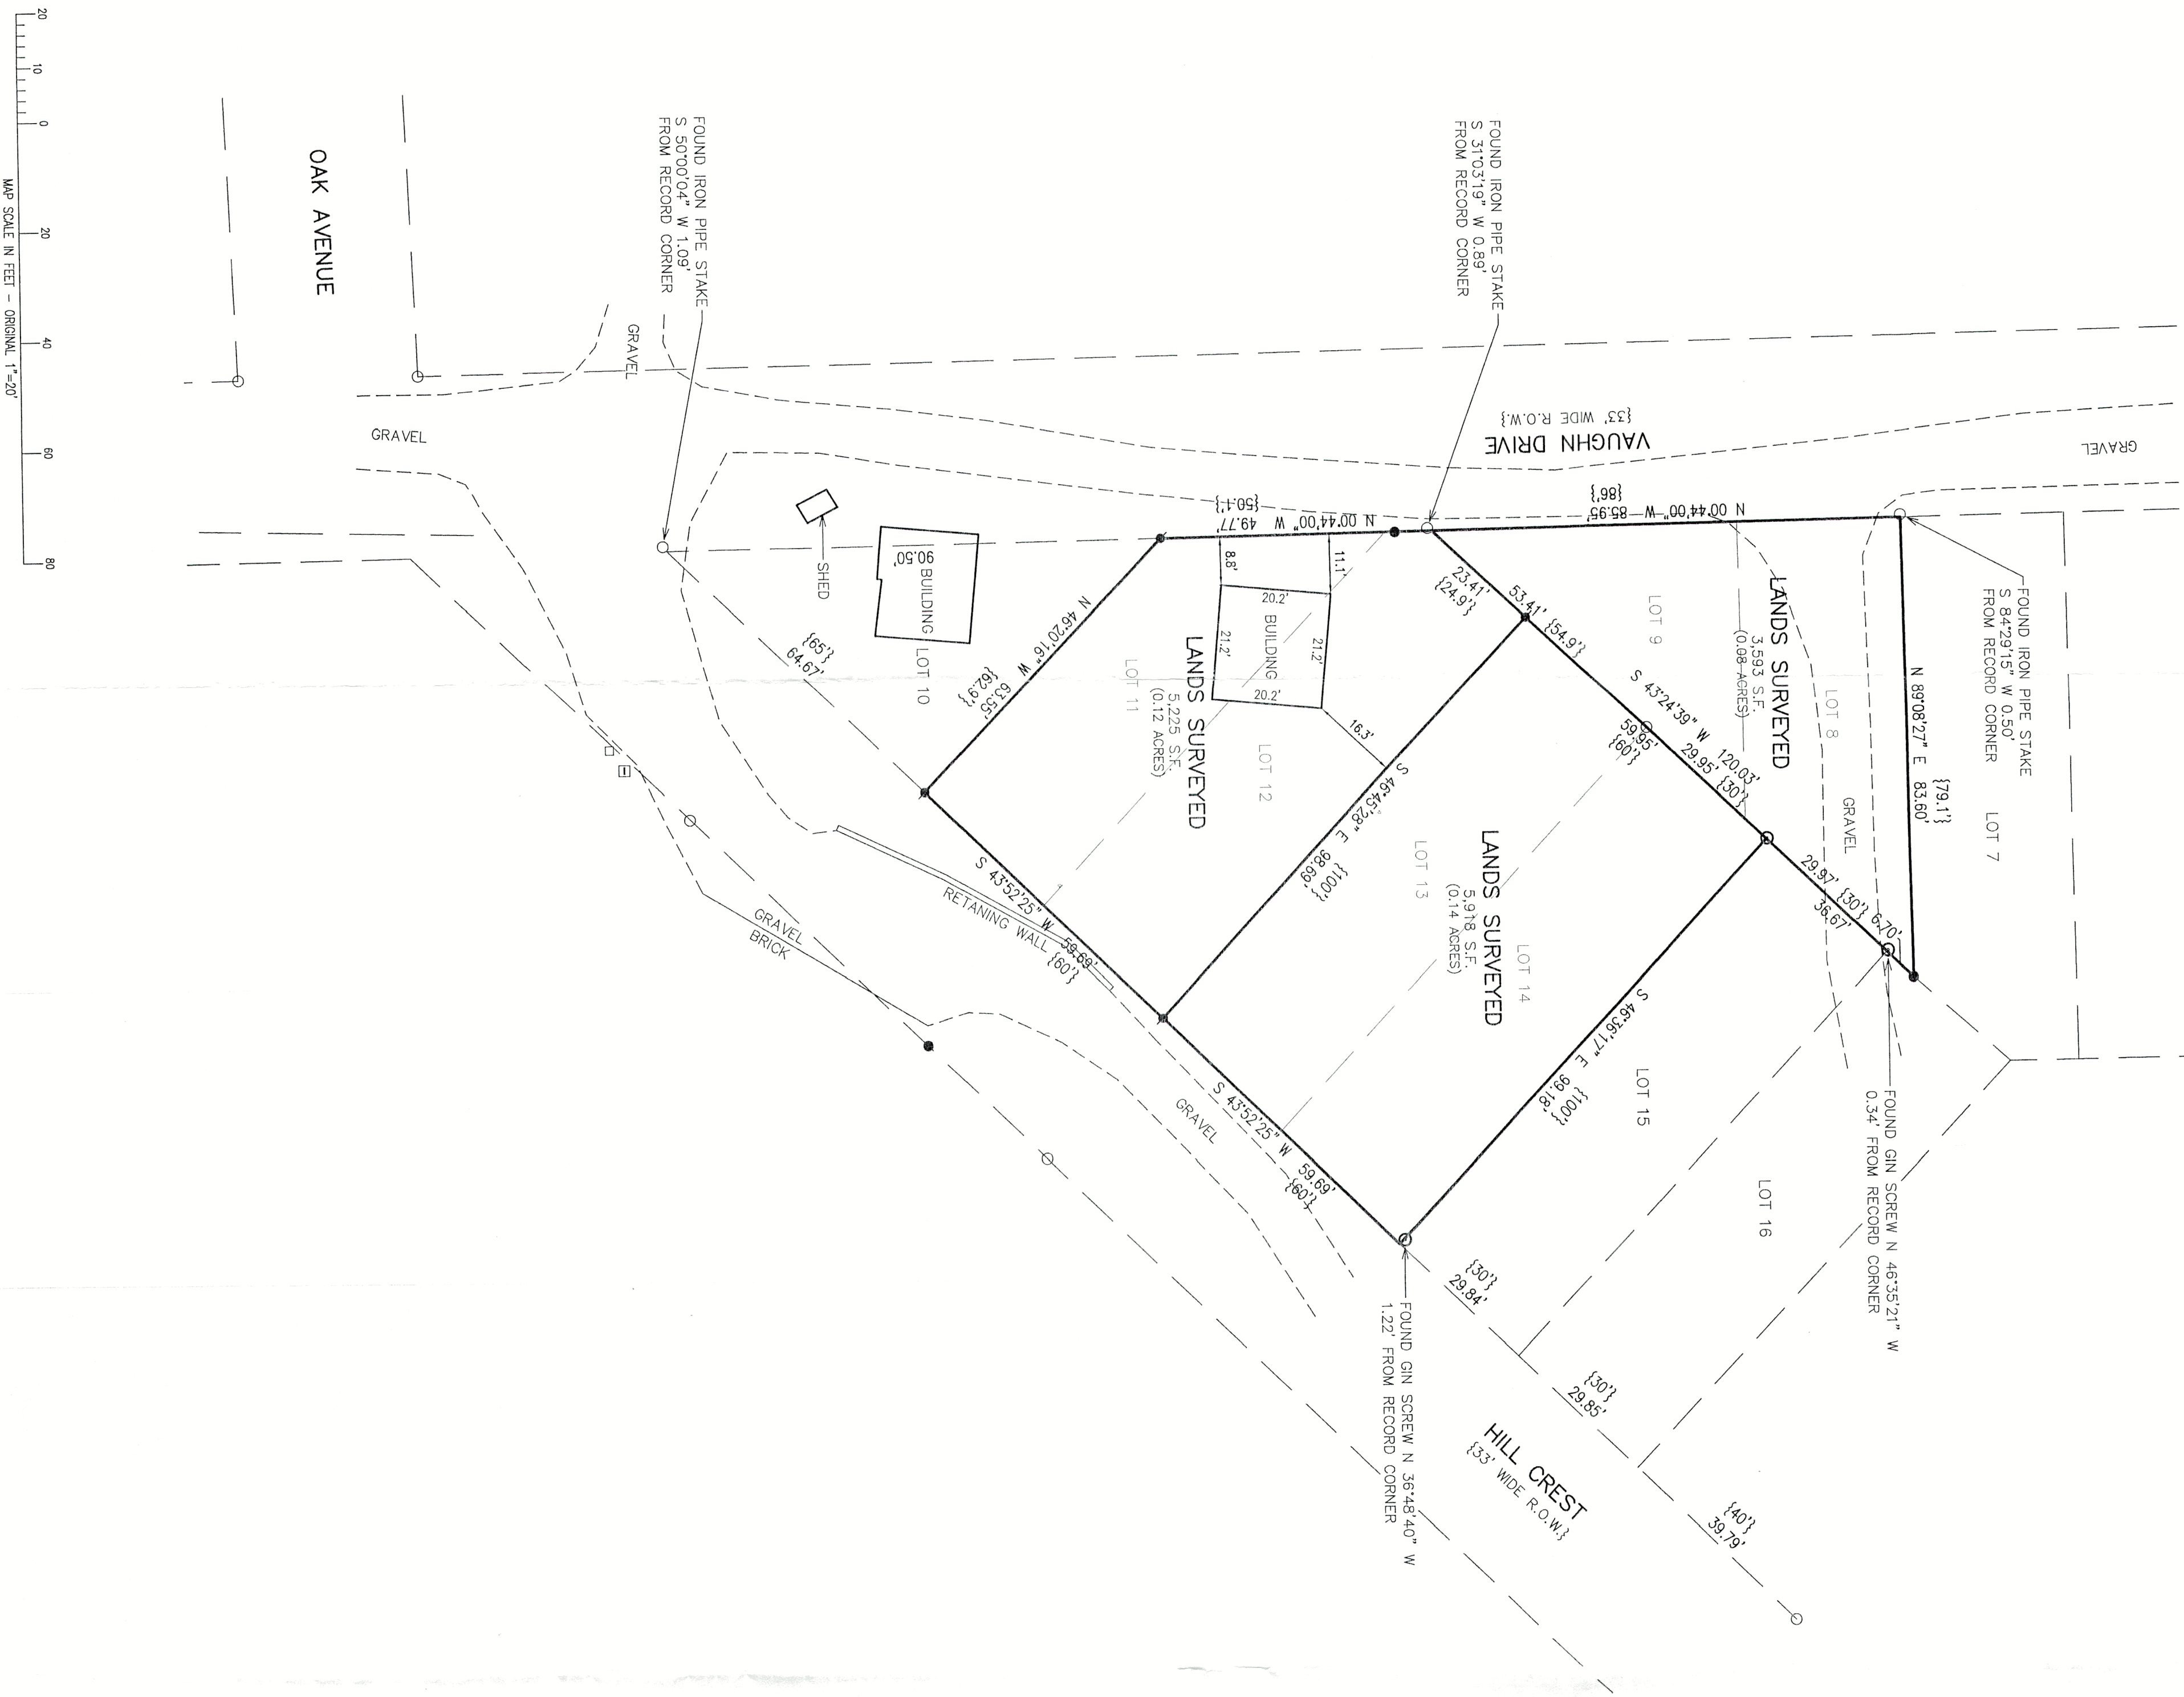

ASSIGNED THE EASTERLY RIGHT OF WAY BOUNDARY
OF VAUGHN DRIVE N 00°44'00" W


- LEGEND
- = FOUND IRON PIPE STAKE
 - = FOUND IRON REBAR STAKE
 - ⊙ = FOUND GIN SCREW
 - ⦿ = SET IRON REBAR STAKE
 - = CABLE BOX LOCATED
 - ⊞ = ELECTRIC TRANSFORMER LOCATED
 - [xxx] = RECORDED AS

NOTE: COPIES OF THIS MAP TO WHICH THE FOLLOWING CERTIFICATE WILL APPLY SHOW THE SURVEYOR'S ORIGINAL SEAL AND SIGNATURE IN RED INK. COPIES BY ANY OTHER MEANS MAY HAVE ALTERATIONS WHICH DO NOT REPRESENT THE SURVEYOR'S WORK PRODUCT.

I HEREBY CERTIFY THAT THE ABOVE DESCRIBED PROPERTY HAS BEEN SURVEYED UNDER MY PERSONAL SUPERVISION AND THAT THE ABOVE MAP IS A TRUE REPRESENTATION THEREOF AND SHOWS THE SIZE AND LOCATION OF THE PROPERTY AND ITS EXTERIOR BOUNDARIES. THIS SURVEY IS MADE FOR THE USE OF THE PRESENT OWNERS OF THE PROPERTY, AND ALSO THOSE WHO PURCHASE, MORTGAGE, OR GUARANTEE THE TITLE THERETO WITHIN ONE YEAR FROM THE DATE HEREOF. FIELD WORK WAS CONDUCTED 10/24/2024.

DATED: 11/1/2024

By *APK*
NOV 15 2024
417-11220

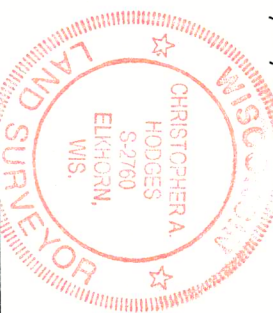


CHRISTOPHER A. HODGES P.L.S. 2780

FARRIS, HANSEN & ASSOCIATES, INC.
ENGINEERING — ARCHITECTURE — SURVEYING
7 RIDGWAY COURT P.O. BOX 437
ELKHORN, WISCONSIN 53121
PHONE: (262) 723-2098 e-mail: office@farrishansen.com

— WORK ORDERED BY —
TONY PIONTEK
W309S8880 GREEN ACRE DRIVE
MUKWONAGO, WI 53149

PLAT OF SURVEY
TOWN OF TROY
WALWORTH COUNTY, WISCONSIN

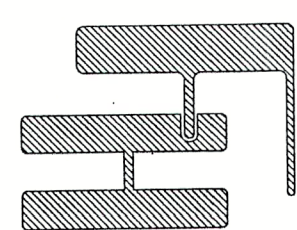

PROJECT NO. 11122
DATE 11/01/2024
SHEET NO. 1 OF 1