


PLAT OF SURVEY – BOUNDARY SURVEY N8887 SWIFT LAKE ROAD

LOTS 4 AND PART OF 52
LOCATED IN THE SW 1/4 OF THE SE 1/4 OF SECTION 8, TOWN 4 SOUTH, RANGE 17 EAST
TOWN OF TROY, WALWORTH COUNTY, WISCONSIN
PARCEL #'S: LSL00010 & LSL0006A

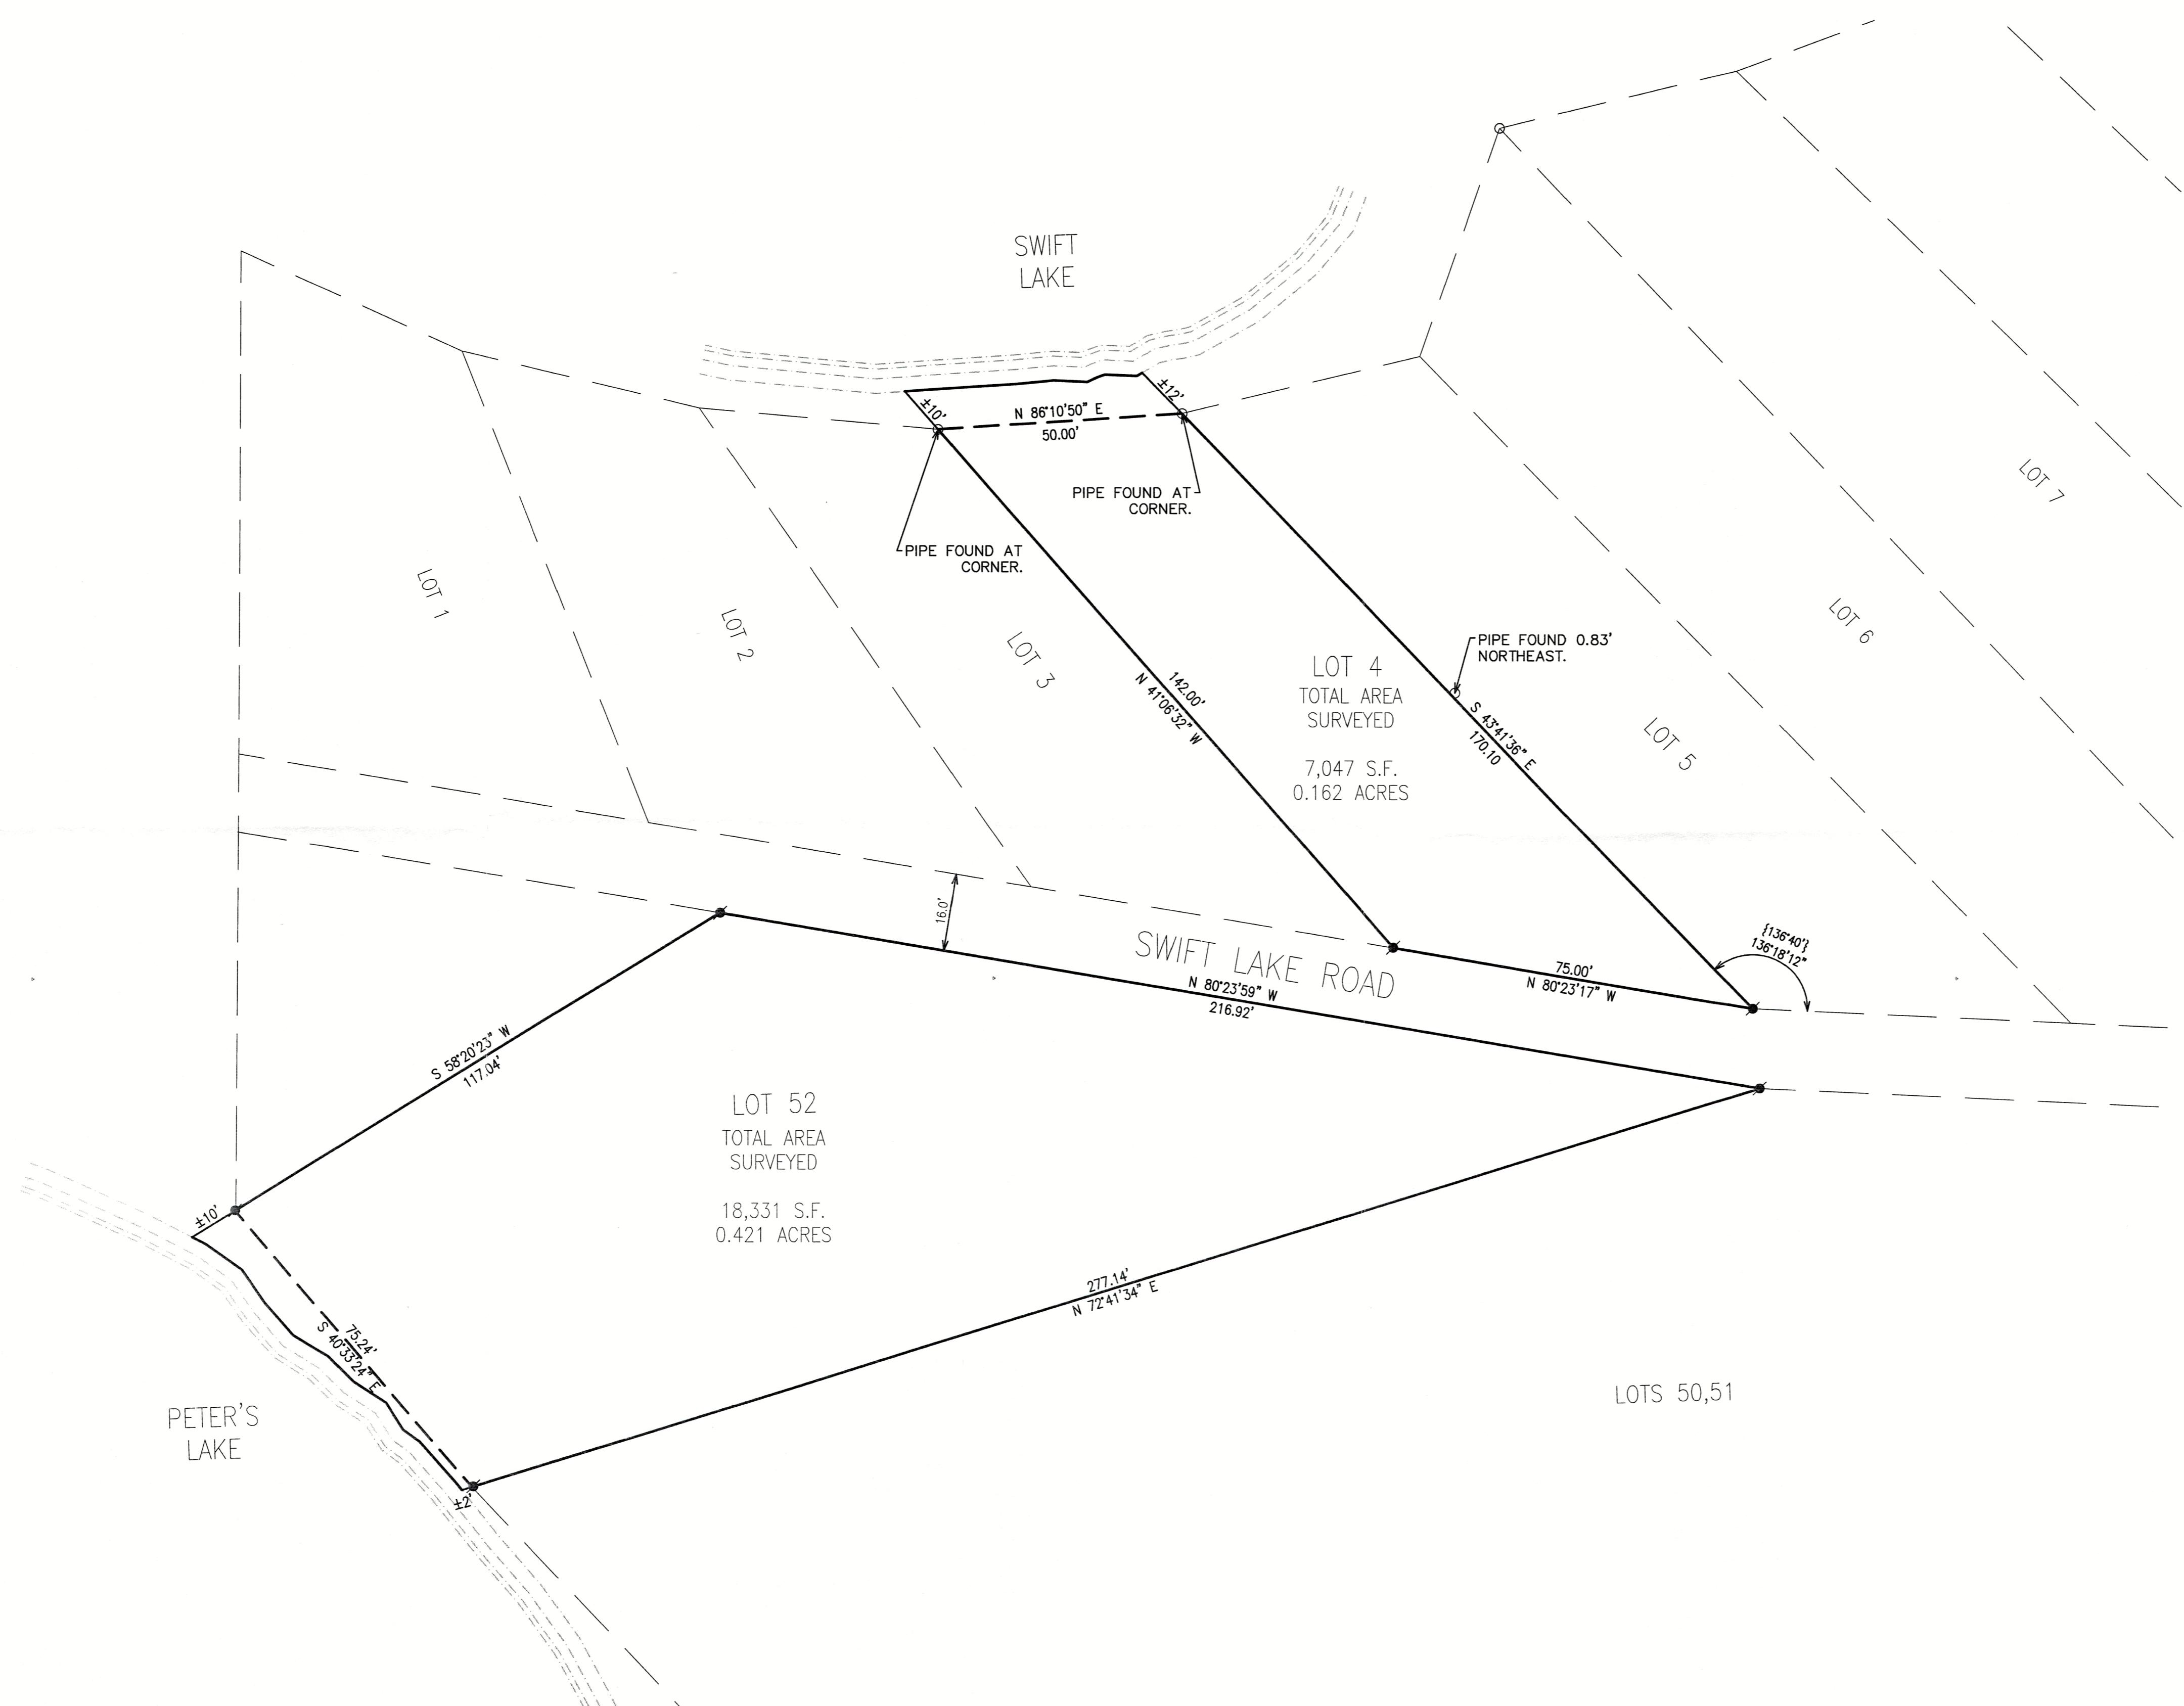



NOTE: COPIES OF THIS MAP TO WHICH THE FOLLOWING CERTIFICATE WILL APPLY SHOW THE SURVEYOR'S ORIGINAL SEAL AND SIGNATURE IN RED INK. COPIES BY ANY OTHER MEANS MAY HAVE ALTERATIONS WHICH DO NOT REPRESENT THE SURVEYOR'S WORK PRODUCT.

I HEREBY CERTIFY THAT THE ABOVE DESCRIBED PROPERTY HAS BEEN SURVEYED UNDER MY DIRECTION AND THAT THE ABOVE MAP IS A TRUE REPRESENTATION THEREOF AND SHOWS THE SIZE AND LOCATION OF THE PROPERTY AND ITS EXTERIOR BOUNDARIES. THIS SURVEY IS MADE FOR THE USE OF THE PRESENT OWNERS OF THE PROPERTY, AND ALSO THOSE WHO PURCHASE, MORTGAGE, OR GUARANTEE THE TITLE THERETO WITHIN ONE YEAR FROM THE DATE HEREOF. FIELDWORK COMPLETED 4/28/2025 AND 7/7/2025.

DATED: 07/24/2025
CHRISTOPHER A. HODGES P.L.S. 2760



DISCLAIMER
THE LAKE SHORES WERE DIGITIZED OFF OFF COUNTY GIS. ACTUAL SHORELINE VARIES BY TIME OF YEAR AND RAINFALL ACCUMULATION.

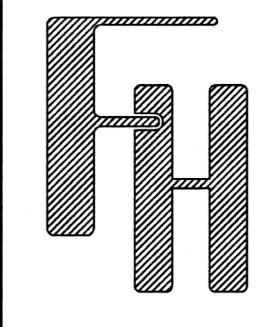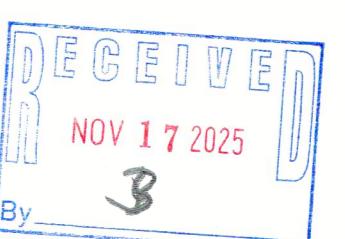

PLAT OF SURVEY
BOUNDARY SURVEY
N8887 SWIFT LAKE ROAD
EAST TROY, WALWORTH, WISCONSIN

<WORK ORDERED BY>
JIM HECKENDORF
1024 TARRANT DRIVE
FONTANA, WISCONSIN 53125

FARRIS, HANSEN & ASSOCIATES, INC.
ENGINEERING – ARCHITECTURE – SURVEYING
7 RIDGEWAY COURT P.O. BOX 437
ELKHORN, WISCONSIN 53121
PHONE: (262) 723-2098 e-mail: office@farris-hansen.com

REVISIONS
PROJECT NO. 11206
DATE 07/24/2025
SHEET NO. 1 OF 1