


HAROLD H. KOLB

REGISTERED PROFESSIONAL LAND SURVEYOR
LAKE GENEVA, WISCONSIN

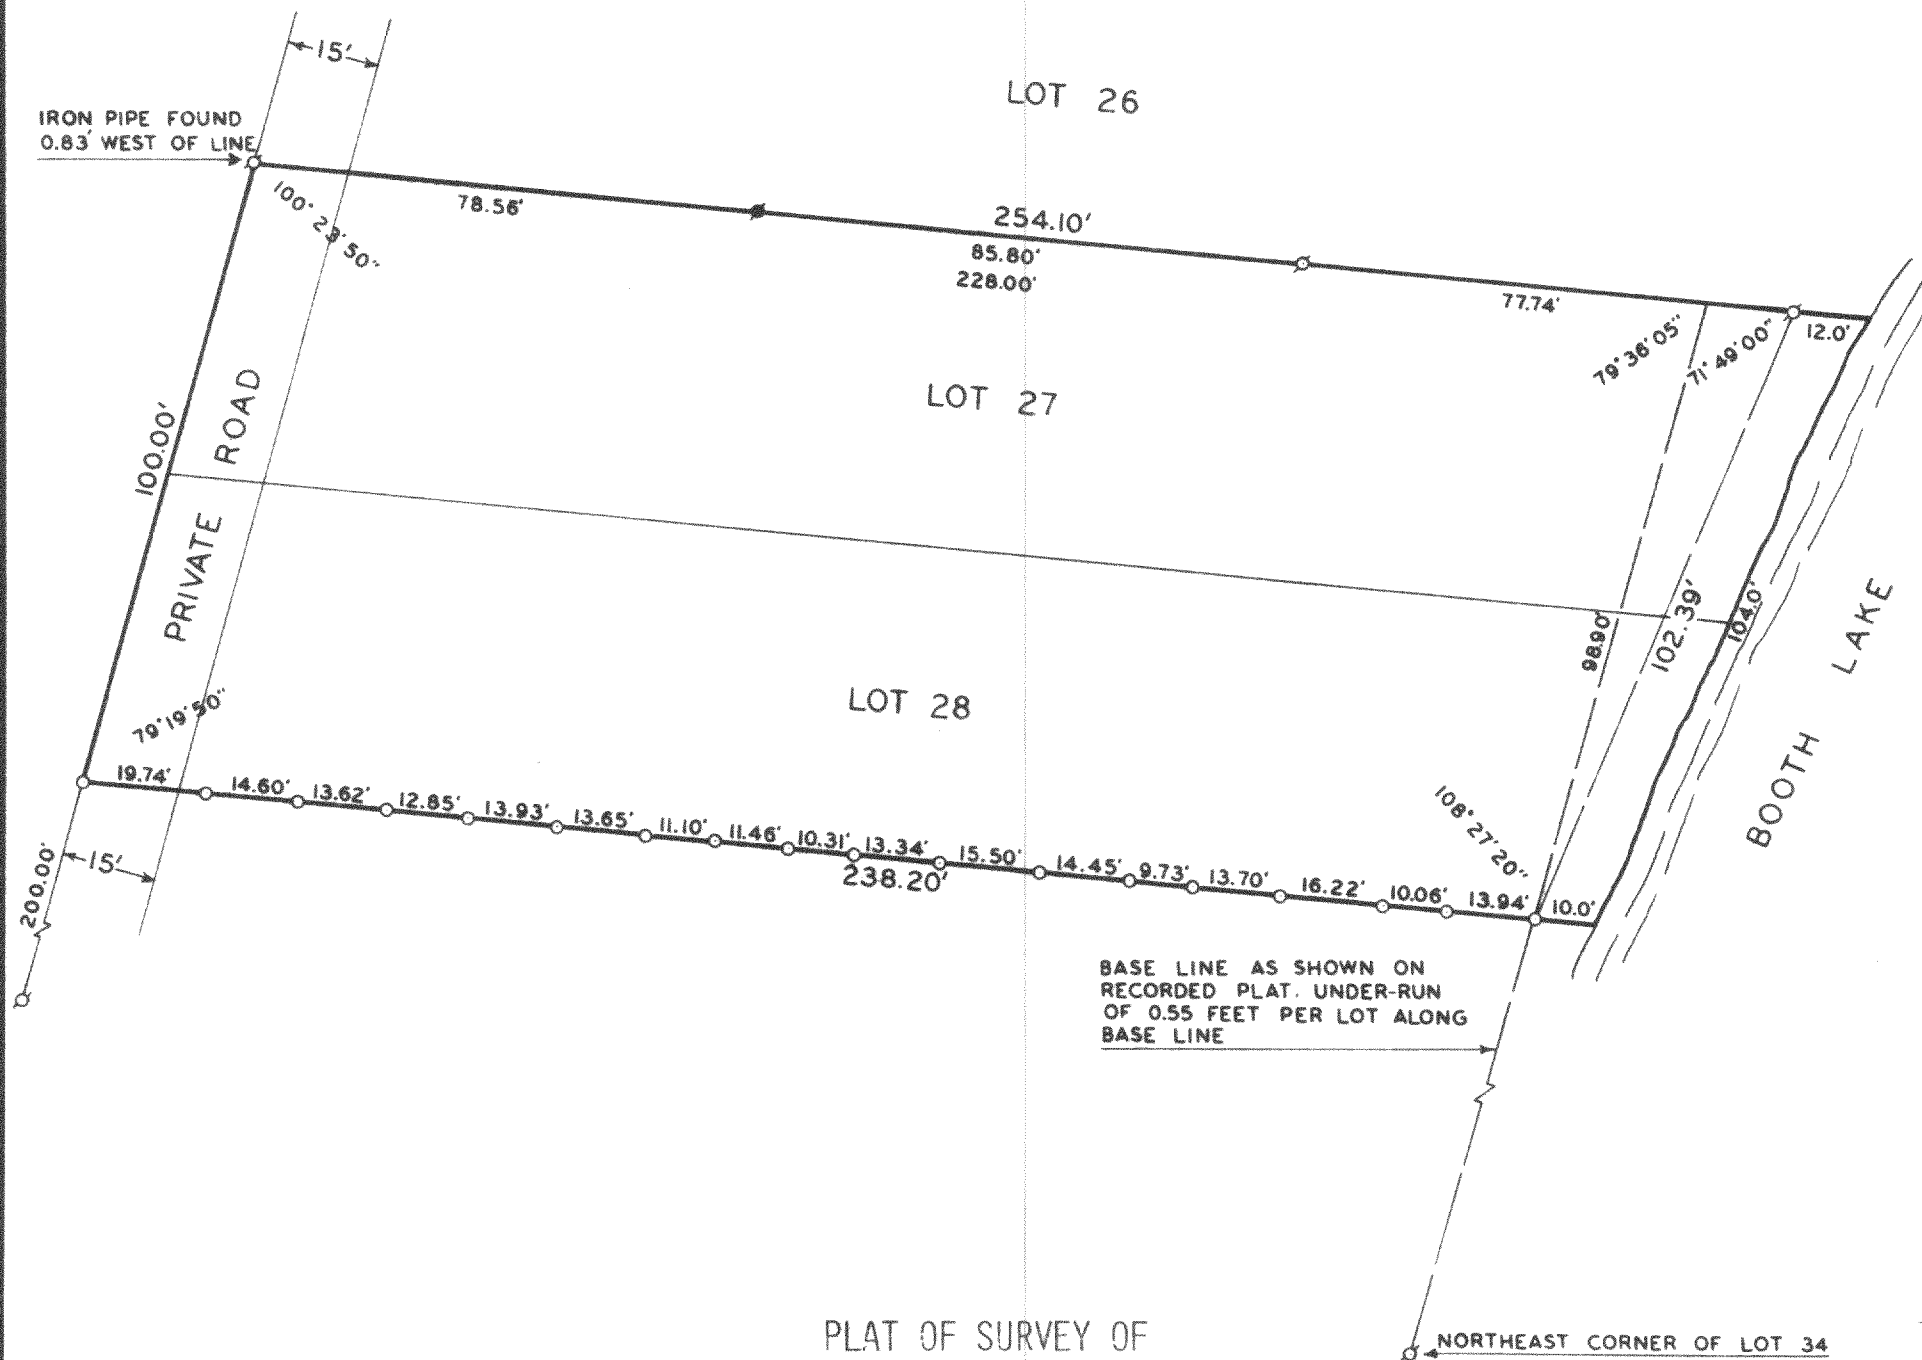

PLAT OF SURVEY OF

LOTS 27 AND 28, BOOTH LAKE HEIGHTS, A SUBDIVISION
LOCATED IN THE NORTH 1/2 OF SECTION 24 AND THE
SOUTH 1/2 OF SECTION 13, T 4 N, R 17 E, WALWORTH
COUNTY, WISCONSIN.

ACCURACY: DISTANCES $\pm 0.01'$
ANGLES $\pm 05''$

ERROR OF CLOSURE--LESS THAN
ONE PART IN 3000

ORDERED BY:

JOHN MCCOLLOM

N
SCALE: 1" = 30'
LEGEND

- φ — IRON PIPE FOUND
- — IRON PIPE PLACED
- ✕ — IRON ROD FOUND
- x — SPIKE

I, HAROLD H. KOLB, DO HEREBY CERTIFY THAT I HAVE
SURVEYED THE PROPERTY HEREON DESCRIBED ACCORDING
TO THE OFFICIAL RECORDS, AND THAT THE PLAT HEREON
IS A CORRECT REPRESENTATION OF THE LOT LINES.

Harold H. Kolb
HAROLD H. KOLB
WISCONSIN REGISTERED LAND SURVEYOR, S-187
DATE Nov. 11, 1976

LBL-23