


PLAT OF SURVEY

LEGAL DESCRIPTION:

May 18, 2026

May 27, 2026
Revised & Moved
Prop. Garage
(Not Staked)

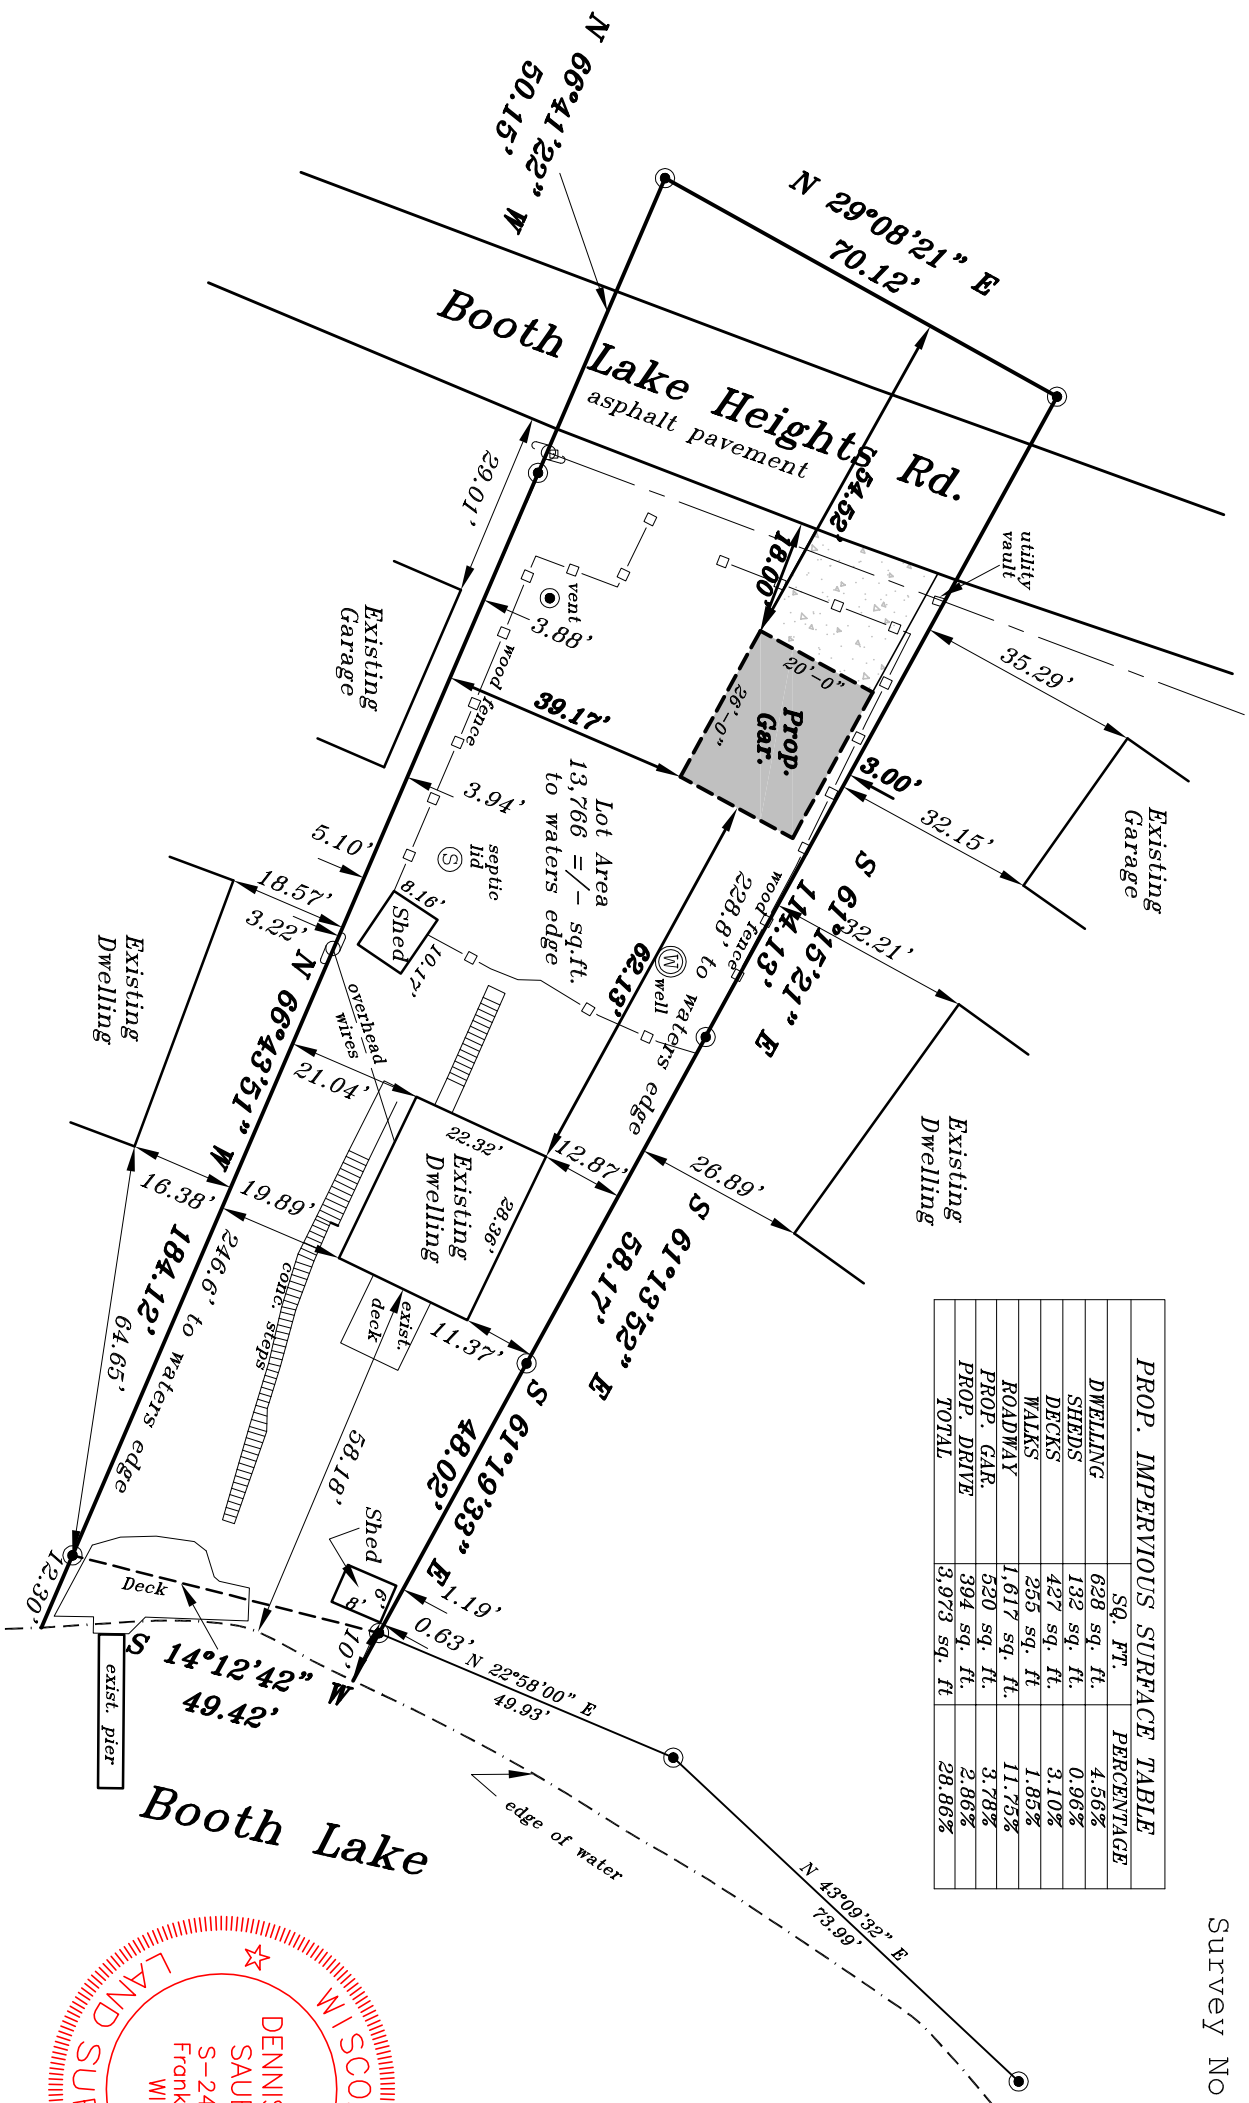

PROP. IMPERVIOUS SURFACE TABLE		
	SQ. FT.	PERCENTAGE
DWELLING	628 sq. ft.	4.56%
SHEDS	132 sq. ft.	0.96%
DECKS	427 sq. ft.	3.10%
WALKS	255 sq. ft.	1.85%
ROADWAY	1,617 sq. ft.	11.75%
PROP. GAR.	520 sq. ft.	3.78%
PROP. DRIVE	394 sq. ft.	2.86%
TOTAL	3,973 sq. ft.	28.86%

The seal is circular with a double-lined border. The outer ring contains the text "WISCONSIN" at the top and "LAND SURVEYOR" at the bottom, separated by two five-pointed stars. The inner circle contains the text "DENNIS C. SAUER", "S-2421", and "Franklin, WI" arranged vertically.

PROFESSIONAL LAND SURVEYORS

PH. (414) 529-5380



- — Denotes Iron Pipe Found
- — Denotes Iron Pipe Set

This property is in Zone X of

the Flood Insurance Rate Map, Community Panel No. 5512Z C0091D which has an effective date of November 2, 2009 and IS NOT in a Special Flood Hazard Area. Field surveying was not performed to determine this zone. An elevation certificate may be needed to verify this determination or apply for an amendment from the Federal Emergency Management Agency.

I HEREBY CERTIFY THAT I HAVE SURVEYED THE ABOVE DESCRIBED PROPERTY AND THE SURVEY COMPLEES WITH A-E7, AND IS CORRECT TO THE BEST OF MY KNOWLEDGE AND BELIEF. THE ABOVE MAP IS A TRUE REPRESENTATION THEREOF AND SHOWS THE SIZE AND LOCATION OF THE PROPERTY, ITS EXTERIOR BOUNDARIES, THE LOCATION OF ALL VISIBLE STRUCTURES AND DIMENSIONS OF ALL PRINCIPAL BUILDINGS THEREON, BOUNDARY FENCES, APPARENT EASEMENTS AND ROADWAYS AND VISIBLE ENCROACHMENT, IF ANY.

THIS SURVEY IS MADE FOR THE EXCLUSIVE USE OF THE PRESENT OWNERS OF THE PROPERTY AND ALSO THOSE WHO PURCHASE, MORTGAGE, OR GUARANTEE THE TITLE THERETO WITHIN ONE (1) YEAR FROM THE DATE HEREON.

THIS SURVEY IS MADE FOR THE EXCLUSIVE USE OF THE PRESENT OWNERS OF THE PROPERTY

ONE (1) YEAR FROM THE DATE HEREOF

Dennis C. Sauer

Professional Land Surveyor S-2421