


PLAT OF SURVEY

THE EAST 40 FEET OF LOT 4 AND THE WEST 25 FEET OF LOT 5, HULQUIST'S SUBDIVISION, BEING A PART OF THE NORTHEAST 1/4 OF SECTION 24, TOWN 4 NORTH, RANGE 17 EAST, TOWN OF TROY, WALNORTH COUNTY WISCONSIN.
SURVRYED FOR: JM SWAN CONSTRUCTION/LOVELAND
SURVEY ADDRESS: W2570 BOOTH LAKE LANE

BOOTH LAKE

WATER ELEVATION 815.6

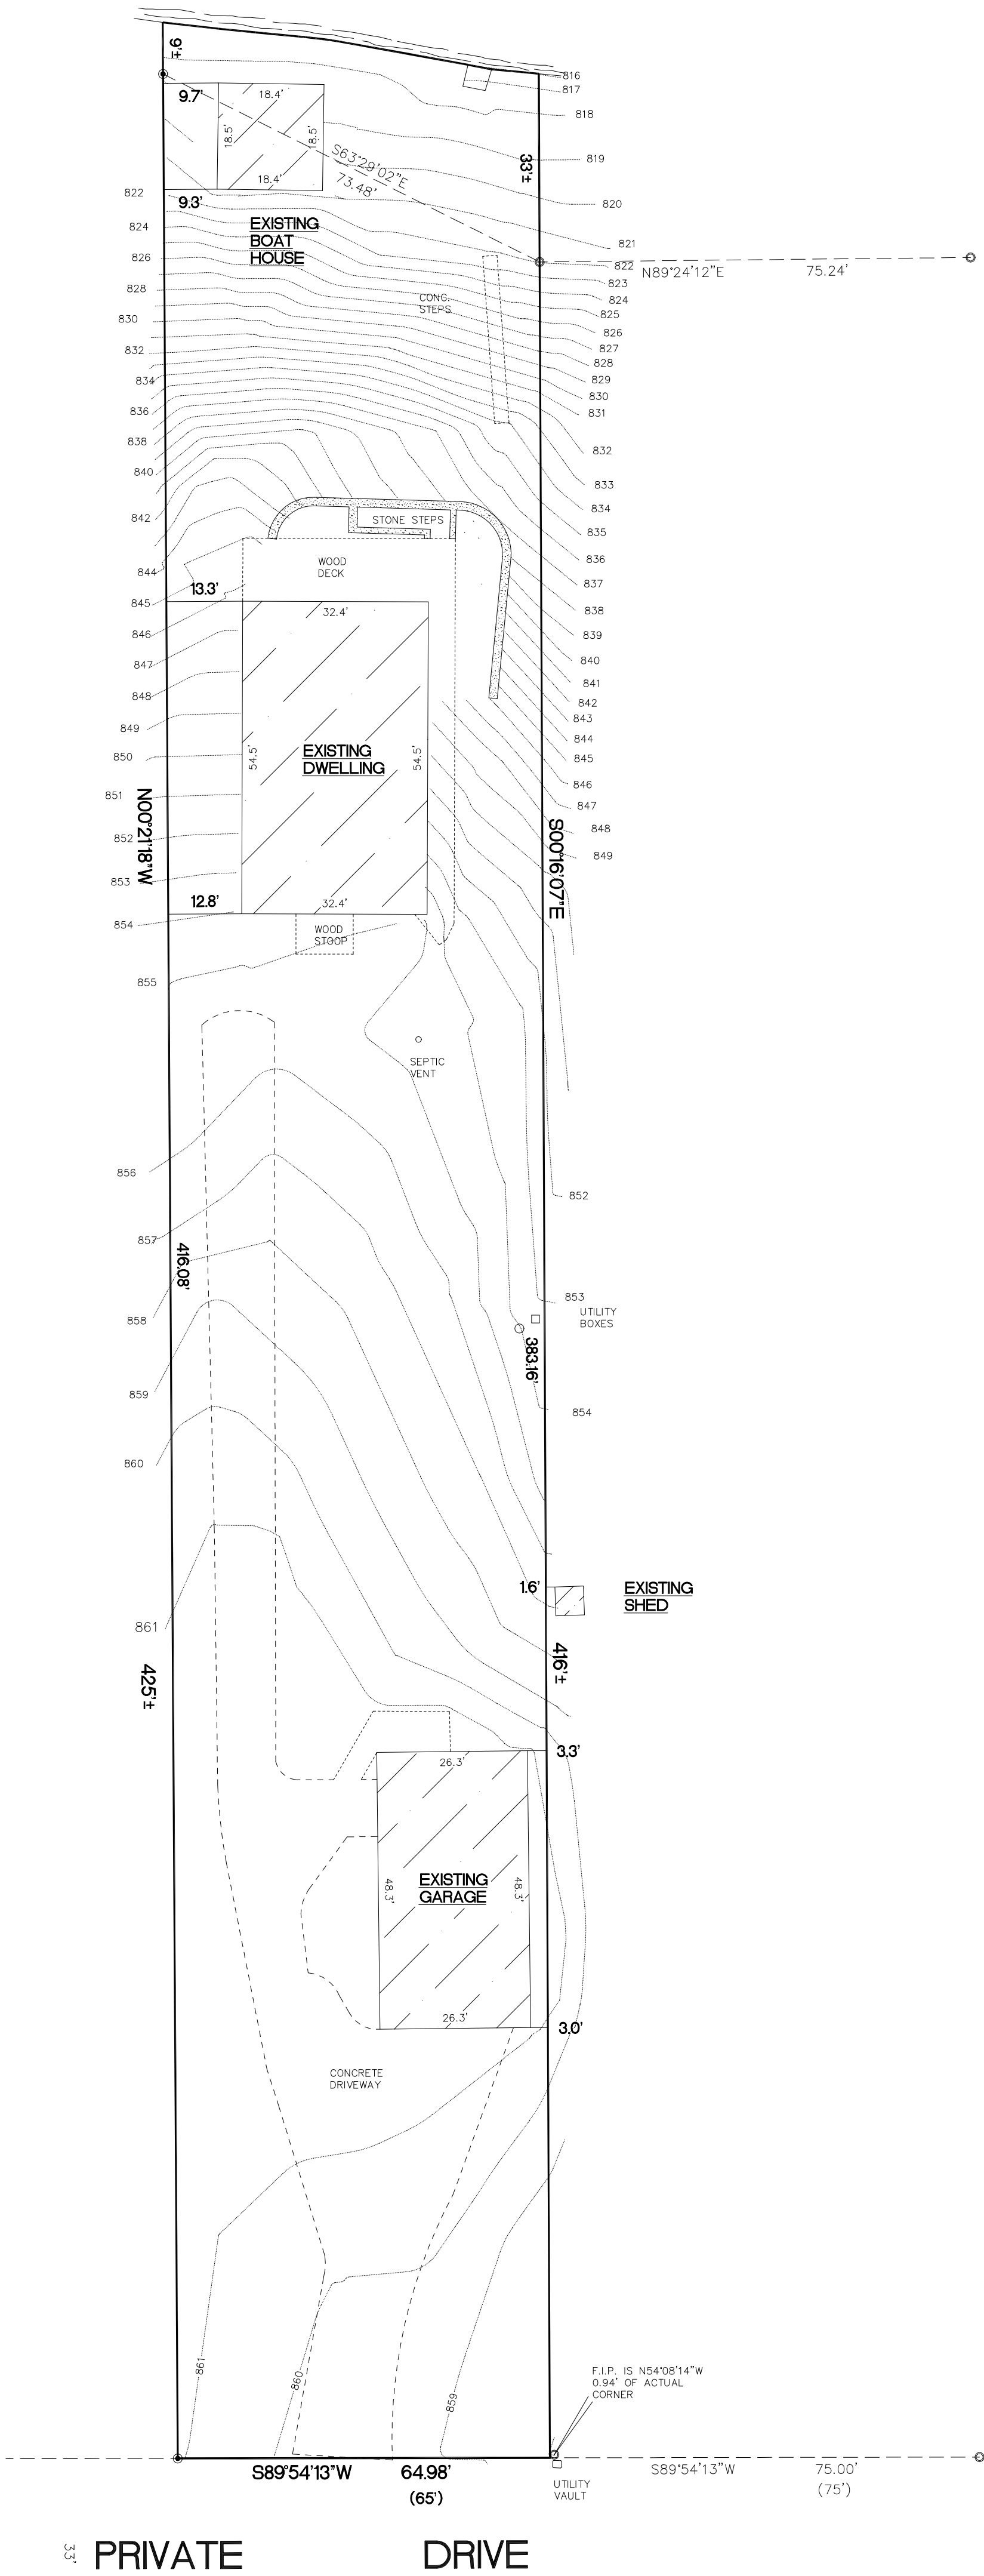

- FOUND 1 1/4" O.D IRON PIPE
- FOUND 1" O.D IRON PIPE
- () RECORDED AS DIMENSIONS

EXISTING IMPERVIOUS SURFACES
EXISTING DWELLING FOOTPRINT: 1766 SQ. FT.
EXISTING GARAGE FOOTPRINT: 1270 SQ. FT.
EXISTING BOAT HOUSE FOOTPRINT: 340 SQ. FT.
CONCRETE: 4289 SQ. FT.
WOOD DECK AND STOOP: 761 SQ. FT.
EXISTING BLOCK WALLS AND STEPS: 201 SQ. FT.
TOTAL: 8627 SQ. FT.
LOT AREA: 27476± SQ. FT.
DENSITY: 31.4%

"I hereby certify that I have surveyed the above property and that the above map is a true representation thereof and shows the size and location of the property, its exterior boundaries, the location of all visible structures and dimensions of all principal buildings thereon, boundary fences, apparent easements, roadway and encroachments if any."
"This survey is made for the use of the present owners of the property, and also those who purchase, mortgage or guarantee the title thereto within one year from date hereof."

Kettle Moraine Surveying Inc.
P.O. Box 357
Eagle WI 53119
(262)594-3484



THIS IS NOT AN ORIGINAL SURVEY UNLESS

7/13/2026
DATE

TEP
FIELD WORK BY

TEP
DRAWN BY

26035
JOB NUMBER