
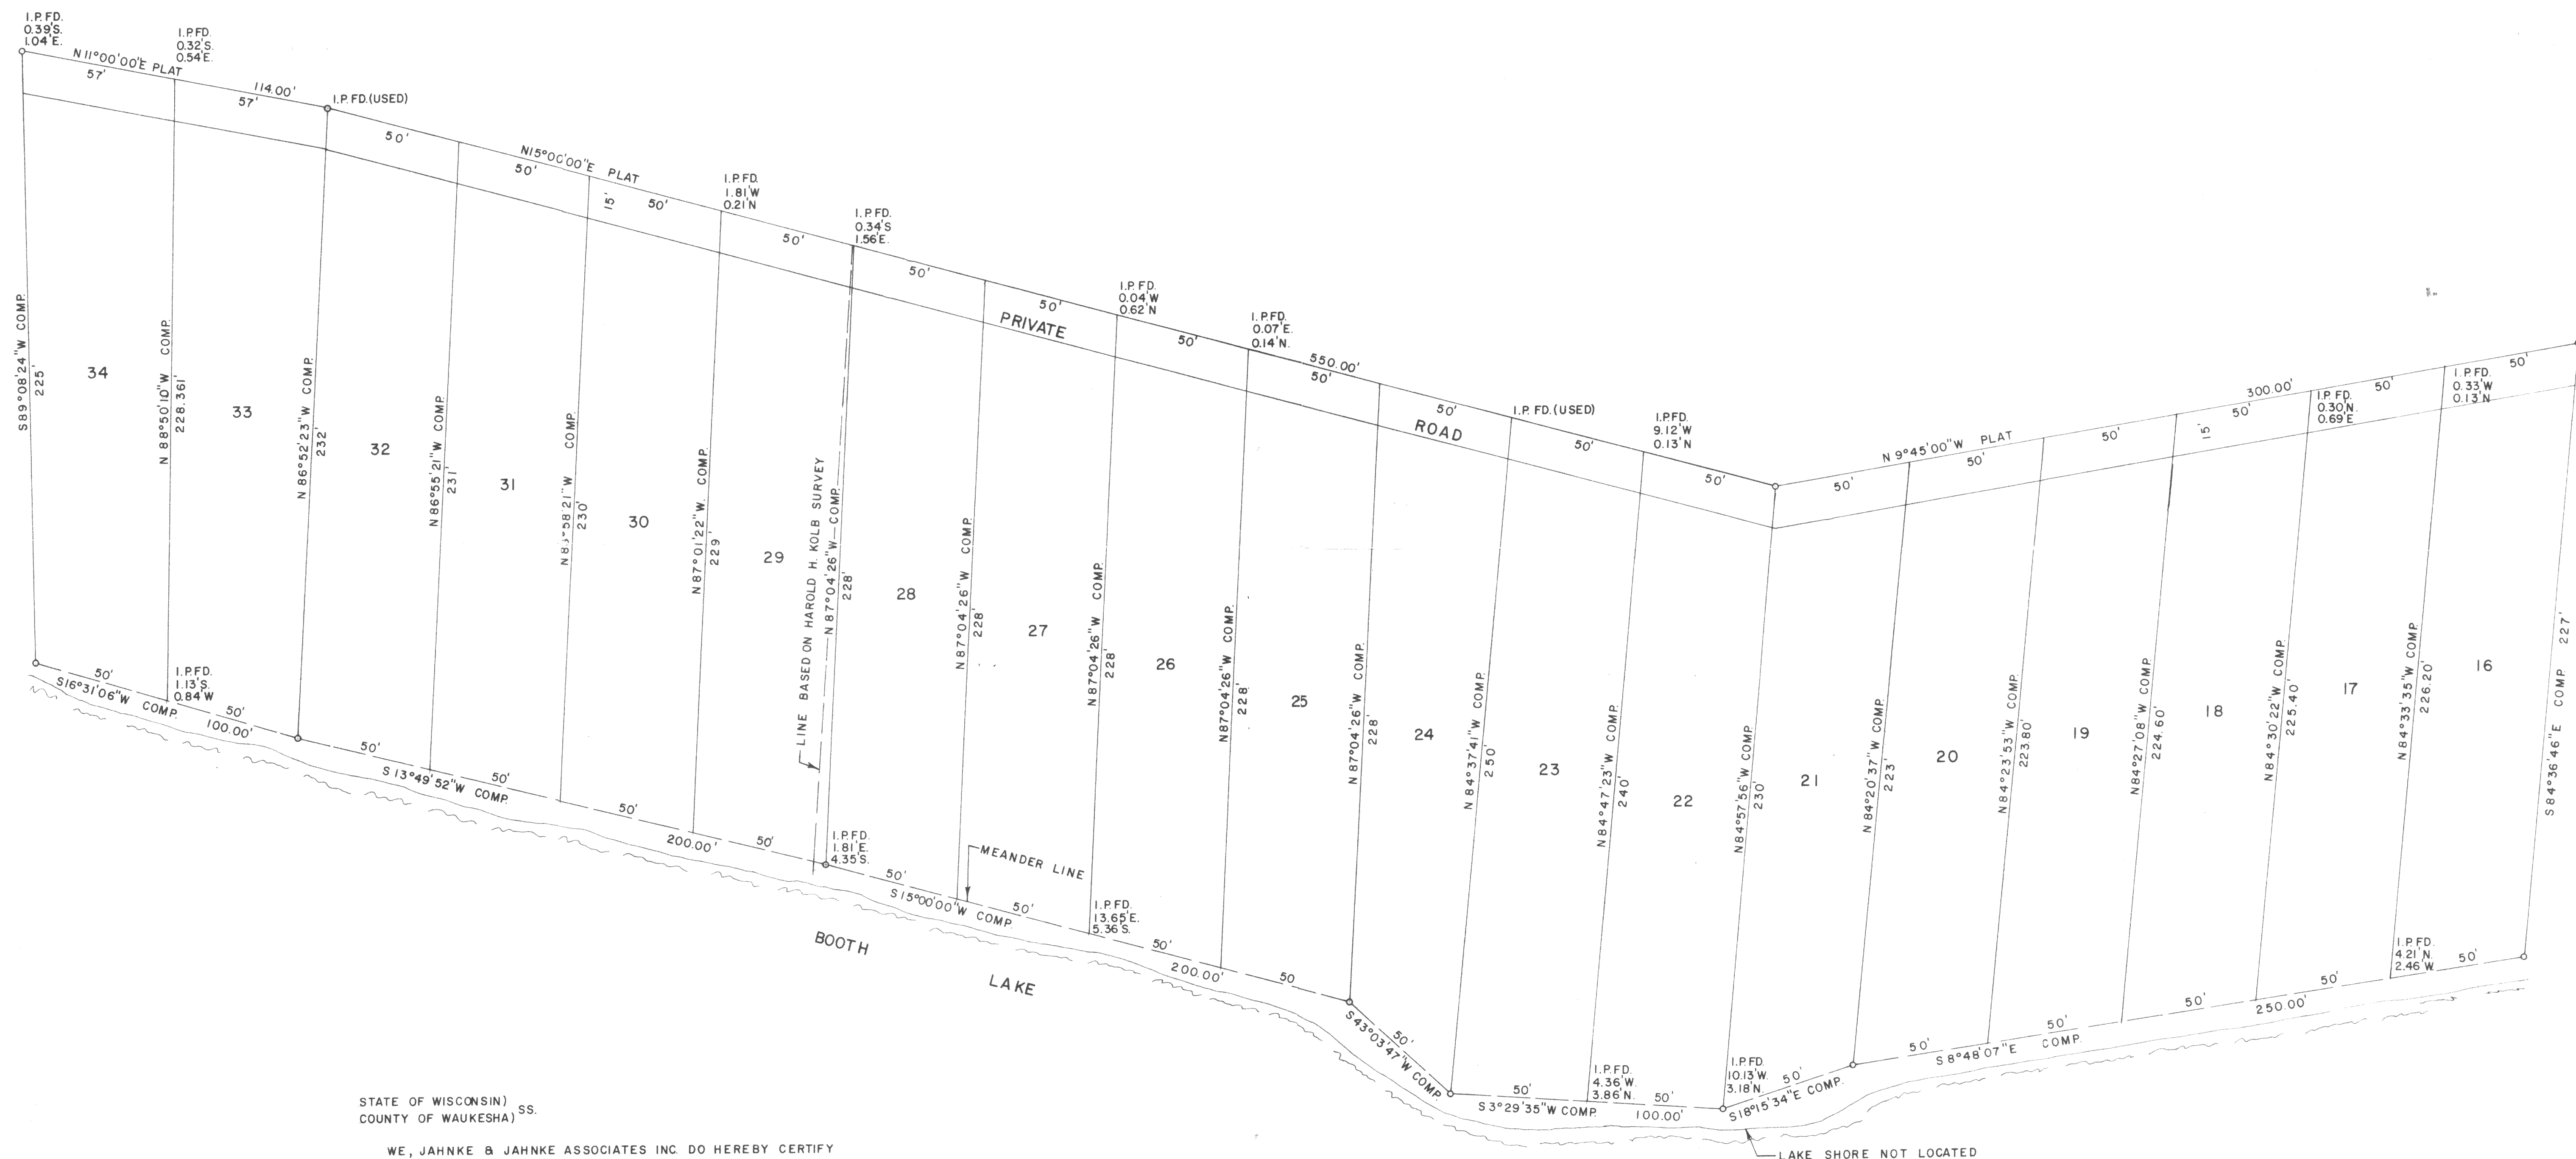


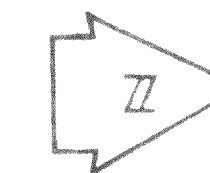


STATE OF WISCONSIN) SS.
COUNTY OF WAUKESHA)

WE, JAHNKE & JAHNKE ASSOCIATES INC. DO HEREBY CERTIFY
THAT WE HAVE MADE THIS SURVEY AND THAT THE INFORMATION AS
SHOWN ON THE ABOVE PLAT OF SURVEY IS A TRUE AND CORRECT
REPRESENTATION THEREOF.

DATED THIS 8TH DAY OF SEPTEMBER, 1977

John W. Jahnke
JOHN W. JAHNKE, WIS. REG. NO. S-917

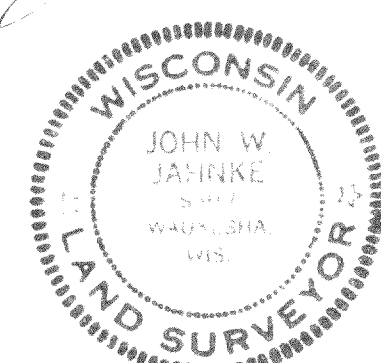

LEGEND

N87°04'26"W COMP. — COMPUTED BEARING BASED ON RECORDED PLAT
I.P.F.D. — IRON PIPE FOUND

PLAT OF SURVEY: LOTS 16 THRU 34
BOOTH LAKE HEIGHTS
PART OF SECTIONS 13 & 24, T4N, R17E
TOWN OF TROY, WALWORTH COUNTY, WIS.

JAHNKE & JAHNKE ASSOCIATES INC.
PLANNERS & PROFESSIONAL ENGINEERS
WAUKESHA — WISCONSIN

SCALE: 1" = 30'
DATE: SEPTEMBER 8, 1977
DRAWN BY: D.W.H. CHECKED BY: J.W.J. FILE NO.: WALWORTH CO. 4
BOOK NO. WALW CO. 2 JOB S-1206 SHEET 1 OF 1