


HAROLD H. KOLB

REGISTERED PROFESSIONAL LAND SURVEYOR
LAKE GENEVA, WISCONSIN

SUNSET ROAD 66' WIDE

BENCHMARK TOP IRON PIPE.
ELEV. ASSUMED 100.00'

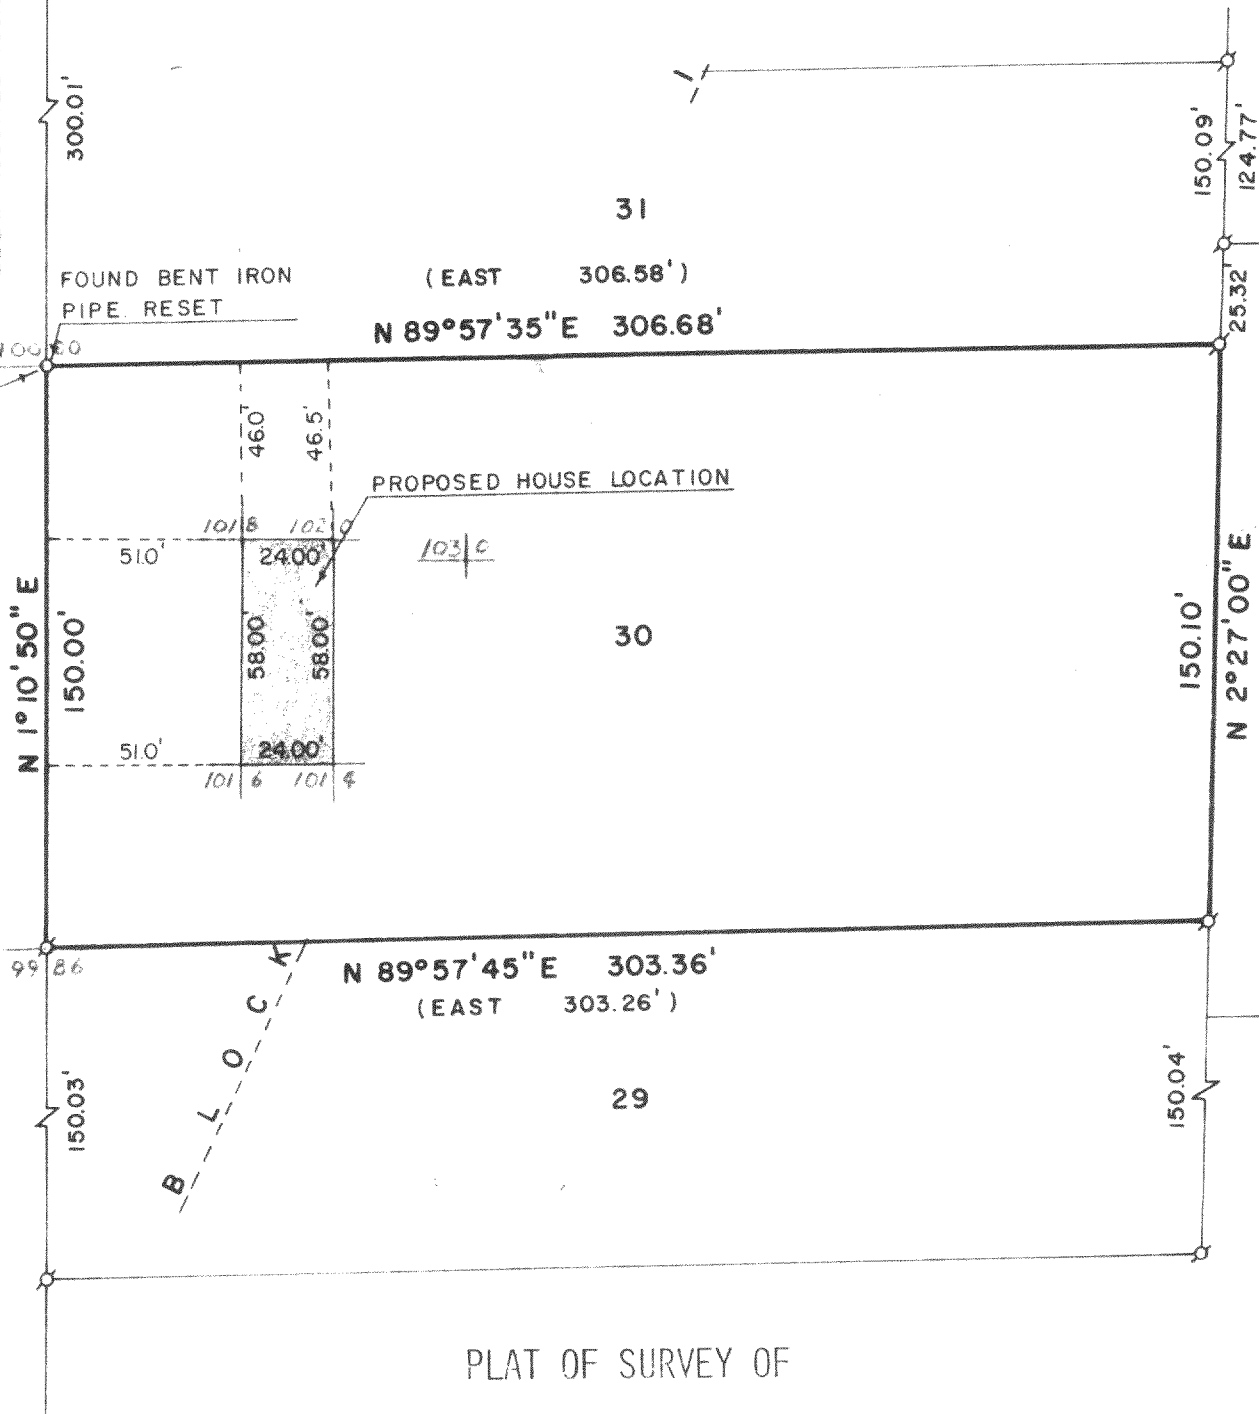

PLAT OF SURVEY OF

LOT 30, BLOCK 1, KETTLE MORaine ESTATES,
SECTION 4, T4 N, R 17 E, WALWORTH
COUNTY, WISCONSIN.

NOTE: 60 PENNY SPIKES WERE SET AT ALL
HOUSE CORNERS.

ORDERED BY: ROBERT O. SIMONSON REALTY

N



SCALE: 1" = 50'

LEGEND

- ⊗ - IRON PIPE FOUND
- - IRON PIPE PLACED
- () - AS PLATTED

I, A. DAVID JOHNSON, DO HEREBY CERTIFY THAT I
HAVE SURVEYED THE PROPERTY HEREON DESCRIBED
ACCORDING TO THE OFFICIAL RECORDS, AND THAT
THE PLAT HEREON IS A CORRECT REPRESENTATION
OF THE LOT LINES.

A. David Johnson

A. DAVID JOHNSON
WISCONSIN REGISTERED LAND SURVEYOR, S-1132
DATE MAY 10, 1977

417-139