


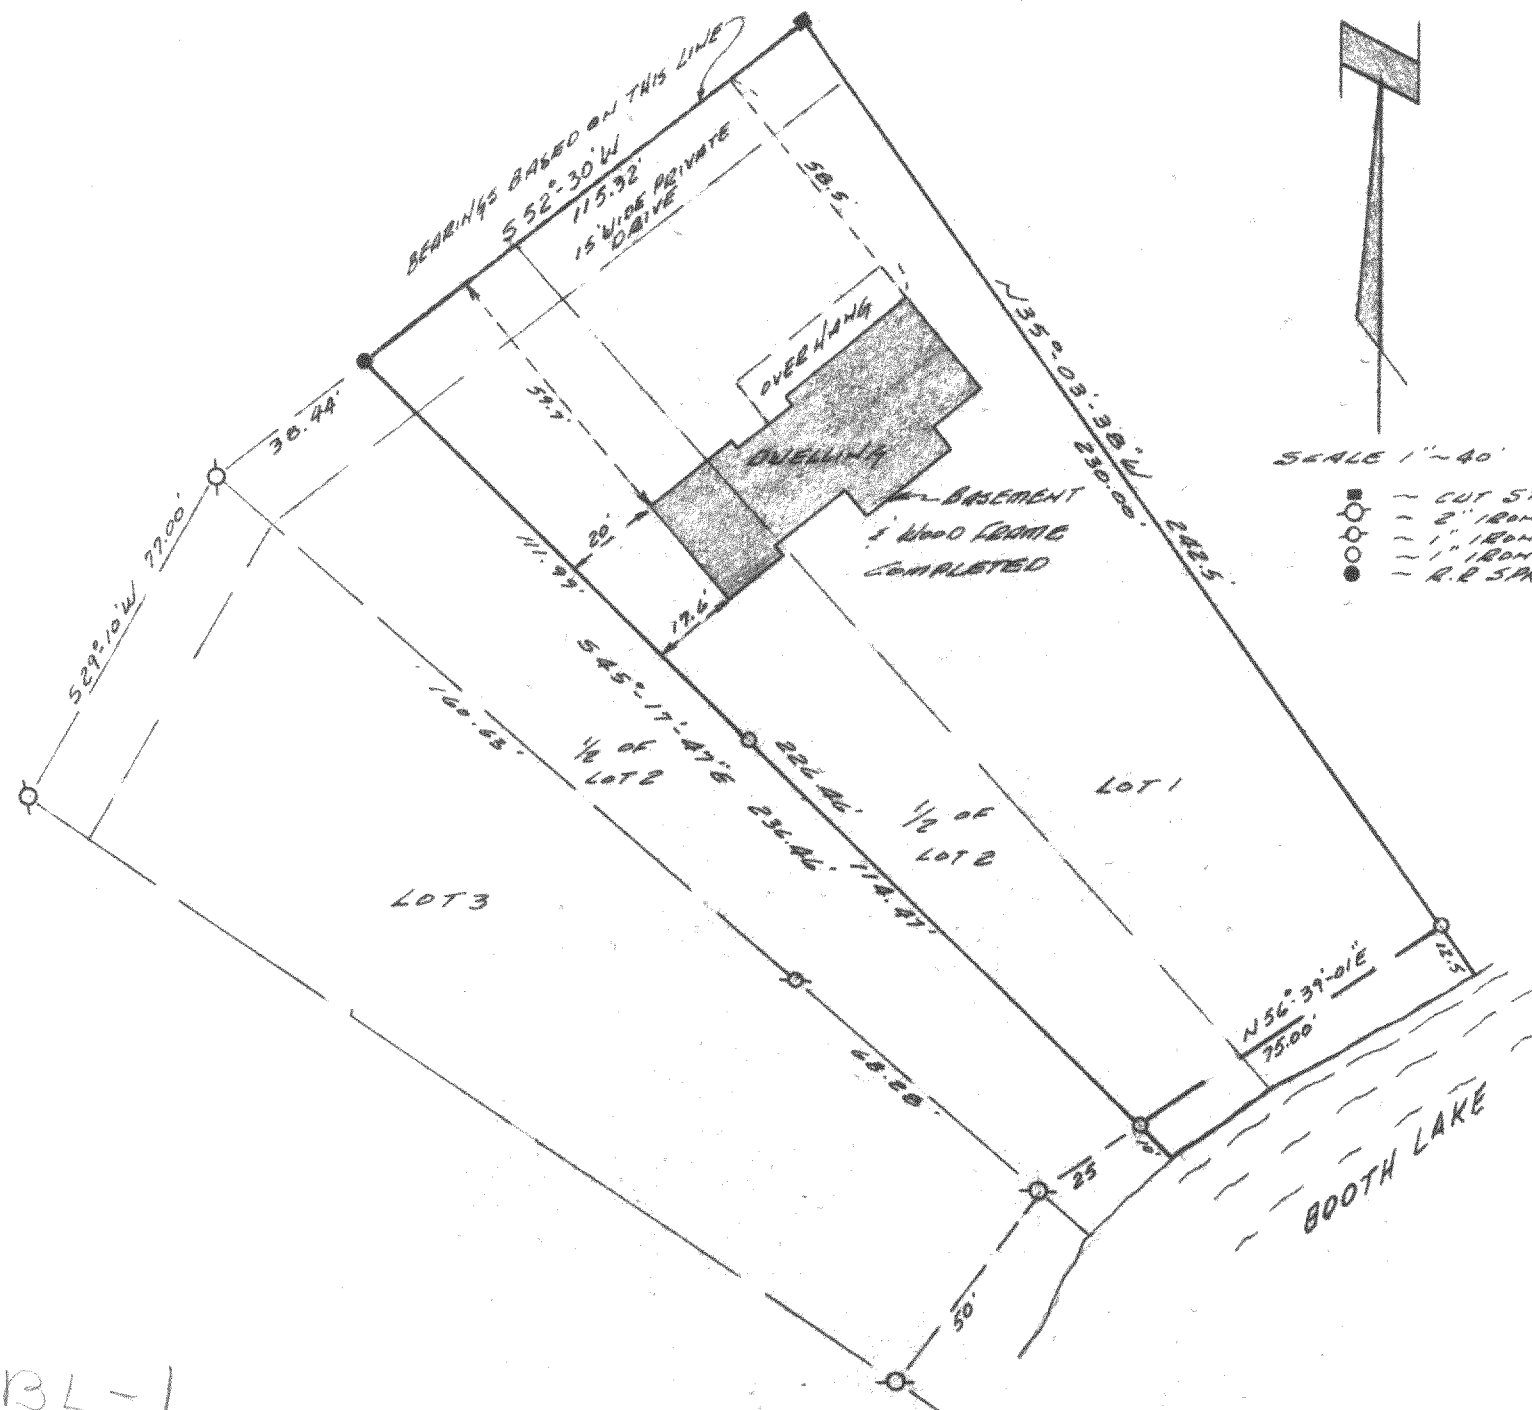


PLAT OF SURVEY OF Lot 1 and 1/2 of Lot 2
Booth Lake Heights, located in Section
13 and Section 24, T4N R17E, Walworth
County, Wisconsin

I certify that I have surveyed the
above described property and that the
plat shown hereon is an accurate survey
and a true representation thereof and
correctly shows the boundary lines and
divisions of said property and all
buildings thereon.

Jan. 9, 1978

Thomas P. A. Jensen
THOMAS P. A. JENSEN

JENSEN SURVEYING & MAPPING
ELKHORN, WISCONSIN

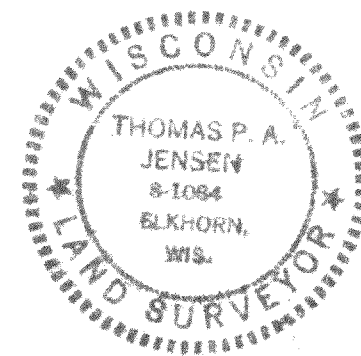

Surveyed for: M. J. Leutenegger
Court House
Elkhorn, Wisconsin

P.O. 1977:059

417-140

LBL-1