


## Plat of Surney

KNOWN AS SCOUT ROAD, IN THE COUNTY OF WALWORTH, WISCONSIN  
LOT 5 IN BLOCK 1 IN KETTLE MORaine ESTATES, BEING A SUBDIVISION OF A PART OF THE NW 1/4 OF THE NW 1/4 AND  
THE SW 1/4 OF THE NW 1/4 OF SECTION 4, T 4 N, R 17 E, IN WALWORTH COUNTY, WISCONSIN.


MARCH 31, 1978

SURVEY NO. 141135-M

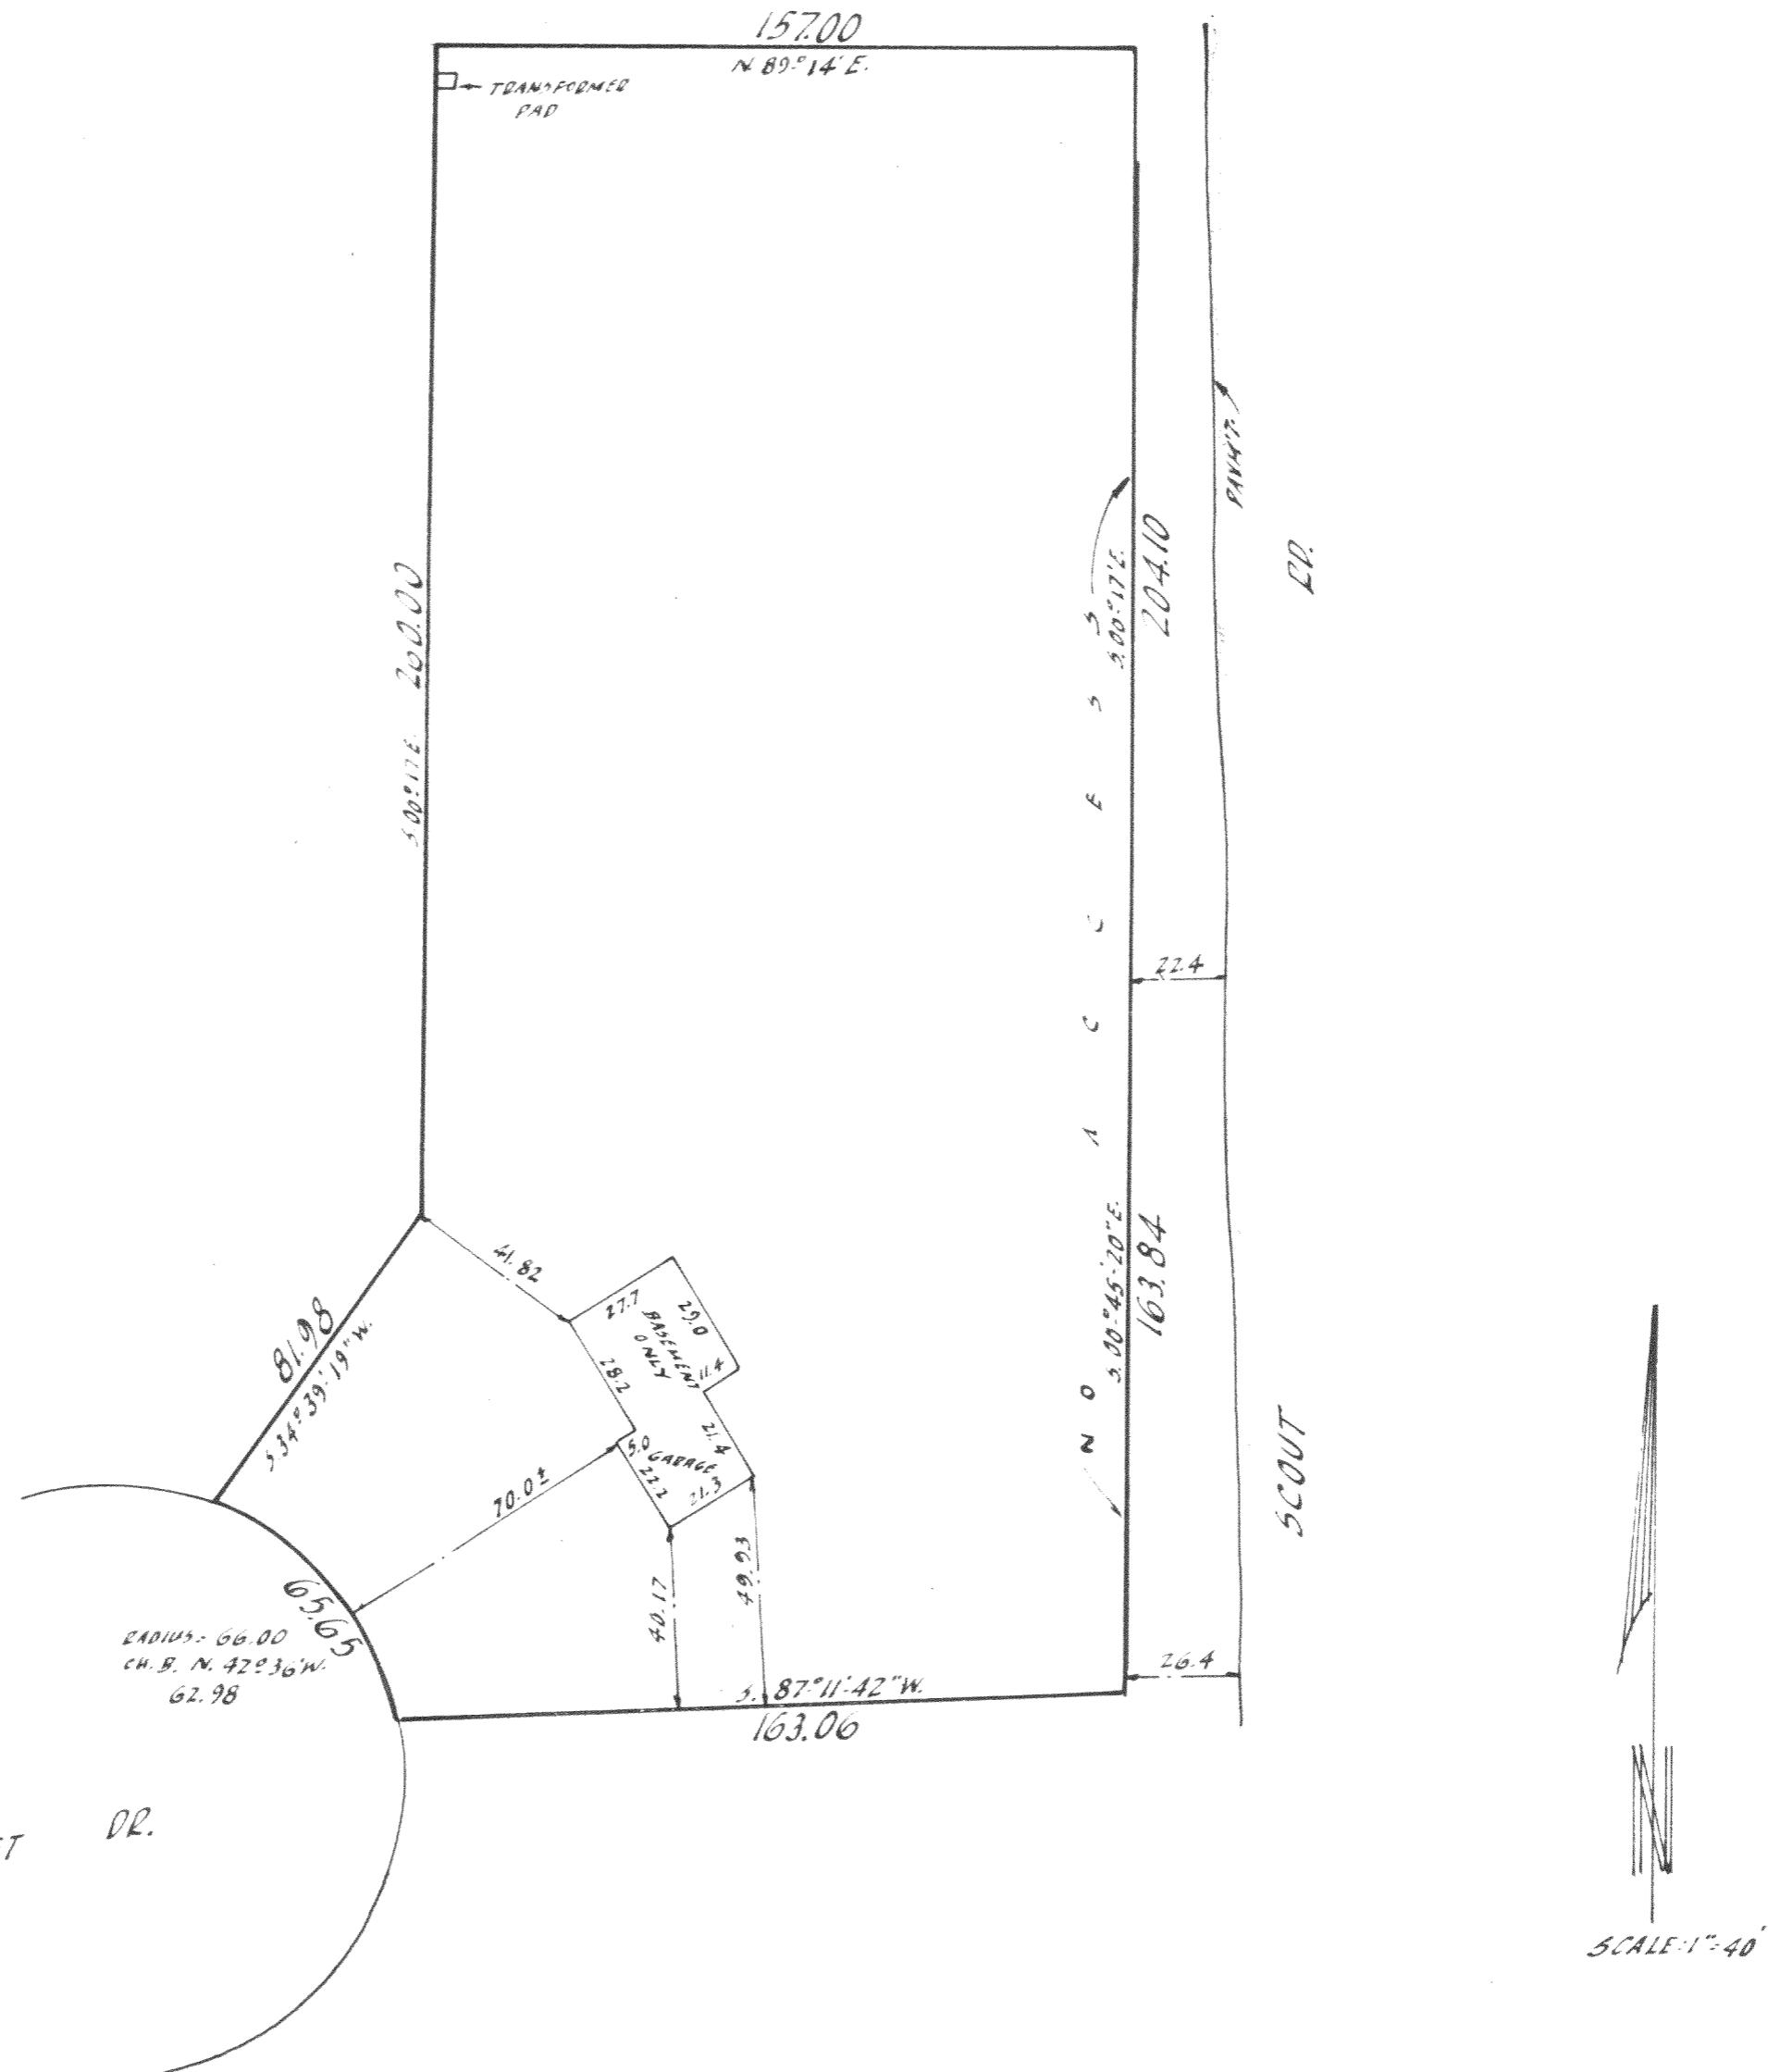

I Certify that I have surveyed the above described property (Property), and the above map is a true representation thereof and shows the size and location of the Property, its exterior boundaries, the location and dimensions of all visible structures thereon, boundary fences, apparent easements and roadways and visible encroachments, if any.

This survey is made for the exclusive use of the present owners of the Property, and also those who purchase, mortgage, or guarantee the title thereto, within one (1) year from the date of this survey.

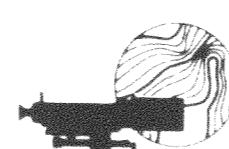


national survey & engineering

3470 north 127th street • p.o. box 444 • brookfield, wisconsin 53005 • phone 414 / 781-1000

Kenneth E. Burke

1000

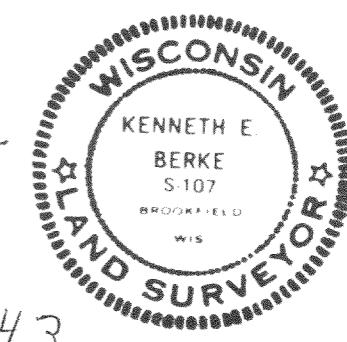

417-143