


Location of the proposed residence on Lot 2 of Certified Survey Map No. 883

FARRIS, HANSEN & COOPER, INC.



ENGINEERING, SURVEYING AND LAND PLANNING
715 W. WALWORTH ST. - P.O. BOX 487 - ELKHORN, WI 53121

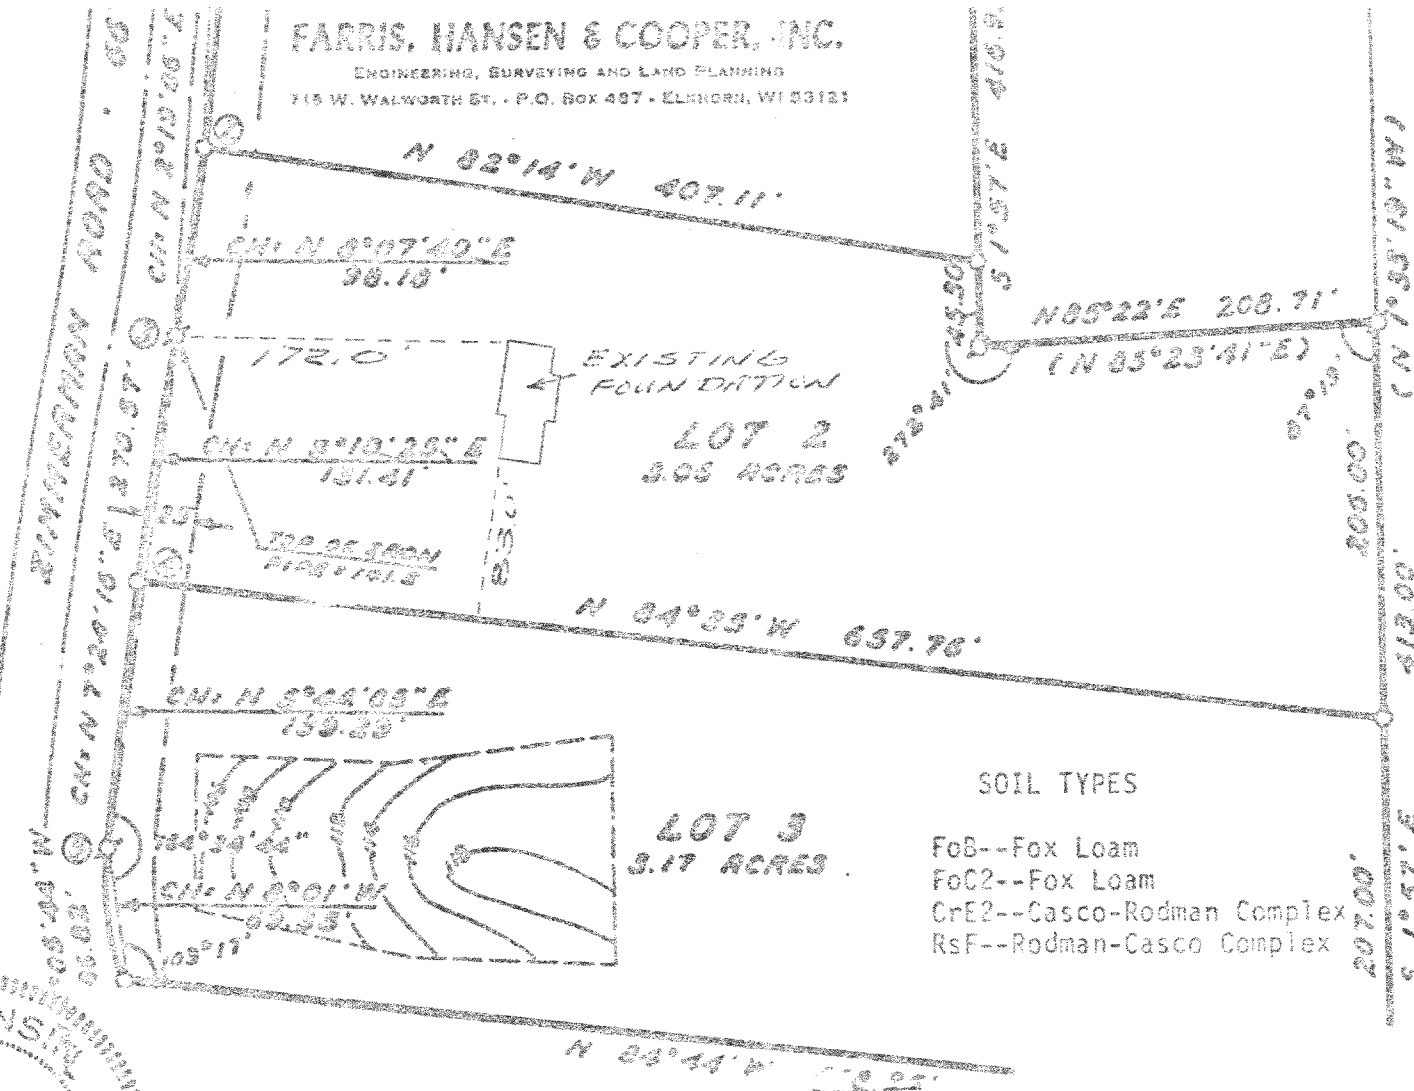

SCALE 1" = 100'

o Indicates Iron Pipe

Work ordered by:
Greenwald Builders

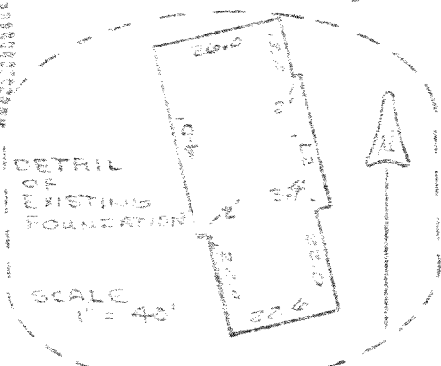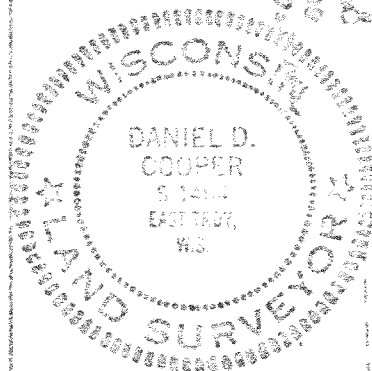

I HEREBY CERTIFY that this map is a true representation of the lot lines and the EXISTING FOUNDATION location to the best of knowledge and belief.

Dated this 15 day of July, 1979

Daniel D. Cooper
Daniel D. Cooper
Wis. Registered Land Surveyor
No. S-1464

28-2-883 (proposed)

417-155