


C-851

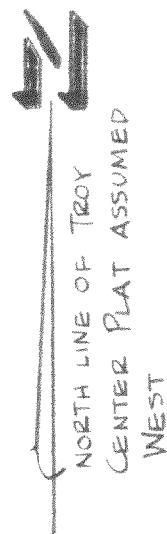


SCALE 1" = 60'

LEGEND

- ~ IRON PIPE FOUND
- ~ IRON ROD SET 3/4" DIA.
- ✱ ~ IRON ROD FOUND

NOTE ~ IRON ROD IS 1.75' WEST OF PROPER LOCATION

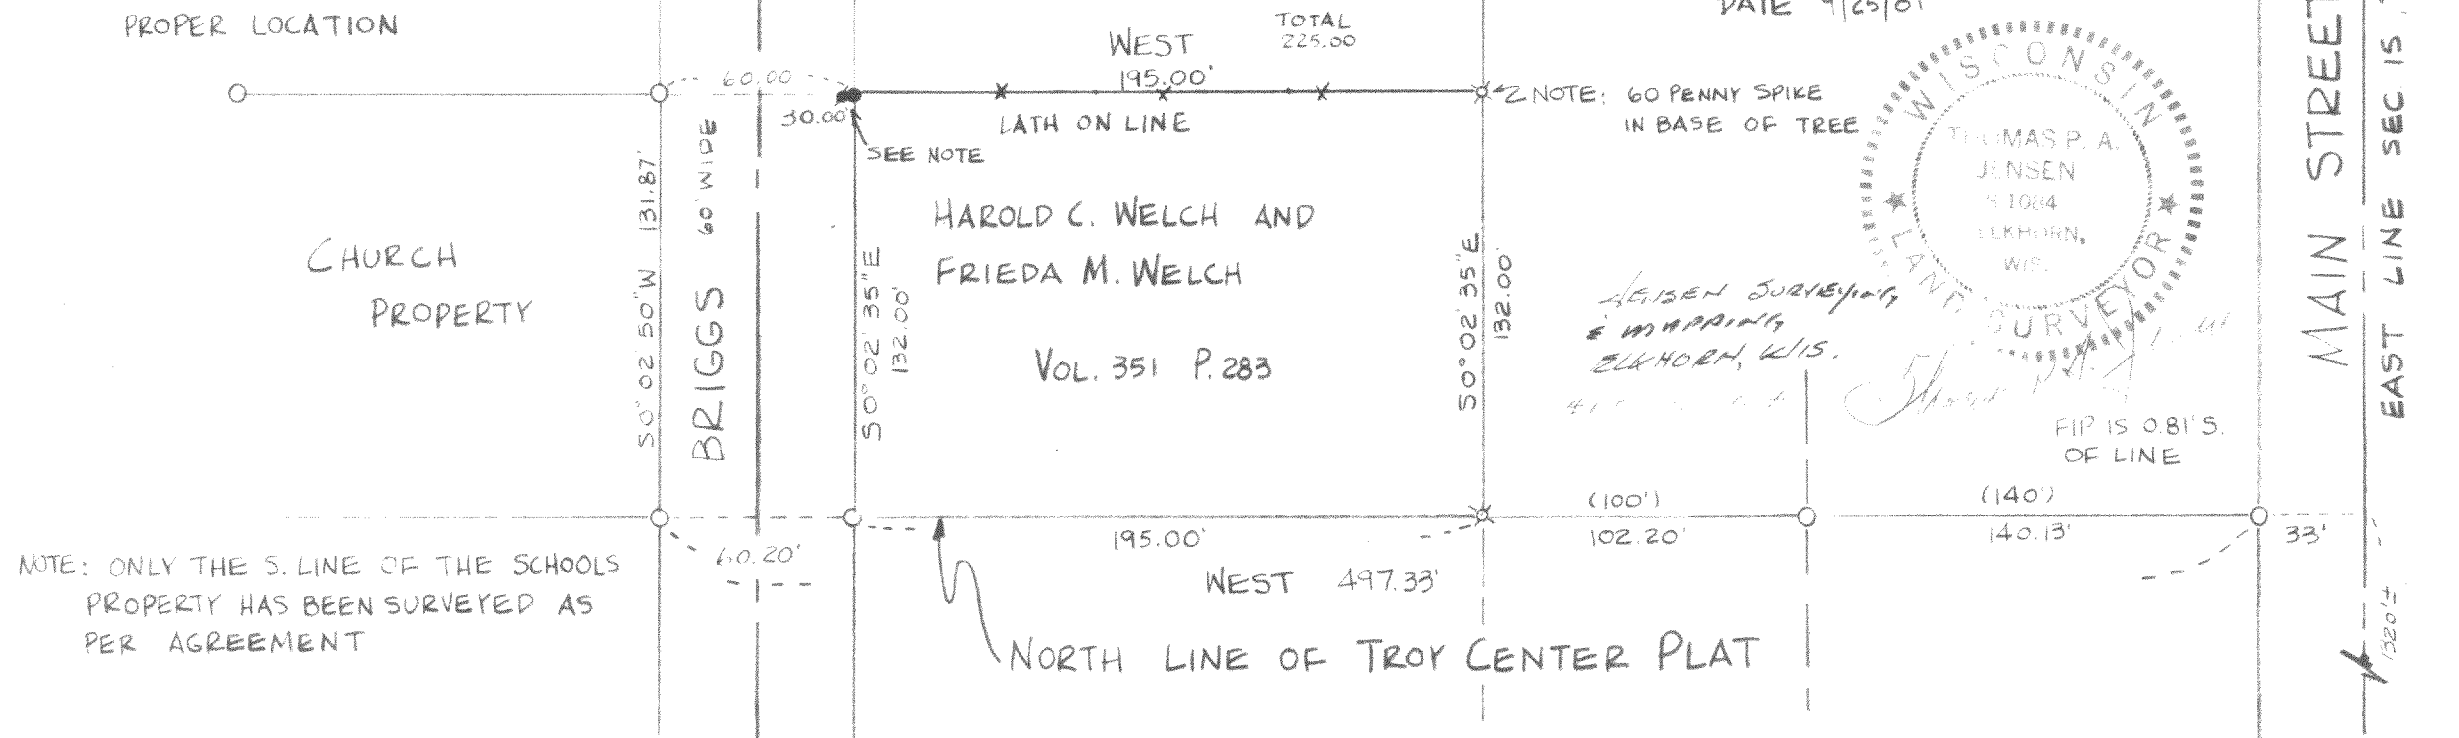


PLAT OF SURVEY

OF THE SOUTH LINE OF SCHOOL DISTRICT NO. 4
LOCATED IN THE NE 1/4 OF SECTION 15, T4N, R17E,
WALWORTH COUNTY, WISCONSIN

I HEREBY CERTIFY THAT THE ABOVE
DESCRIBED PROPERTY HAS BEEN SURVEYED UNDER
MY DIRECTION AND THAT THE PLAT SHOWN
HEREON IS AN ACCURATE SURVEY AND A TRUE
REPRESENTATION THEREOF, AND CORRECTLY
SHOWS THE BOUNDARY LINE OF SAID PROPERTY

DATE 9/25/81

NOTE: 60 PENNY SPIKE
IN BASE OF TREE

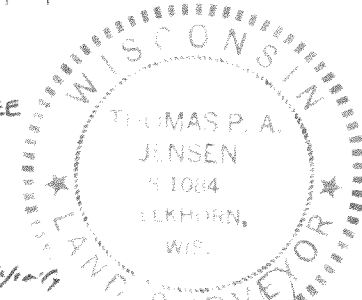

JENSEN SURVEYING,
ELKHORN, WIS.

FIG IS 0.81'S.
OF LINE

NOTE: ONLY THE S. LINE OF THE SCHOOLS
PROPERTY HAS BEEN SURVEYED AS
PER AGREEMENT

LT-15-3A - South line

E 1/4 COR. SEC. 15

417-158 JV

#1981.063