


KOLB LAND CONSULTING, INC.
LAND SURVEYING • SUBDIVIDING • LAND PLANNING

LAKE GENEVA, WISCONSIN 53147

WHITEWATER, WISCONSIN 53190

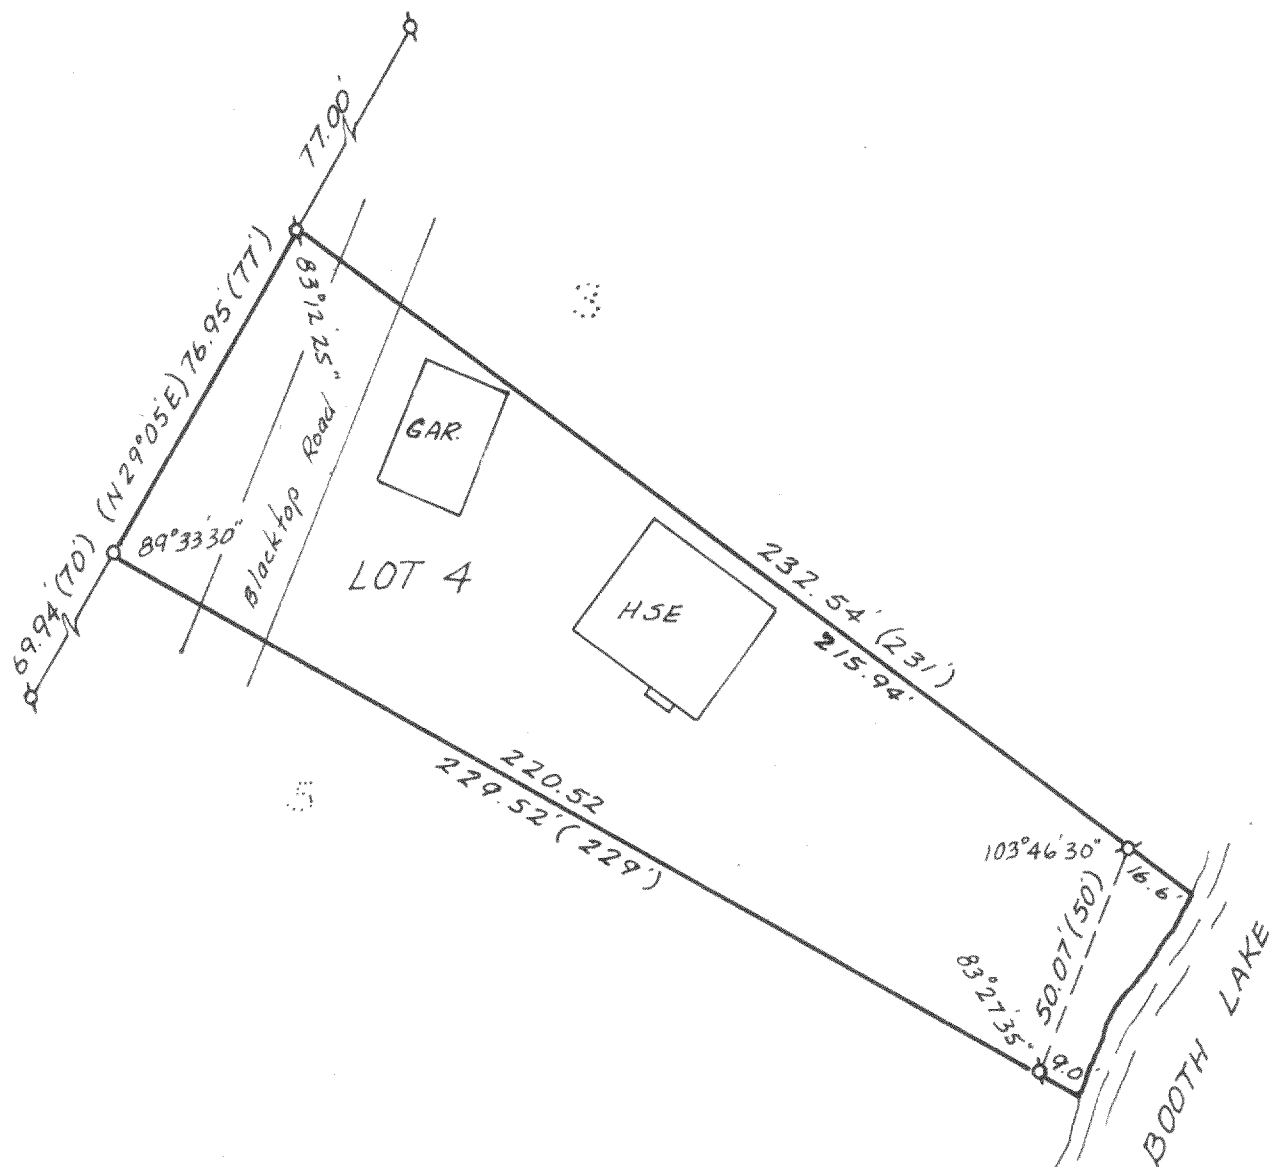

LOT 4, BOOTH LAKE HEIGHTS, TAN, RITE.

N



SCALE - 1" = 40'

Ø - IRON PIPE FOUND

○ - IRON PIPE PLACED

() - RECORDED AS

WISCONSIN REGISTERED LAND SURVEYOR, S

DATE NOV 14, 1979

LBL-3

417-178