

FARRIS, HANSEN & COOPER, INC.

ENGINEERING, SURVEYING & LAND PLANNING

715 W. WALWORTH ST. - BOX 487 - ELKHORN, WI.

PLAT OF SURVEY OF



LOTS 28 AND 30, BLOCK 2 AND LOT 14, BLOCK 4, SWIFT
LAKE SUBDIVISION, SECTION 8, TOWN 4 NORTH, RANGE
17 EAST, TOWN OF TROY, WALWORTH COUNTY, WISCONSIN.

ORDERED BY: John Carney (Lot 30, Block 2)
(Lot 14, Block 4)
Harold Vedder (Lot 28, Block 2)

LEGEND

- Iron Pipe Found
- Iron Rod Found
- 1" x 24" Iron Pipe Set
- ⊙—1-1/4" x 24" Iron Pipe Set
- ()—Record Dimension

0 10 20 30 40 50
SCALE IN FEET
1"=50'

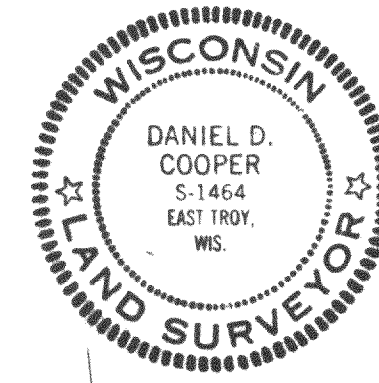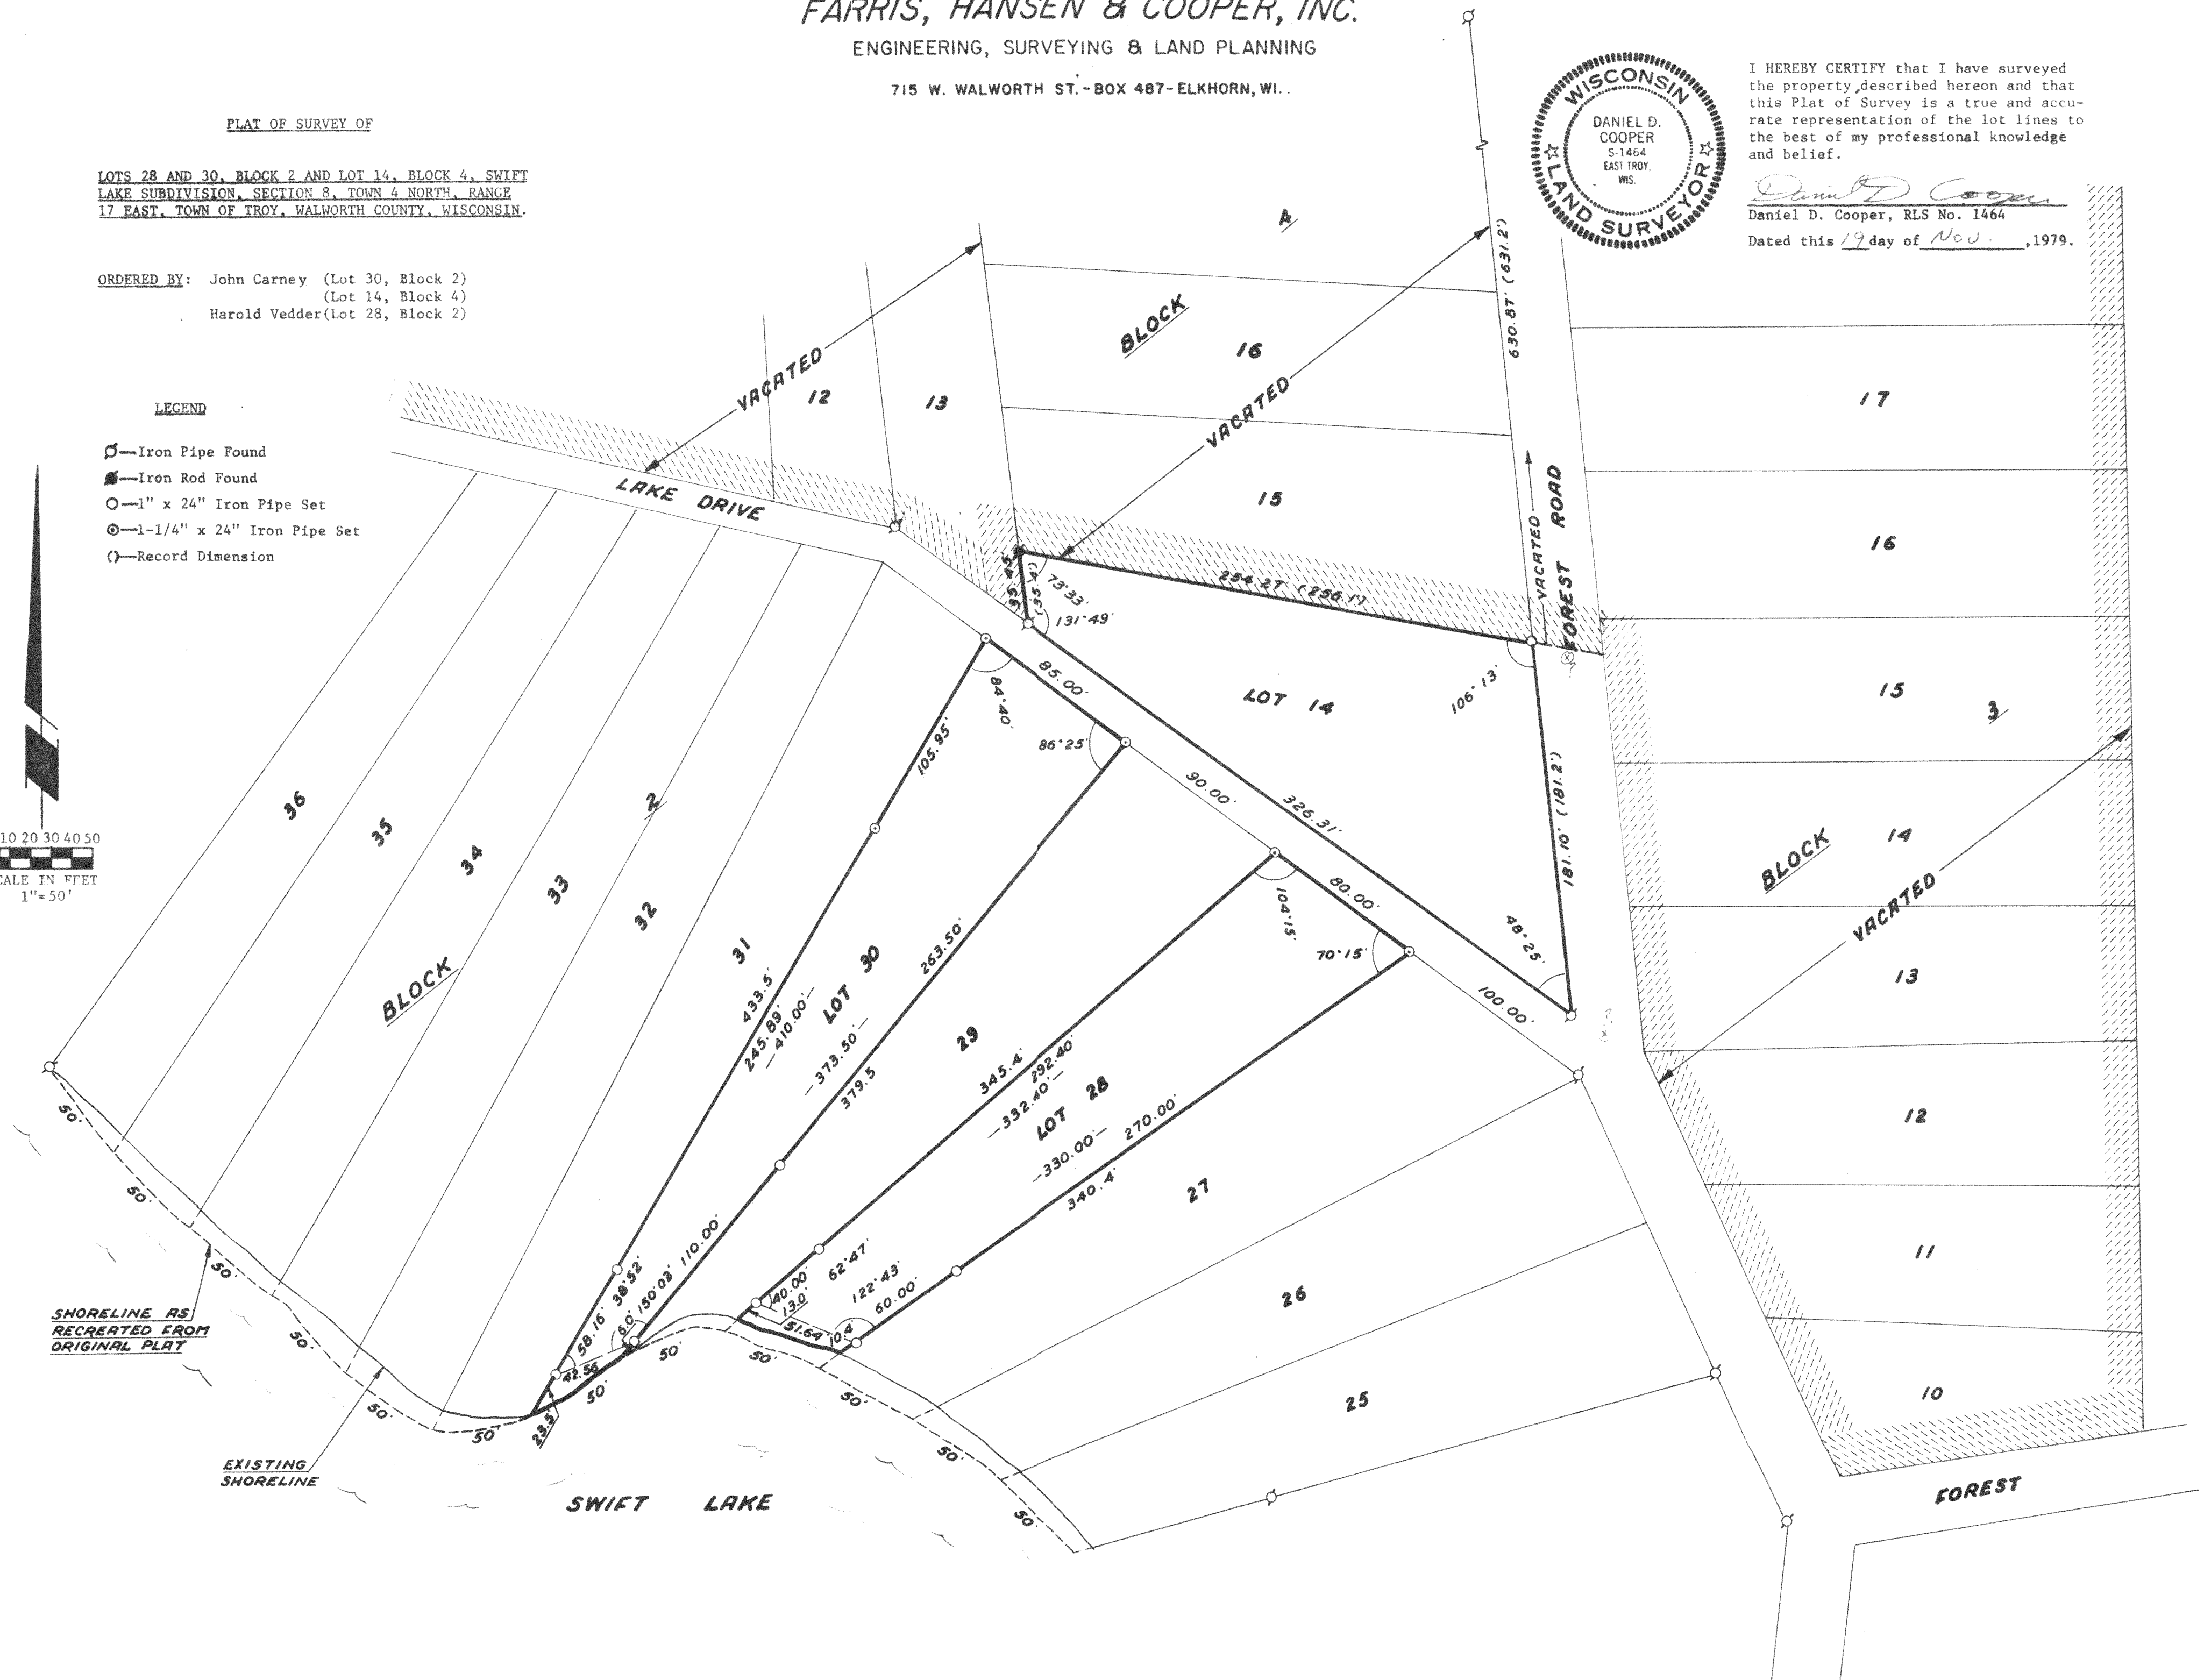

I HEREBY CERTIFY that I have surveyed the property described hereon and that this Plat of Survey is a true and accurate representation of the lot lines to the best of my professional knowledge and belief.

Daniel D. Cooper
Daniel D. Cooper, RLS No. 1464
Dated this 19 day of Nov., 1979.