


WAUKESHA, WISCONSIN

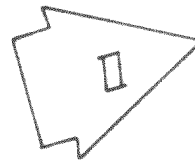


FOR: CARL NEUMANN

LEGAL DESCRIPTION:

Lot 31, Booth Lake Heights, being a subdivision of part of the Southeast Quarter (SE 1/4) and Southwest Quarter (SW 1/4) of Section 13 and part of the Northeast Quarter (NE 1/4) of Section 24, Town 4 North, Range 17 East, Town of Troy, Walworth County, Wisconsin.

SCALE 1" = 30'

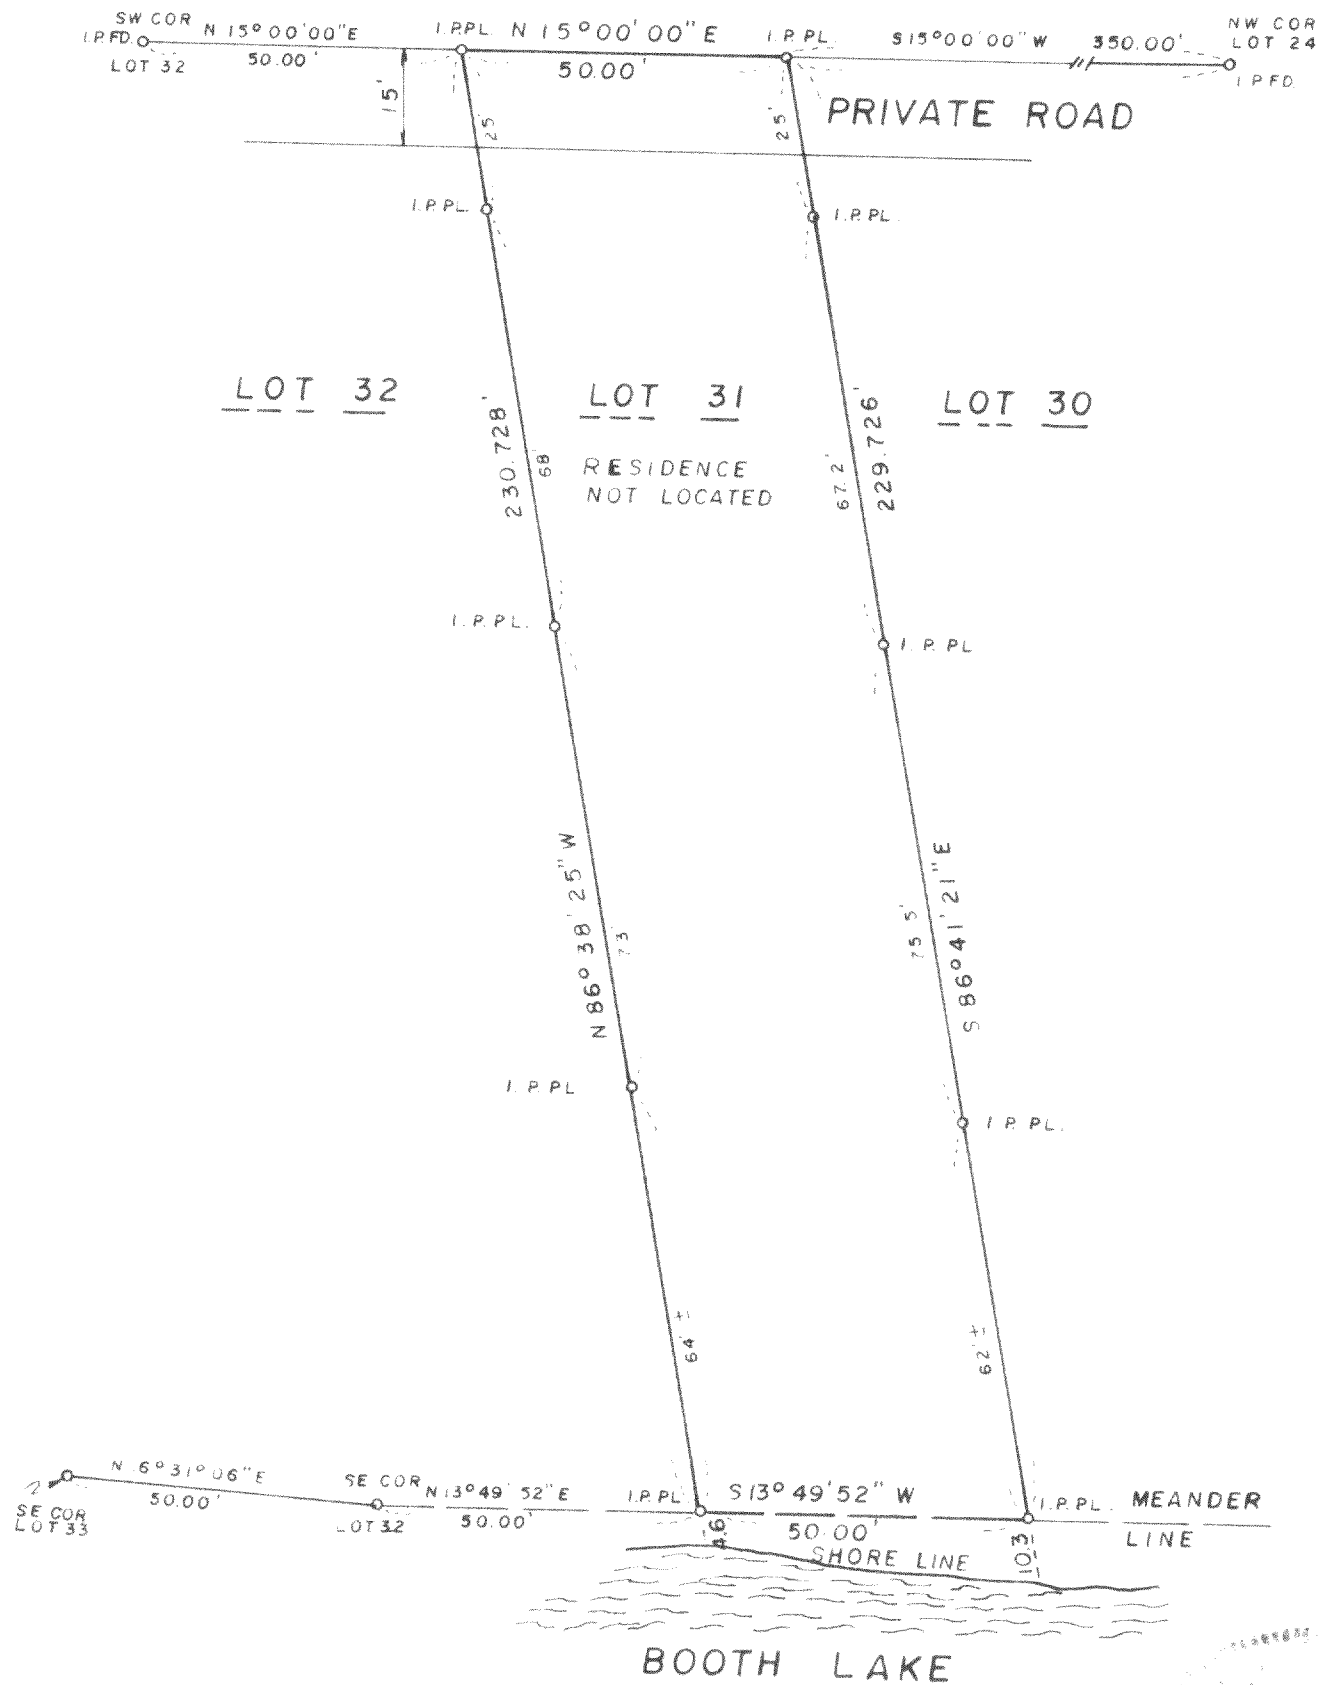

STATE OF WISCONSIN }
COUNTY OF WAUKESHA } SS

WE, JAHNKE & JAHNKE ASSOCIATES INC., DO HEREBY CERTIFY THAT WE HAVE MADE THIS SURVEY AND THAT THE INFORMATION AS SHOWN ON THE ABOVE PLAT OF SURVEY IS A TRUE AND CORRECT REPRESENTATION THEREOF.

DATED THIS 7th DAY OF May 1980

PLAT No P. S. Walworth 113 BOOK _____ PAGE _____

RICHARD P. JOHNSON - Wis. Reg. No. S-318

JOHN W. JAHNKE W. B. No. 3. 51