
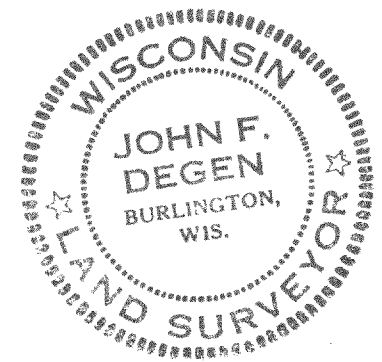


PLAT OF SURVEY
OF
THE NORTH AND WEST LINES OF LOTS 2 & 3, BLOCK 12 OF THE VILLAGE OF TROY CENTER, LOCATED
IN THE NORTHEAST 1/4 OF SECTION 15, T. 4 N., R. 17 E. TOWNSHIP OF TROY, WALWORTH COUNTY, WI.

FOR: CORA HOURKE SCALE 1" = 20'

o = IRON PIPE STAKE SET ♂ = IRON PIPE STAKE FOUND.

■ = CONCRETE MONUMENT SET IN PLACE OF STONE MONUMENTS
PLACED BY CHILDS AT TIME OF 1871 SUBDIVISION OF
TROY CENTER.

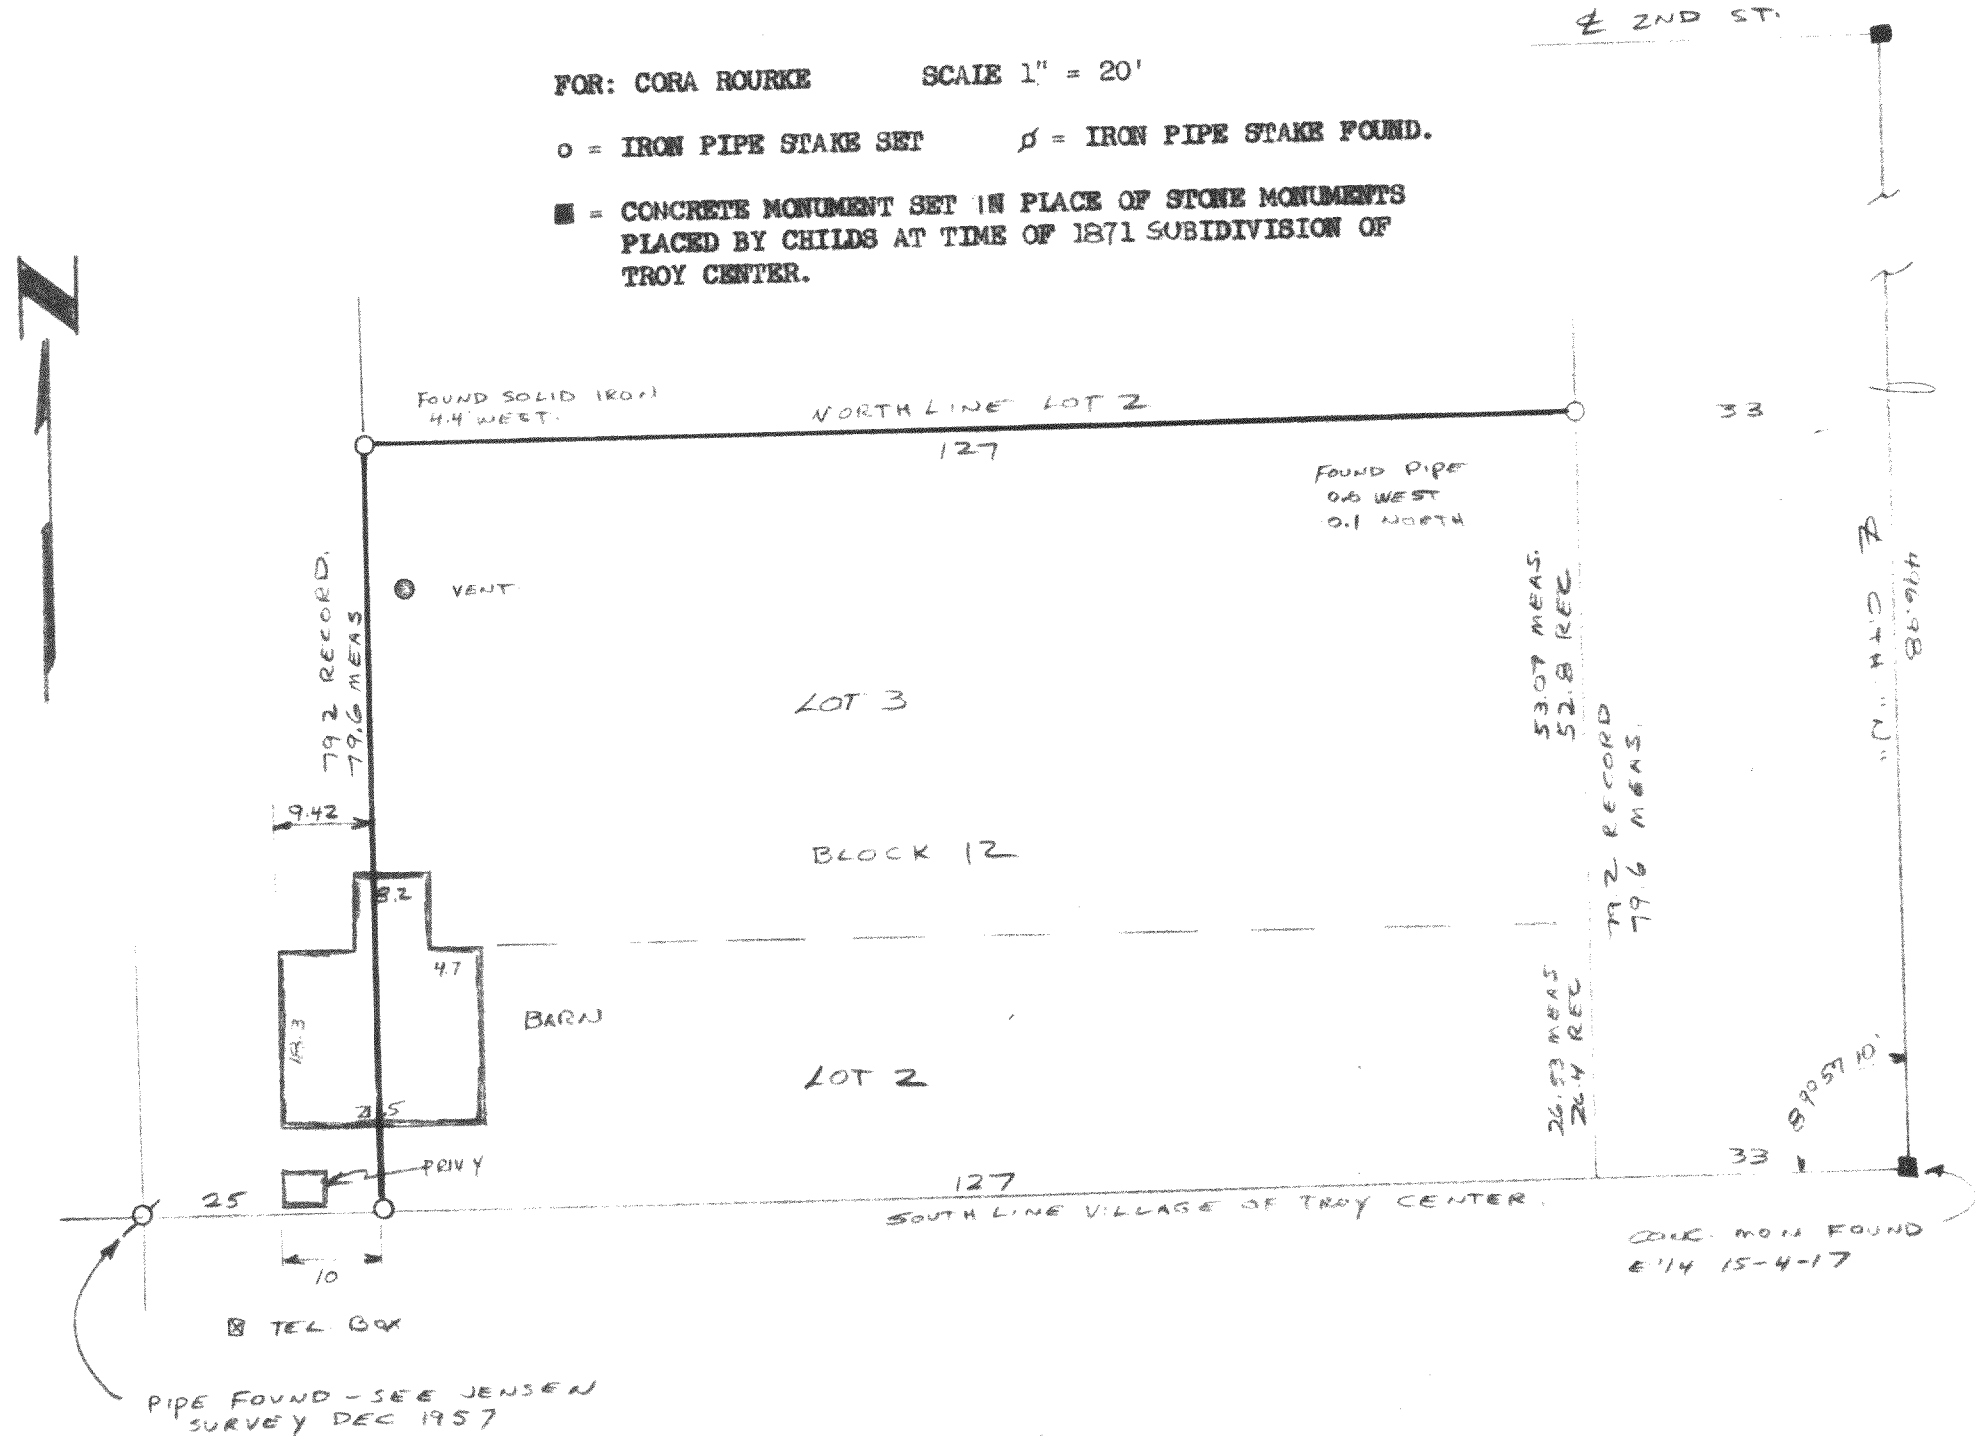

I have surveyed the above described property and the map hereon is a true representation thereof and shows the location of the property, its extent, boundaries, and dimensions, and I have detected no errors or omissions in the same.

I have also surveyed the property of the above described property and the map hereon is a true representation thereof and shows the location of the property, its extent, boundaries, and dimensions, and I have detected no errors or omissions in the same.

John F. Degen, Land Surveyor
Burlington, Wis.
SEPT 83
John F. Degen

14-A #20