



⊙ - INDICATES CONCRETE
MONUMENT

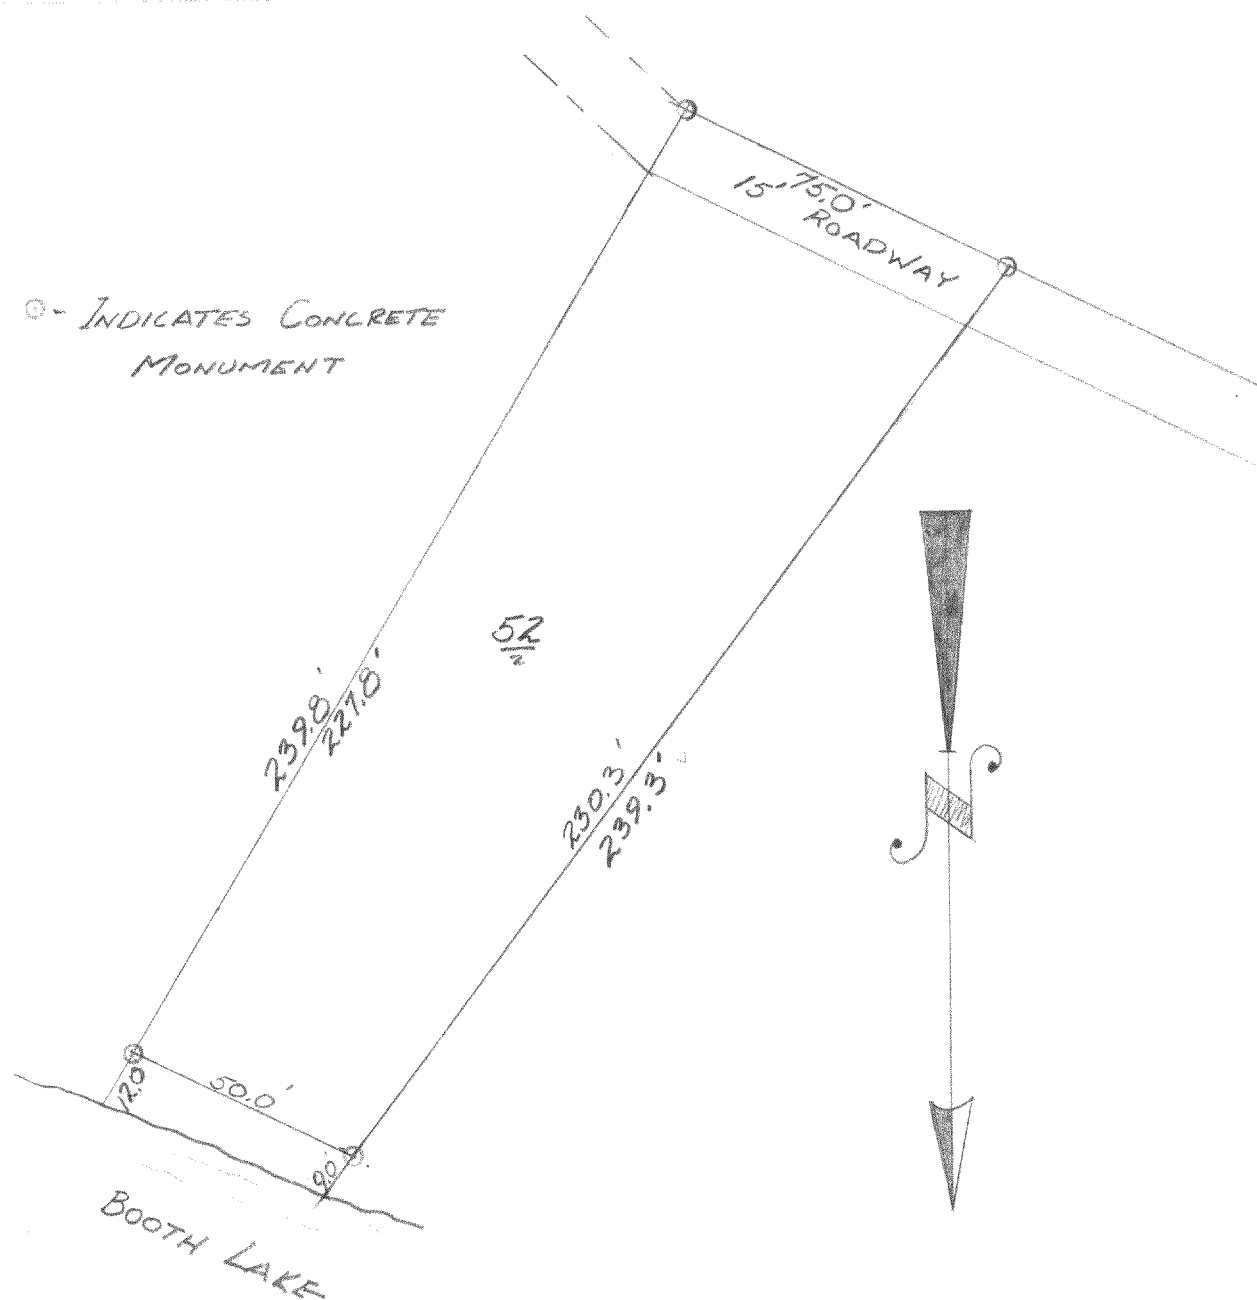

Description: Lot No. 52 of Booth Lakes Heights Subdivision
Located in the Town of Troy, T.4N., R.17E.
Walworth County, Wisconsin

Surveyed this 15th day of September 1959

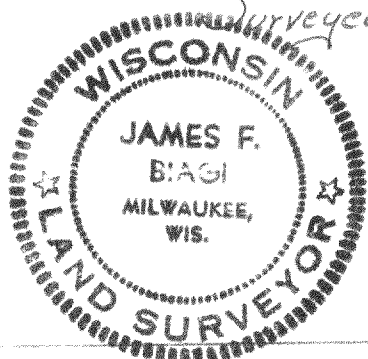

James F. Biagi
(Surveyor No. 272)

417-1B