


PLAT OF SURVEY

FOR: ARTHUR HOCBENBERRY & JOHN BARNES REAL ESTATE
 LOCATION: 1611 SWIFT LAKE RD.
 DESCRIPTION: LOTS 60, 61, 62, & 63, BLOCK 2, SWIFT LAKE
 SUBDIVISION NO. 2, BEING A PART OF THE
 S.W. 1/4 & S.E. 1/4 OF SECTION 8, T. 4 N., R. 17 E.,
 IN THE TOWN OF TROY, WALWORTH CO., WIS.



SURVEY CERTIFICATE:

I, the undersigned, being a duly qualified surveyor of the State of Wisconsin, do hereby certify that I have surveyed the above described property and the above map is a true representation thereof, and shows the size and location of the property, its exterior boundaries, the location and dimensions of all visible structures thereon, fences, apparent easements and roadways, and visible encroachments, if any.
 THIS SURVEY IS MADE FOR THE EXCLUSIVE USE OF THE PRESENT OWNERS OF THE PROPERTY AND ALSO THOSE WHO PURCHASE HEREIN, AND I WARRANT THE TITLE THEREIN, WITHIN ONE (1) YEAR FROM DATE HEREOF.

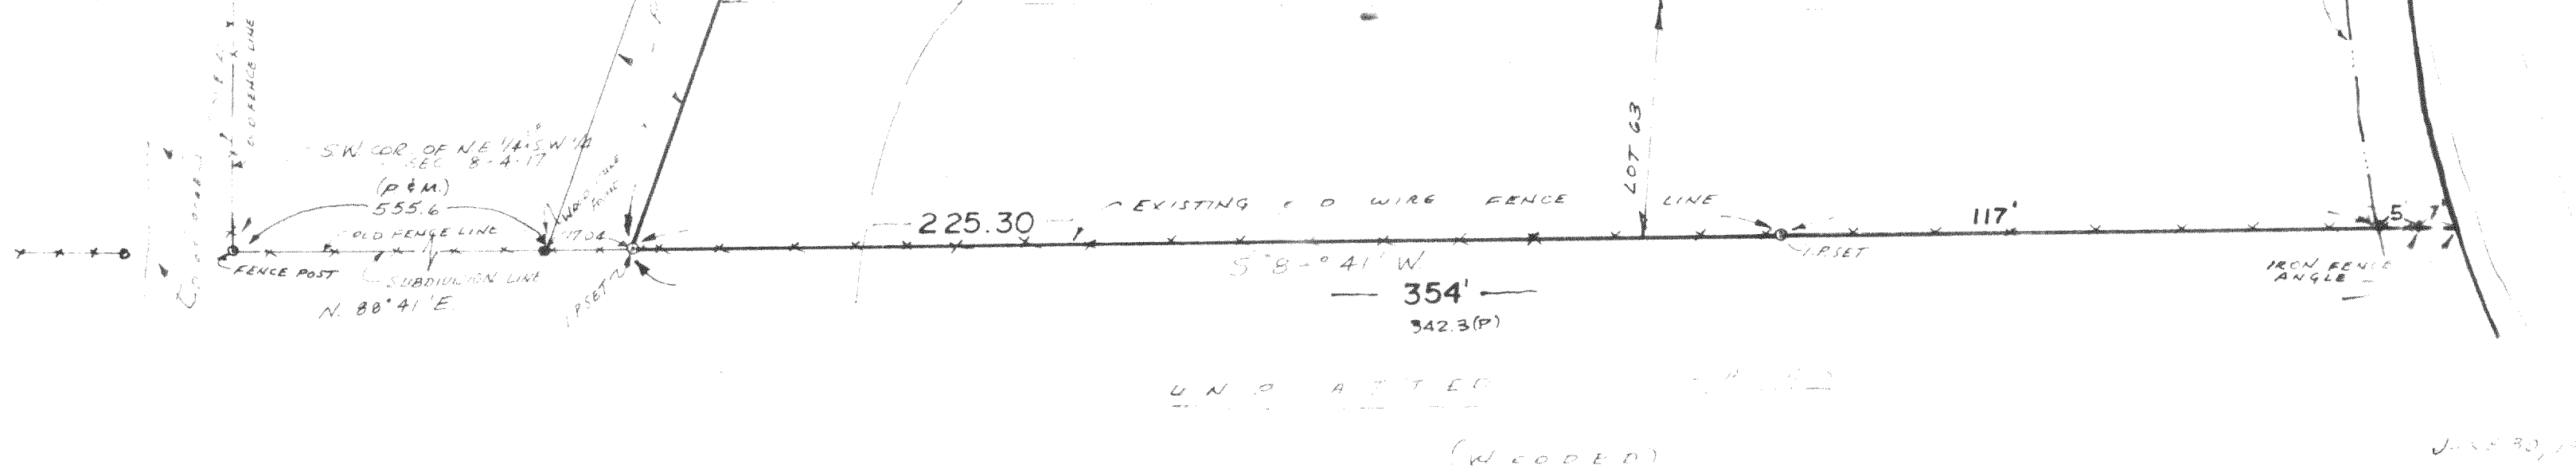

Scale: 1" = 30'

SWIFT LAKE

JUL 23, 1984
 NO. 11234

417-208

LSL33