


RECEIVED
FEB 28 1986
J. J.

LEGAL DESCRIPTION: Lot 1, CSM No. 1325, Vol. 6 of CSM,
pages 135-137, Doc. No. 96539,
located in the NW $\frac{1}{4}$ of Section 25,
Town of Troy, Walworth County, Wis.

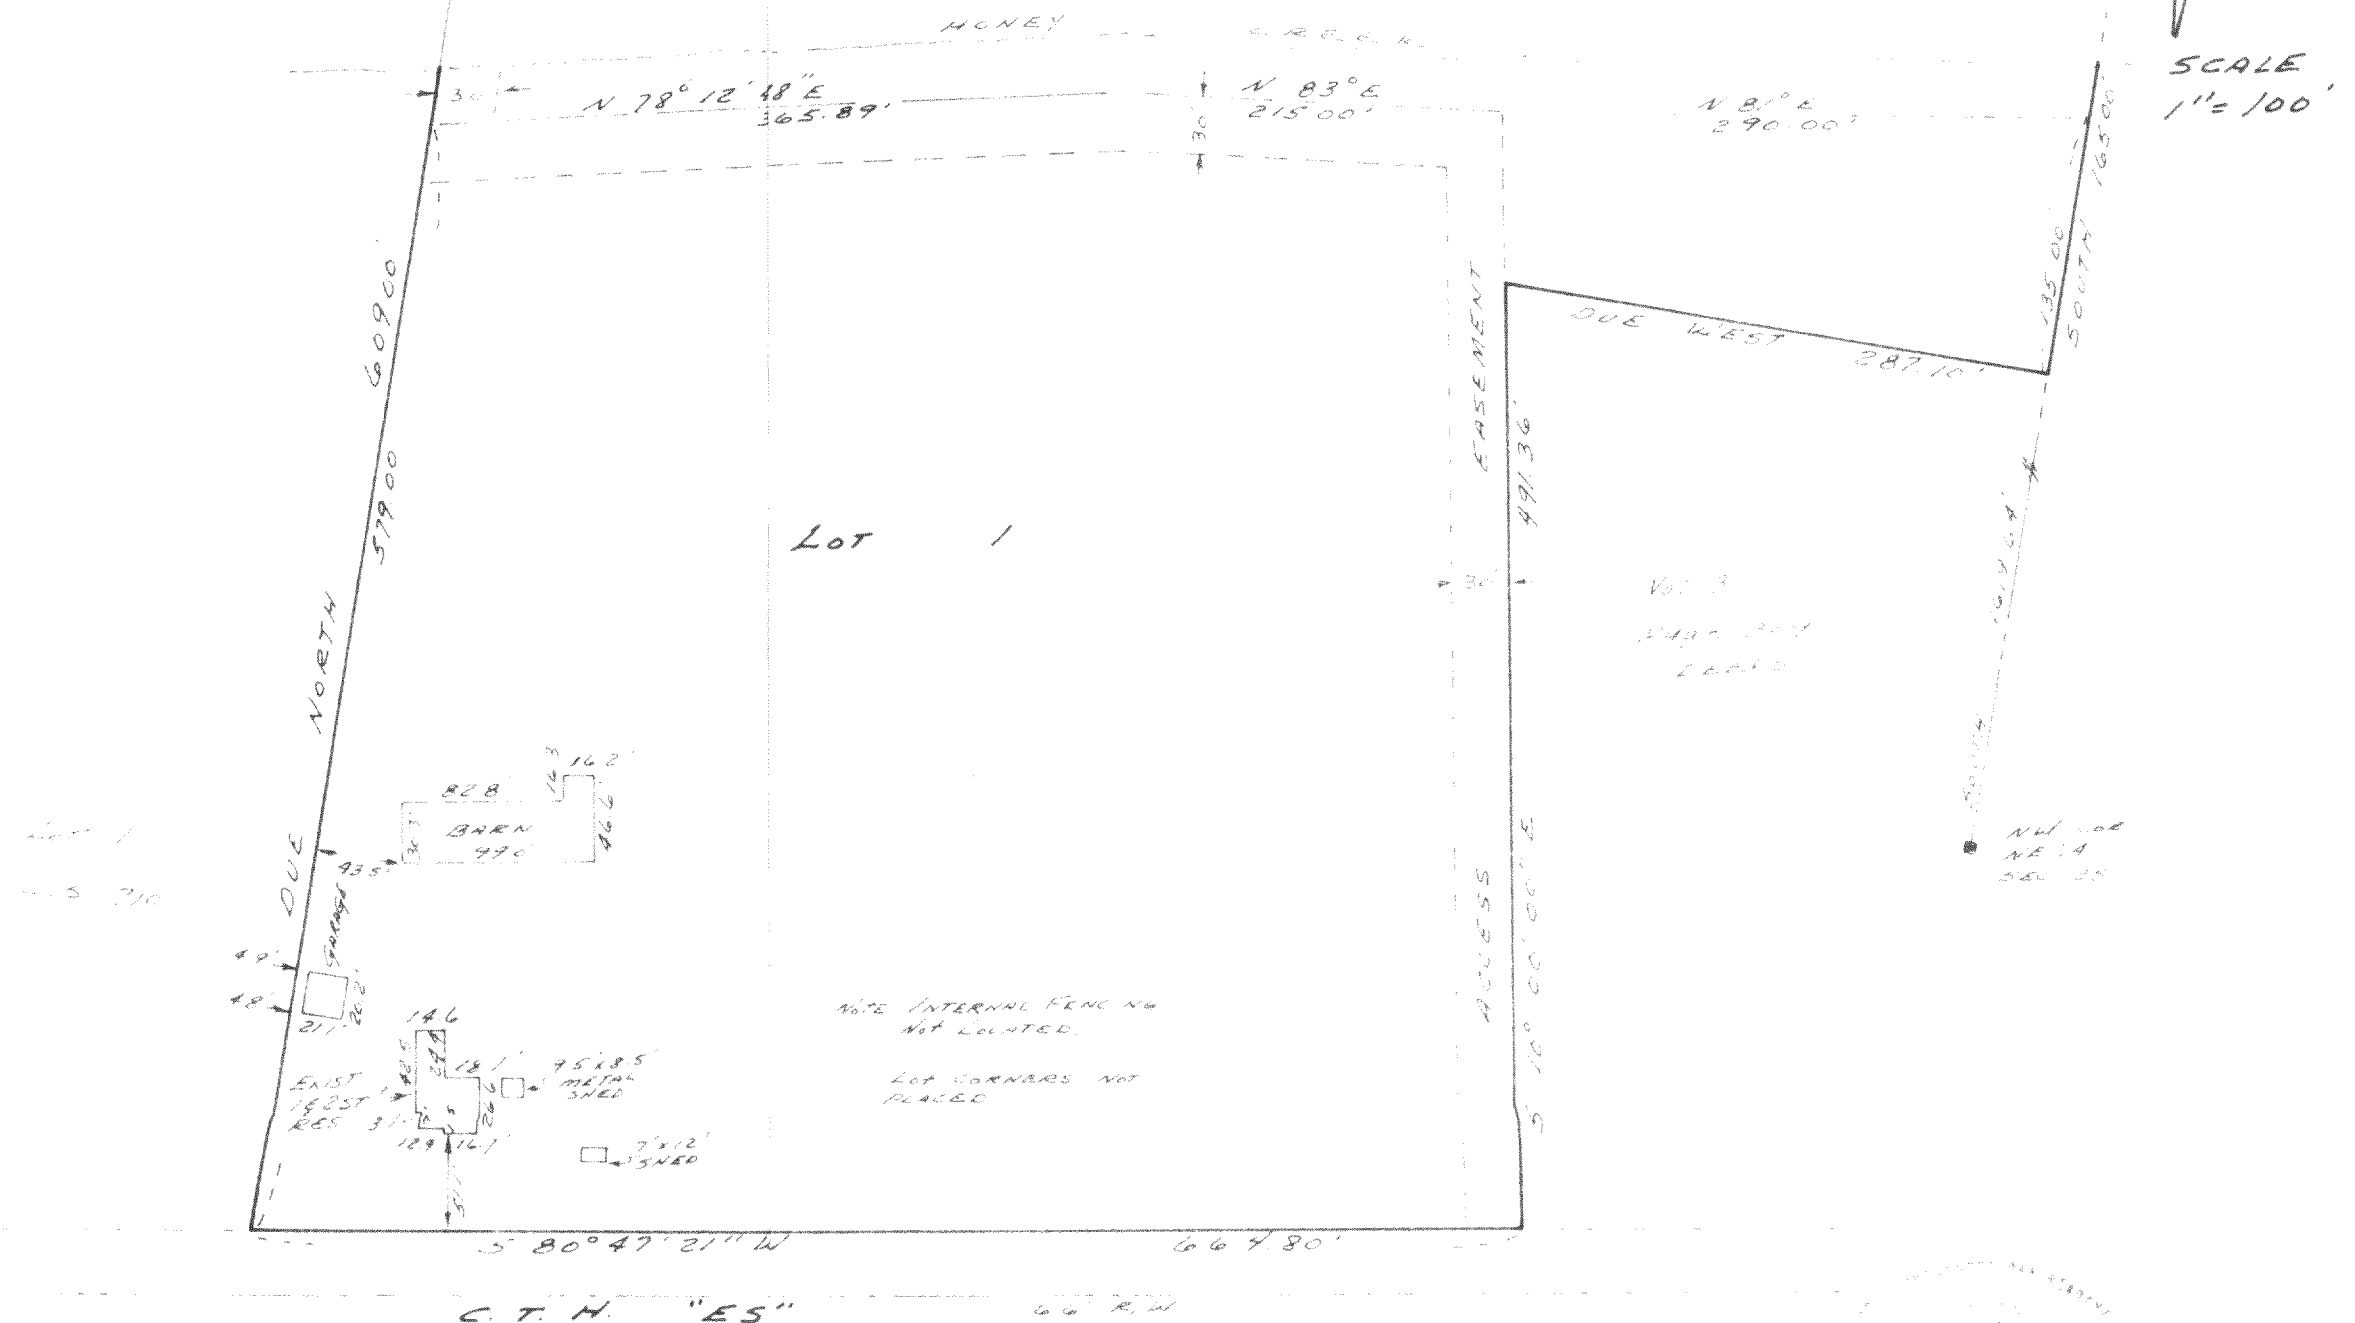

Gary L

417-220^e