



Plat of Survey

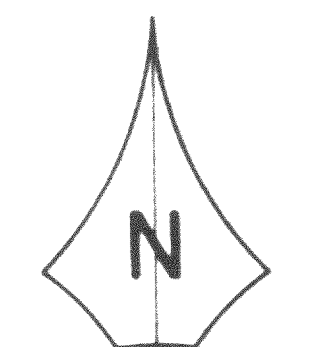

FOR: WISCONSIN MORTGAGE - TERRY HOLLENBAEK & NANCY MOMSEN
PROPERTY ADDRESS: 2151 Pickeral Lake Road; East Troy, Wisconsin 53120

DESCRIPTION: Lot 1 of CERTIFIED SURVEY MAP NO. 1361, as recorded in Volume 6 of Certified Survey Maps on Page 201 in the Walworth County Registry and located in the Northeast 1/4 of the Northeast 1/4 of Section 14, Township 4 North, Range 17 East, in the Town of Troy, Walworth County, Wisconsin.

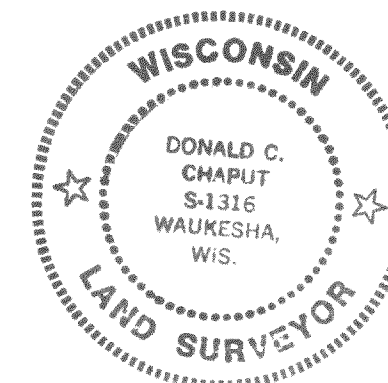

SCALE 1" = 30'

STATE OF WISCONSIN: SS
WAUKESHA COUNTY: SS

CERTIFICATE

I CERTIFY THAT I HAVE SURVEYED THE ABOVE DESCRIBED PROPERTY, AND THE ABOVE MAP IS A TRUE REPRESENTATION THEREOF AND SHOWS THE SIZE AND LOCATION OF THE PROPERTY, ITS EXTERIOR BOUNDARIES, THE LOCATION AND DIMENSIONS OF ALL STRUCTURES THEREON, FENCES, APPARENT EASEMENTS AND ROADWAYS AND VISIBLE ENCROACHMENTS, IF ANY.
THIS SURVEY IS MADE FOR THE EXCLUSIVE USE OF THE PRESENT OWNERS OF THE PROPERTY, AND ALSO THOSE WHO PURCHASE, MORTGAGE, OR GUARANTEE THE TITLE THERETO, WITHIN ONE (1) YEAR FROM DATE HEREOF.

THIS SURVEY IS COPYRIGHTED AND THE REPRODUCTION THEREOF IS PROHIBITED.

MONUMENTATION OF MISSING BOUNDARY CORNERS HAS BEEN WAIVED BY THE ABOVE CLIENT AS PER CHAPTER A.E. 50(1) OF THE WISCONSIN ADMINISTRATIVE CODE.

REGISTERED LAND SURVEYOR

DATE

REVISED AUGUST 14, 1987

TERRA TECHNOLOGY, Inc.

Land Surveyors - Land Planners

909 Blackstone Avenue

Waukesha WI 53186

(414) 549-1111

JOB NUMBER 417-232

417-232