


4/17-2i

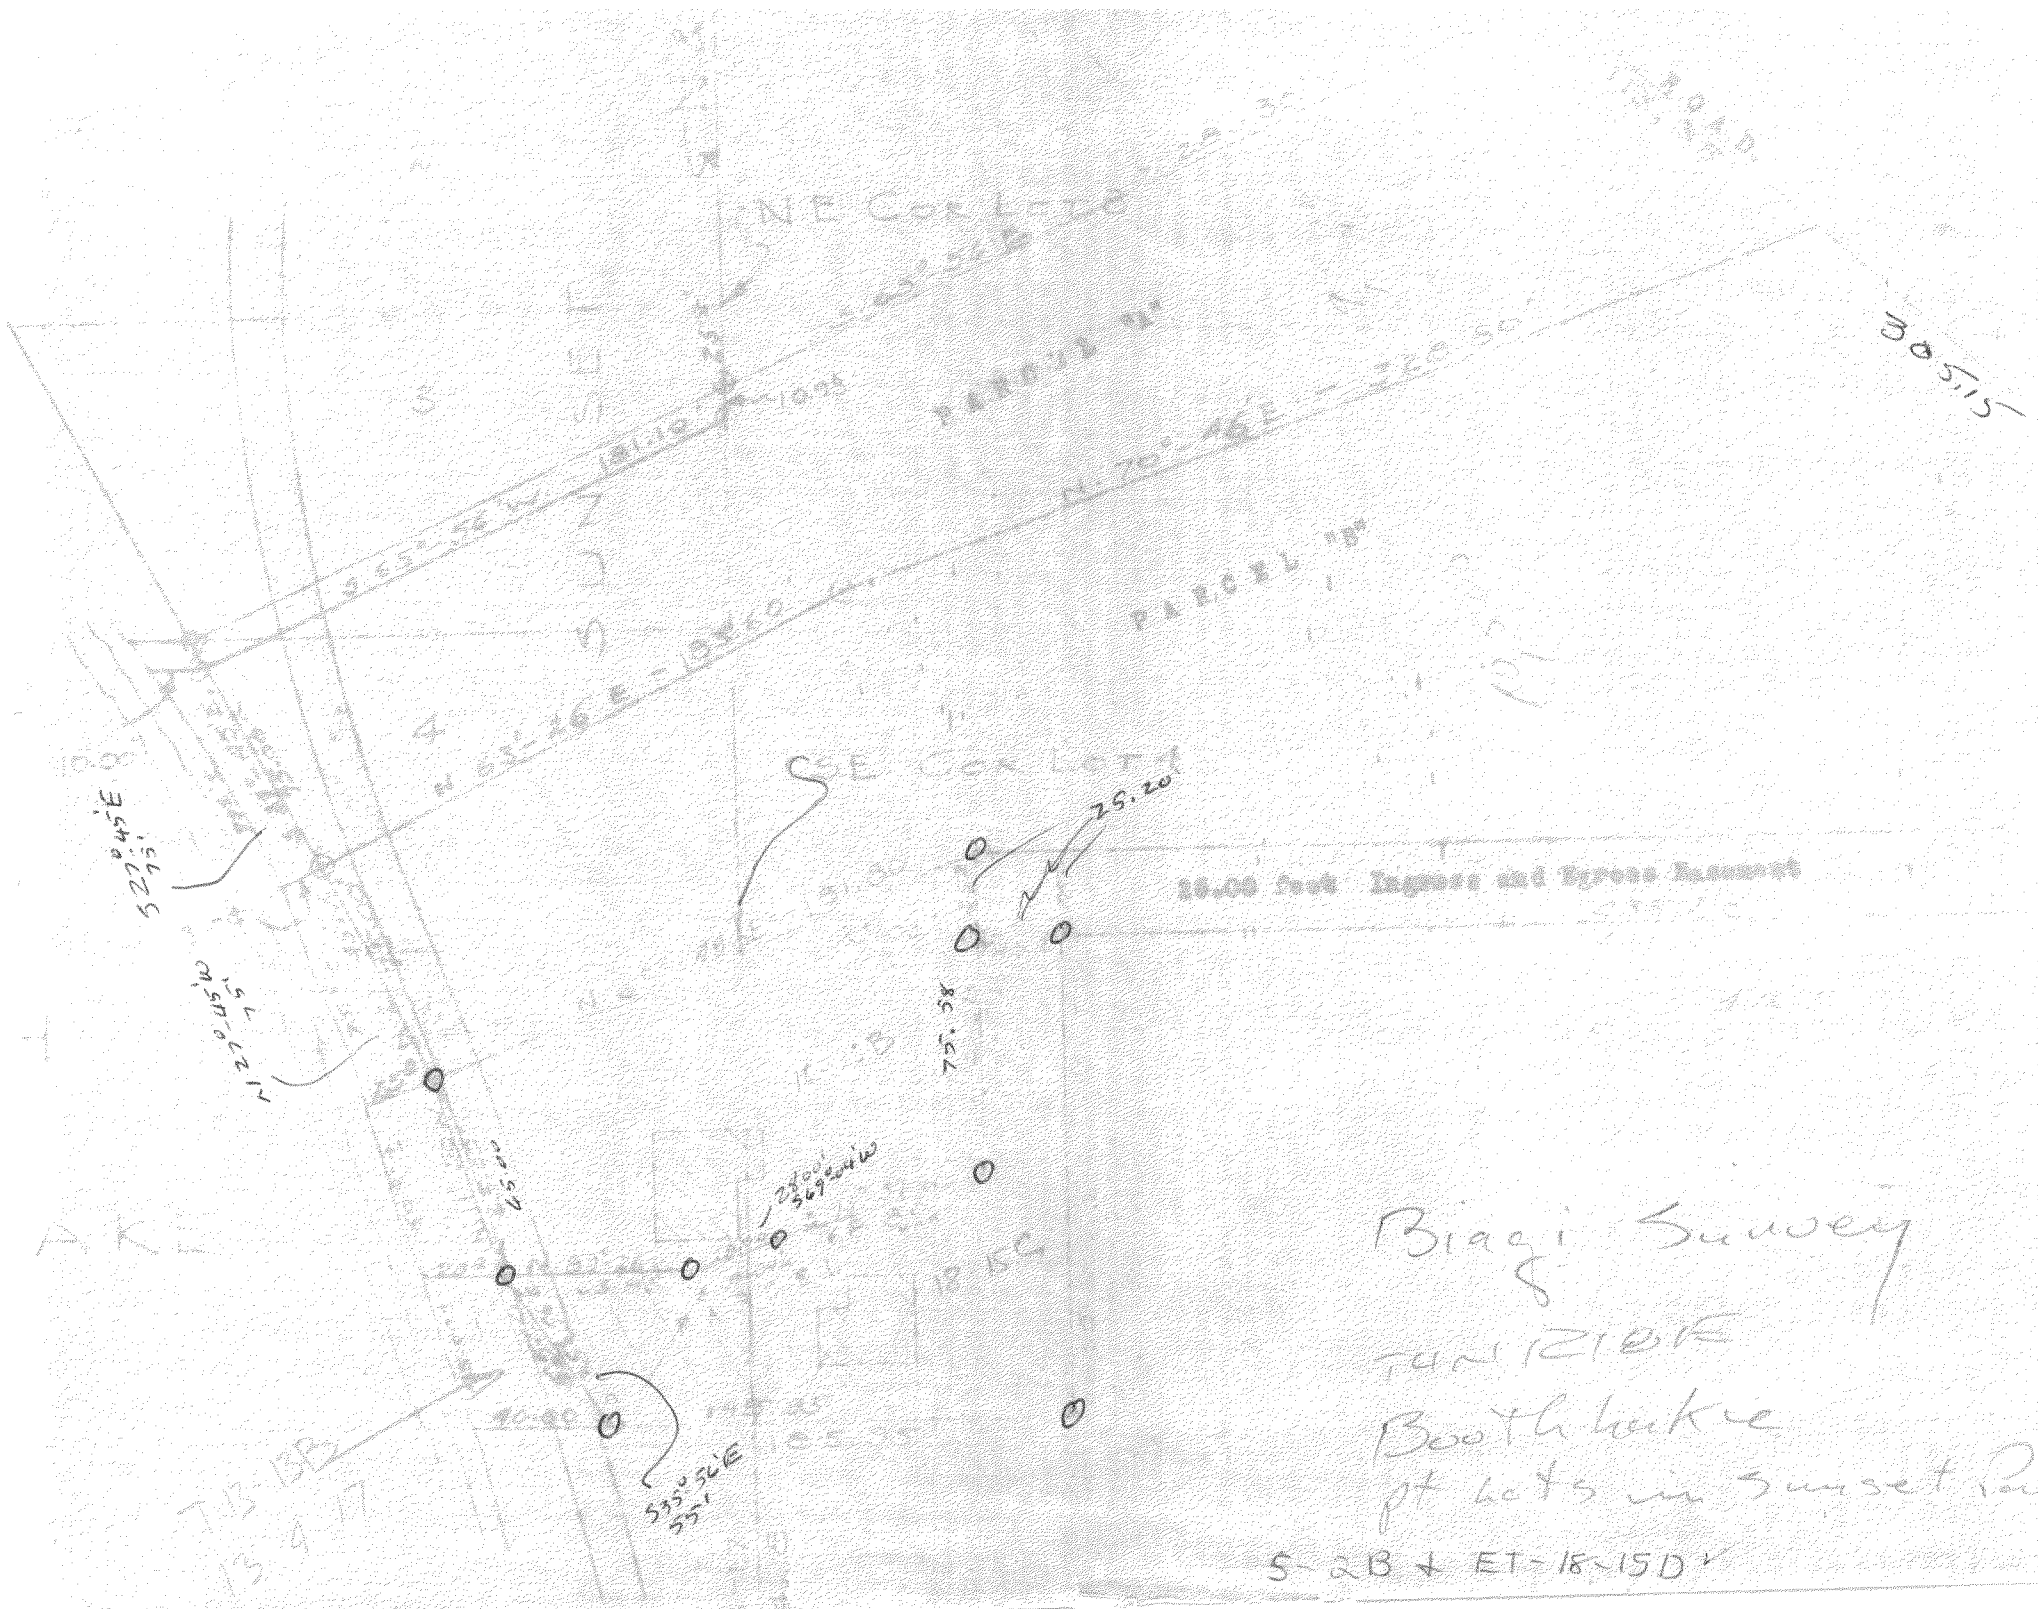

Biagi Survey

T.B. 13B

Booth hookie

pt lots in Sunset Park

S-2B + ET-18-150