

Plat of Survey




Survey For: Fireside Construction
Location: Little Prairie Road

N.E. COR. OF 1/4 SEC. McKenzie

Description: LOT 1 of CERTIFIED SURVEY MAP NO. 1746, part of the N.W. 1/4 of Section 8, Town 4 North, Range 17 East, in the Town of Troy, Walworth County, Wisconsin.

NOTE:

ORIGINAL SURVEY DONE BY
D. COOPER & CO., INC.
WAS NOT MONUMENTED AS
REQUIRED AS OF 12-9-88.

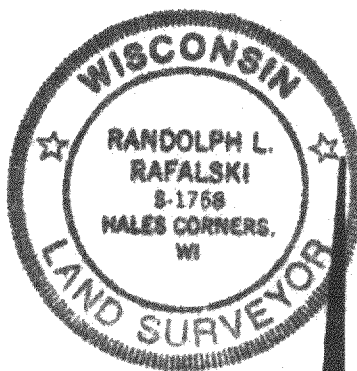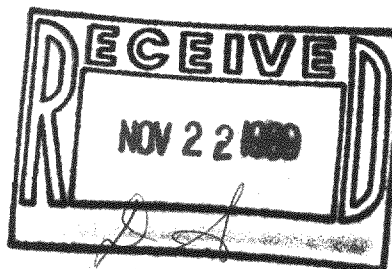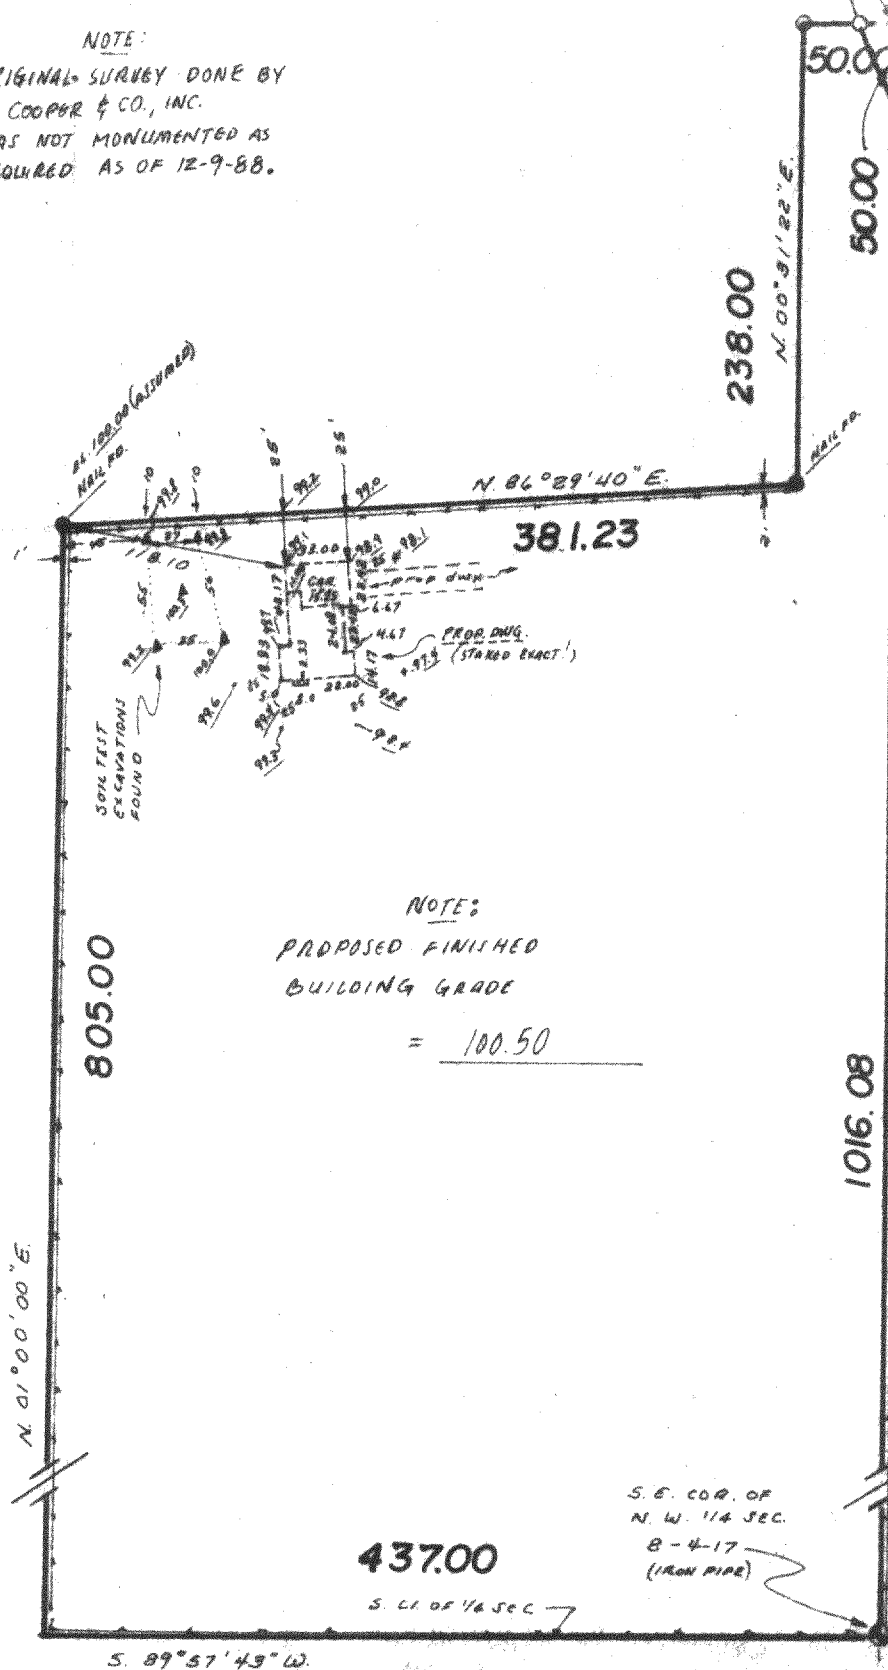

INMAN SURVEY
& ASSOCIATES, INC.
11221 W. FOREST HOME AVE.
HALES CORNERS, WISCONSIN 53130
PHONE 425-2060

State of Wisconsin) ss
Milwaukee County

SURVEY CERTIFICATE

Scale: 1" = 100'

We, Inman Survey and Associates, Inc., certify that we have surveyed the above described property and the above map is a true representation thereof, and shows the size and location of the property, its exterior boundaries, the location and dimensions of all visible structures thereon, fences, apparent easements and roadways and visible encroachments, if any.

This survey is made for the exclusive use of the present owners of the Property, and also those who purchase, mortgage, or guarantee the title thereto, within one (1) year from date hereof.

LA 1746

Randolph L. Rafalski
Wisconsin Registered Land Surveyor

Date: 12/14/88
Job No.: 16223