

Plat of Survey

SCALE 1" = 50'

JAHNKE & JAHNKE ASSOCIATES INC.

Consultants in Engineering, Planning, Subdivisions and Surveying

711 W. MORELAND BLVD. -- WAUKESHA, WISCONSIN 53188

TELEPHONE (414) 542-5797

FOR: JAHNKE CONSTRUCTION INC. RE: STUCZYNSKI

LEGAL DESCRIPTION: Lot 2, Block 1, KETTLE MORaine ESTATE, located in the NW 1/4 of Section 4, T4N, R17E, Town of Troy, Walworth County, Wisconsin

Benchmark 100.00 (Assumed Datum) Top of iron pipe found at northeast lot corner as shown.

101.7 - Existing elevation

Existing Top of Foundation 103.58

Garage and Residence Grade: Living Room Floor 104.5*


Garage Opening 104.90

Top of Foundation 103.5* 1-16-90 - Basement constructed

*elevation from only

and located as shown.

SURVEY CERTIFICATE: I have surveyed the above described property and the map shown is a true representation thereof and shows the size and location of the property, its exterior boundaries, the location and dimensions of all visible structures thereon, fences, apparent easements and roadways, and visible encroachments, if any. This survey is made for the exclusive use of the present owners of the property and also those who purchase, mortgage or guarantee the title thereto within one (1) year from date hereof, and as to them I warrant the accuracy of said survey and map.

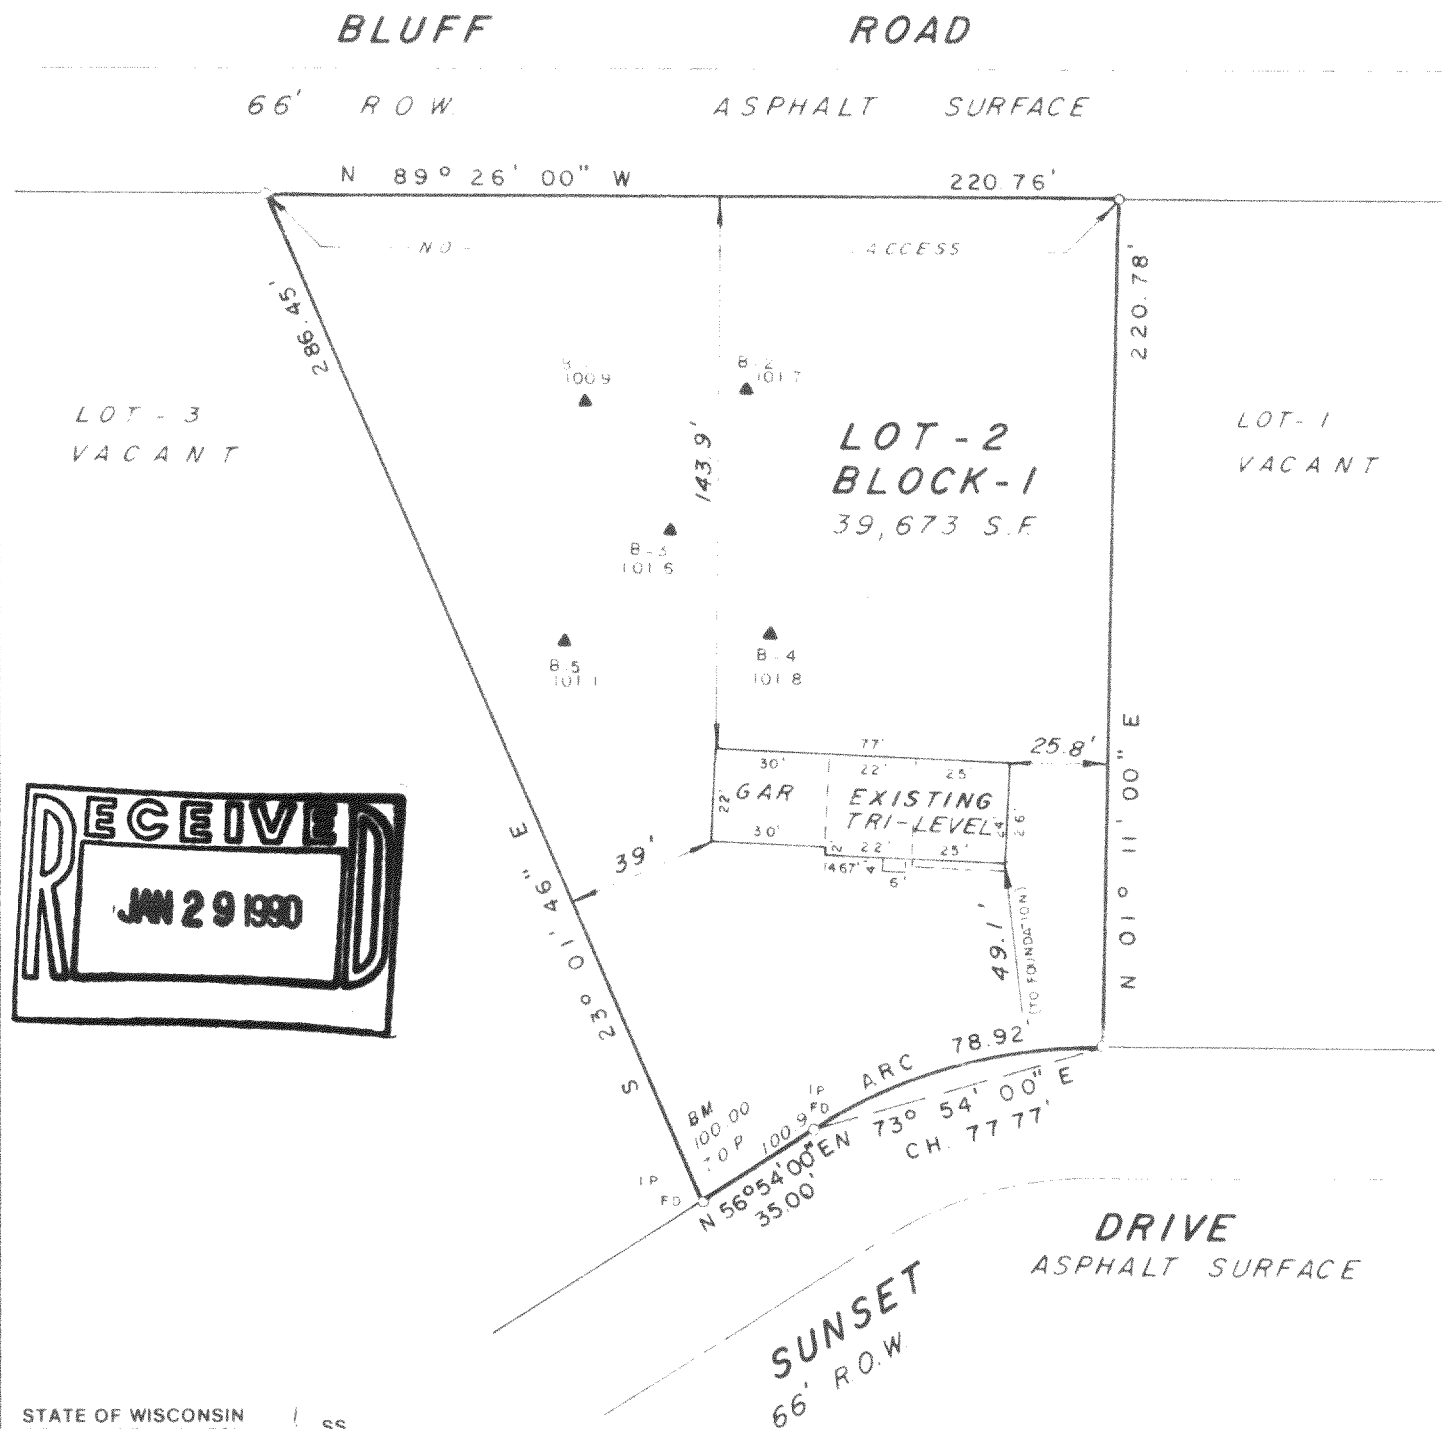

STATE OF WISCONSIN
COUNTY OF WAUKESHA

SS

WE, JAHNKE & JAHNKE ASSOCIATES INC., DO HEREBY CERTIFY THAT WE HAVE MADE THIS SURVEY AND THAT THE INFORMATION AS SHOWN ON THE ABOVE PLAT OF SURVEY IS TRUE AND CORRECT REPRESENTATION THEREOF.

Revised: 1/17/90 (Basement survey)

DATED THIS 10th DAY OF October 1989

PLAT No. P.S. Walworth 140 BOOK Walworth #5 PAGE 53

RICHARD P. JAHNKE - Wis. Reg. No. S-318

JOHN W. JAHNKE - Wis. Reg. No. S-917