


PLAT OF SURVEY

LOCATION: Gavers Court, Troy, Wisconsin

LEGAL DESCRIPTION: Lot 14 in ANNTROYEEN ESTATES, (Unrecorded), a subdivision in Sections 12 and 13 in Township 4 North, Range 17 East, in the Town of Troy, Walworth County, Wisconsin, and being described as follows: Commencing at the South 1/4 corner of Section 12, Town 4 North, Range 17 East, thence N 00° 33' 25" W, along the South 1/4 line of Section 12, 100.00 feet; thence N 82° 30' E, 300.00 feet to the point of beginning; thence N 15° 22' 50" E, 464.93 feet to a point on the Southerly right-of-way line of Gavers Court; thence Easterly, along said Southerly r-o-w line, the arc of which is 104.47 feet, the radius of which is 60.00 feet, the central angle of which is 99° 45' 42" and the center of which is in a Northerly direction, the chord of which bears N 55° 29' 59" E, 91.77 feet; thence Easterly, along said Southerly r-o-w line, the arc of which is 292.91 feet, the radius of which is 1167.00 feet, the central angle of which is 14° 22' 51" and the center of which is in a Southerly direction, the chord of which bears N 70° 39' 51" E, 292.14 feet; thence S 12° 08' 44" E, 531.68 feet; thence S 82° 30' W, 591.52 feet to the point of beginning.

October 13, 1992

Survey No. 578-B

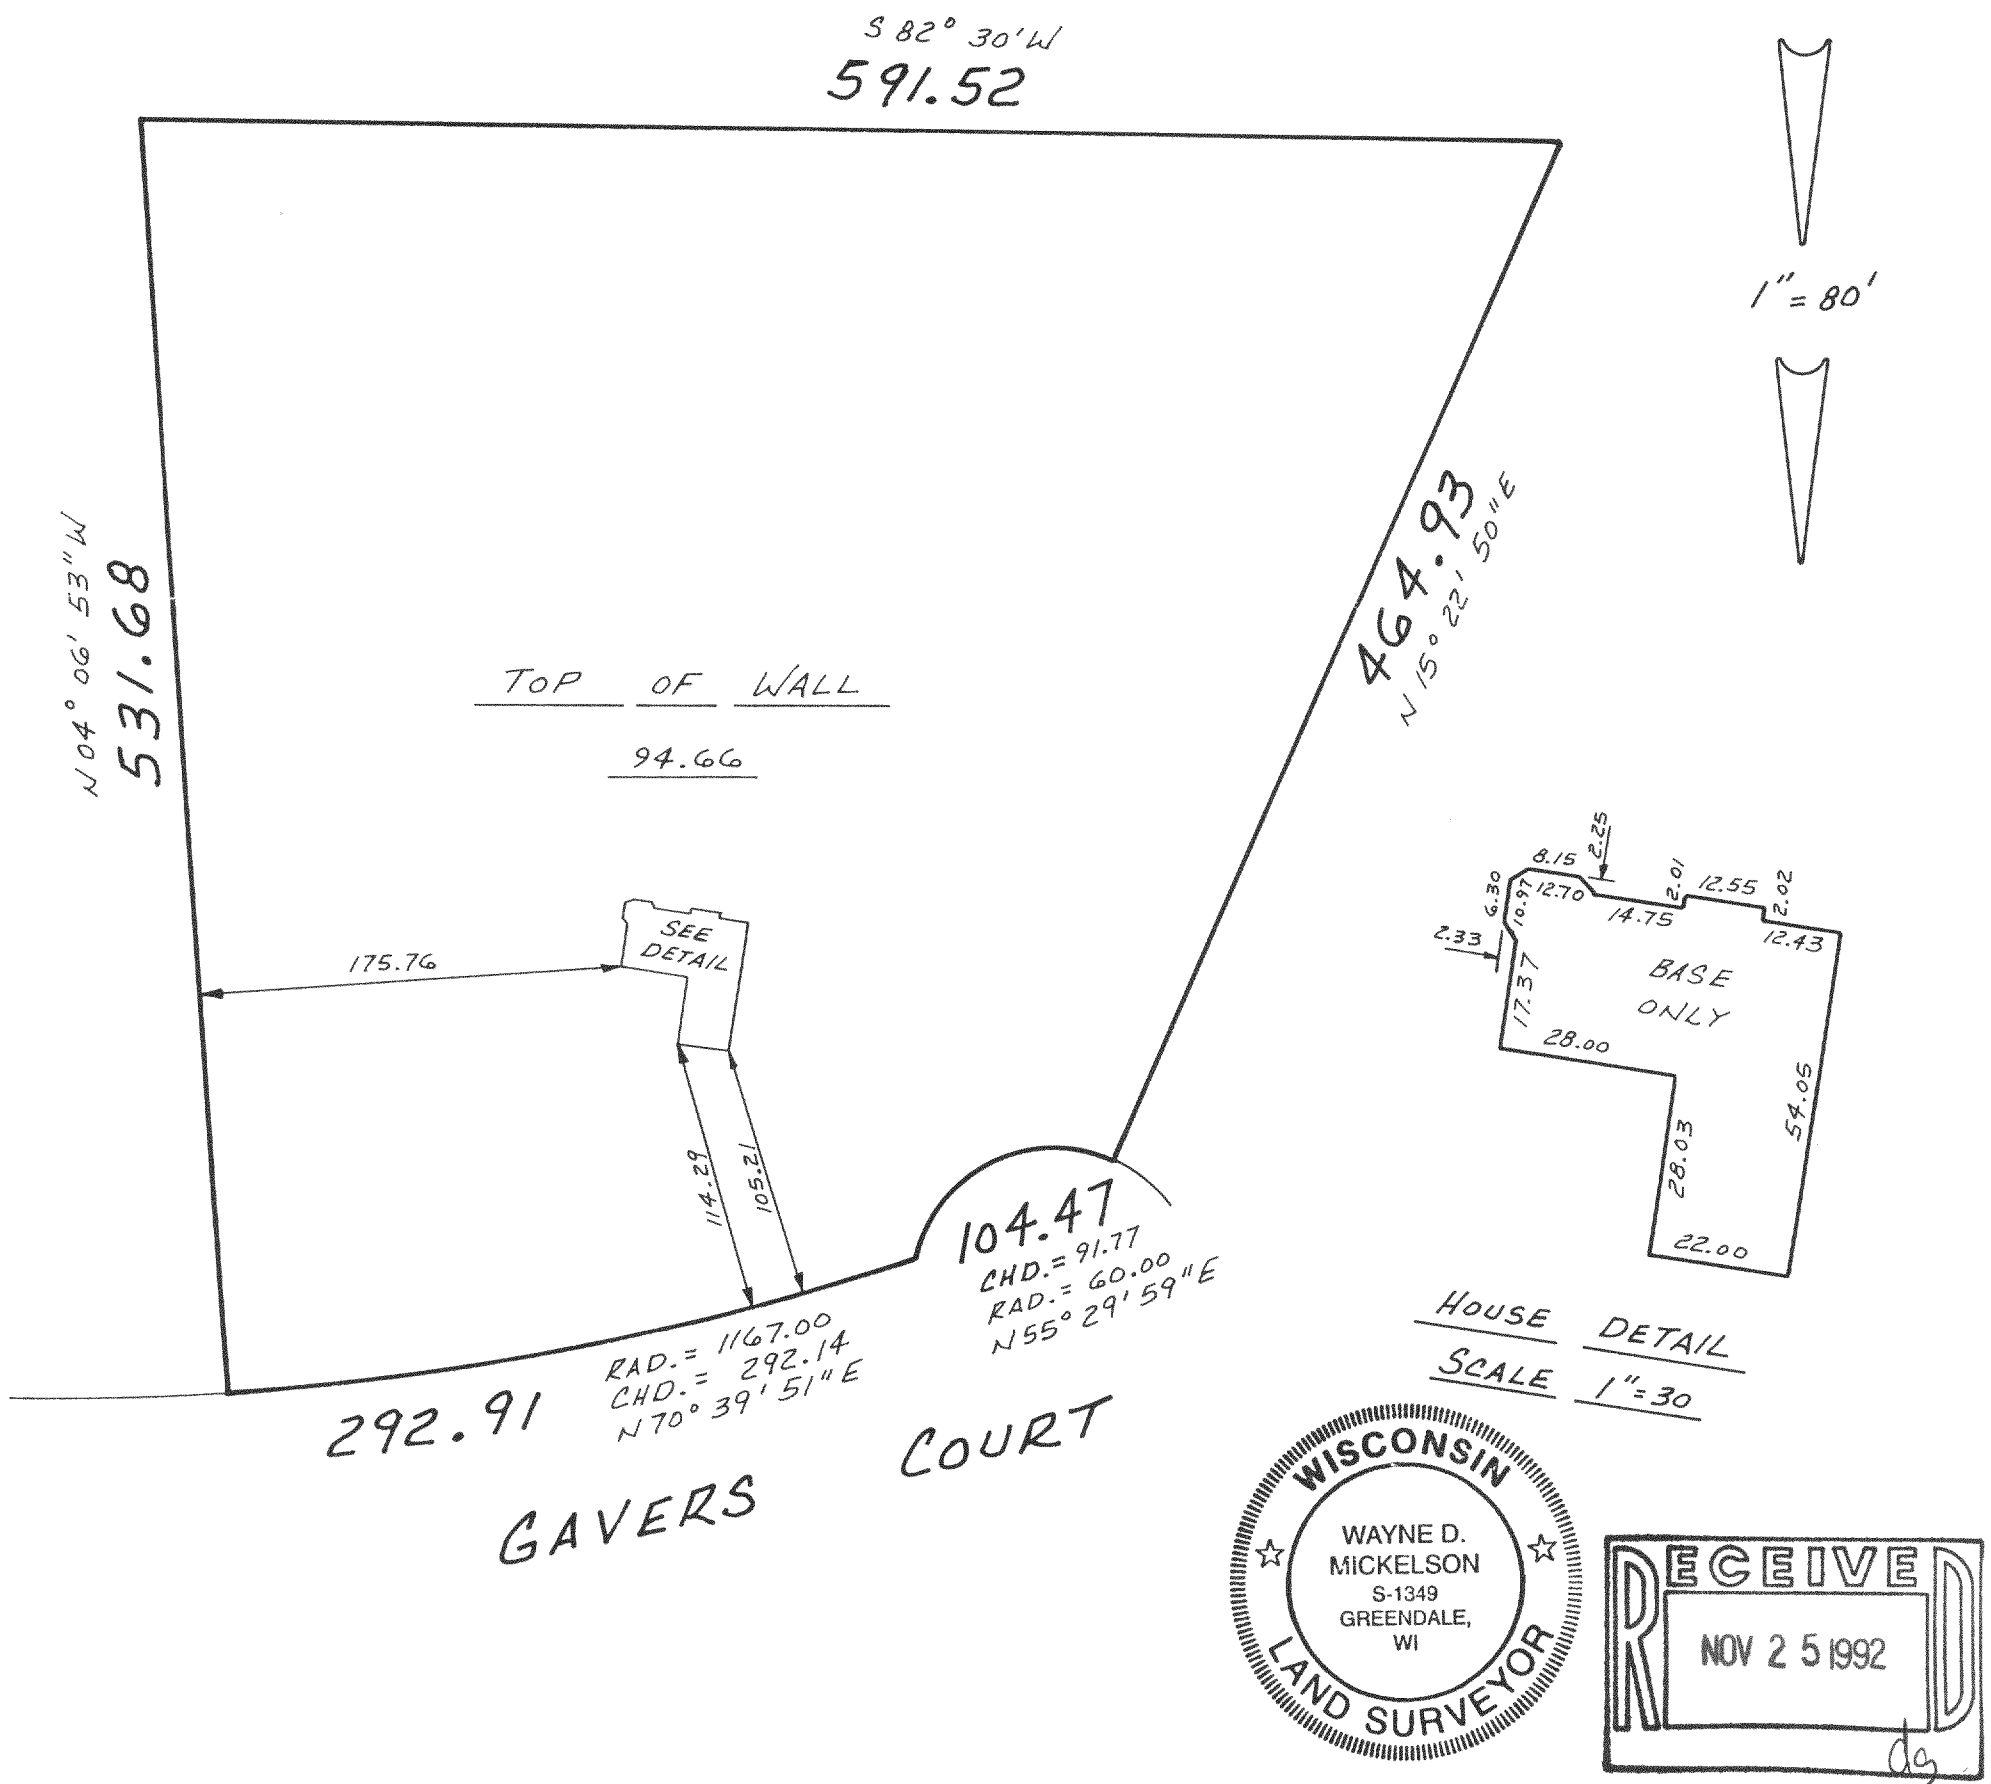

METROPOLITAN ENTERPRISES, INC.

REGISTERED LAND SURVEYORS

9415 W. FOREST HOME AVE., SUITE 202, HALES CORNERS, WI 53130

PH. 529-5380 FAX 529-9787

I HEREBY CERTIFY THAT I HAVE SURVEYED THE ABOVE DESCRIBED PROPERTY AND THAT THE ABOVE MAP IS A TRUE REPRESENTATION THEREOF AND SHOWS THE SIZE AND LOCATION OF THE PROPERTY. ITS EXTERIOR BOUNDARIES, THE LOCATION OF ALL VISIBLE STRUCTURES AND DIMENSIONS OF ALL PRINCIPAL BUILDINGS THEREON, BOUNDARY FENCES, APPARENT EASEMENTS AND ROADWAYS AND VISIBLE ENCROACHMENTS, IF ANY.

THIS SURVEY IS MADE FOR THE EXCLUSIVE USE OF THE PRESENT OWNERS OF THE PROPERTY, AND ALSO THOSE WHO PURCHASE, MORTGAGE, OR GUARANTEE THE TITLE THERETO WITHIN ONE (1) YEAR FROM DATE HEREOF.

SIGNED

Wayne D. Mickelson

Wayne D. Mickelson
Registered Land Surveyor S-1349

LAN-14

417-342




PLAT OF SURVEY

LOCATION: Gavers Court, Troy, Wisconsin

LEGAL DESCRIPTION: Lot 14 in ANNTROYEEN ESTATES, unrecorded, a subdivision in Sections 12 and 13 in Township 4 North, Range 17 East, in the Town of Troy, Walworth County, Wisconsin and being described as follows: Commencing at the South 1/4 corner of Section 12, Town 4 North, Range 17 East, thence N 00° 33' 25" W, along the South 1/4 line of Section 12, 100.00 feet; thence N 82° 30' E, 300.00 feet to the point of beginning; thence N 15° 22' 50" E, 464.93 feet to a point on the Southerly right-of-way line of Gavers Court; thence Easterly, along said Southerly r-o-w line, the arc of 104.47 feet, the radius of 60.00 feet, the central angle of 99° 45' 42" and the center of which is in a Northerly direction, the chord of which bears N 55° 29' 59" E, 91.77 feet; thence Easterly, along said Southerly r-o-w line, the arc of 292.91 feet, the radius of 1167.00 feet, the central angle of 14° 22' 51" and the center of which is in a Southerly direction, the chord of which bears N 70° 39' 51" E, 292.14 feet; thence S 12° 08' 44" E, 531.68 feet; thence S 82° 30' W, 591.52 feet to the point of beginning.

August 20, 1992

Survey No. 578-S

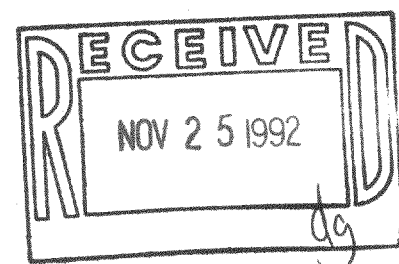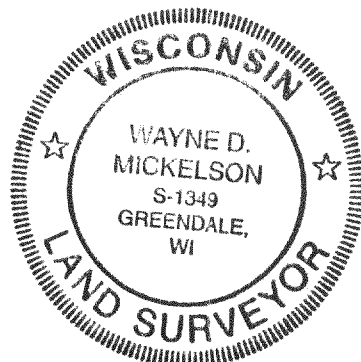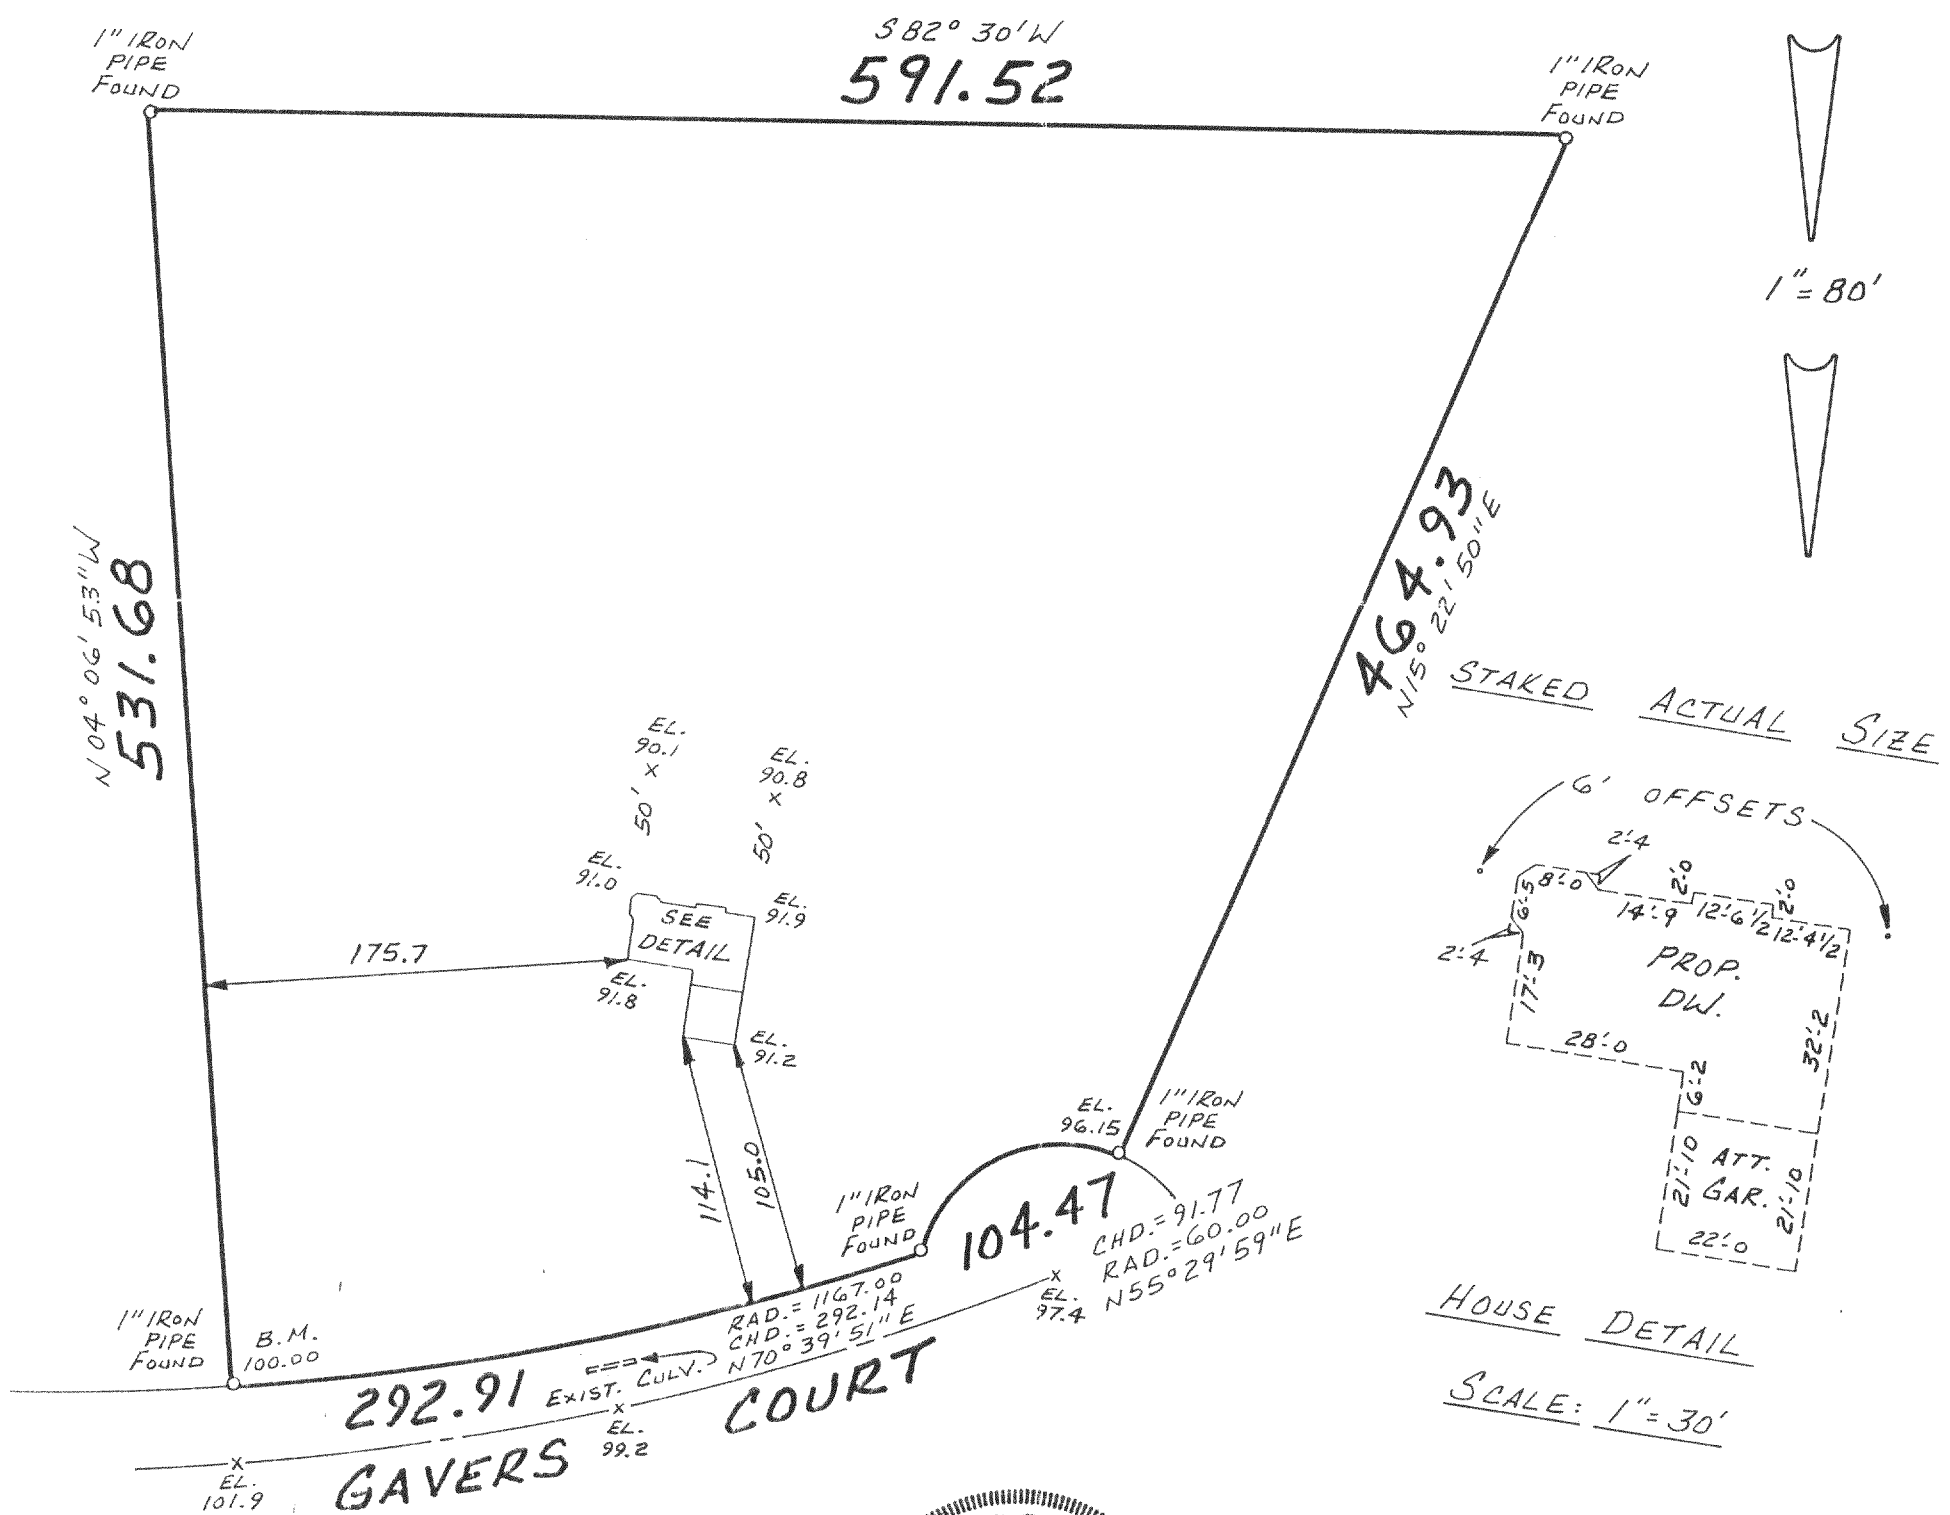

METROPOLITAN ENTERPRISES, INC.

REGISTERED LAND SURVEYORS

9415 W. FOREST HOME AVE., SUITE 202, HALES CORNERS, WI 53130

PH. 529-5380 FAX 529-9767

I HEREBY CERTIFY THAT I HAVE SURVEYED THE ABOVE DESCRIBED PROPERTY AND THAT THE ABOVE MAP IS A TRUE REPRESENTATION THEREOF AND SHOWS THE SIZE AND LOCATION OF THE PROPERTY, ITS EXTERIOR BOUNDARIES, THE LOCATION OF ALL VISIBLE STRUCTURES AND DIMENSIONS OF ALL PRINCIPAL BUILDINGS THEREON, BOUNDARY FENCES, APPARENT EASEMENTS AND ROADWAYS AND VISIBLE ENCROACHMENTS, IF ANY.

THIS SURVEY IS MADE FOR THE EXCLUSIVE USE OF THE PRESENT OWNERS OF THE PROPERTY, AND ALSO THOSE WHO PURCHASE, MORTGAGE, OR GUARANTEE THE TITLE THERETO WITHIN ONE (1) YEAR FROM DATE HEREOF.

SIGNED Wayne D. Mickelson

Wayne D. Mickelson
Registered Land Surveyor S-1349