


PLAT OF SURVEY


LOT 3 OF CERTIFIED SURVEY MAP NO. 1351
REC. IN VOL. 6 ON PG. 185
LOCATED IN THE NE 1/4 SEC. 21
T. 4 N., R. 17 E.
WALWORTH COUNTY, WISCONSIN

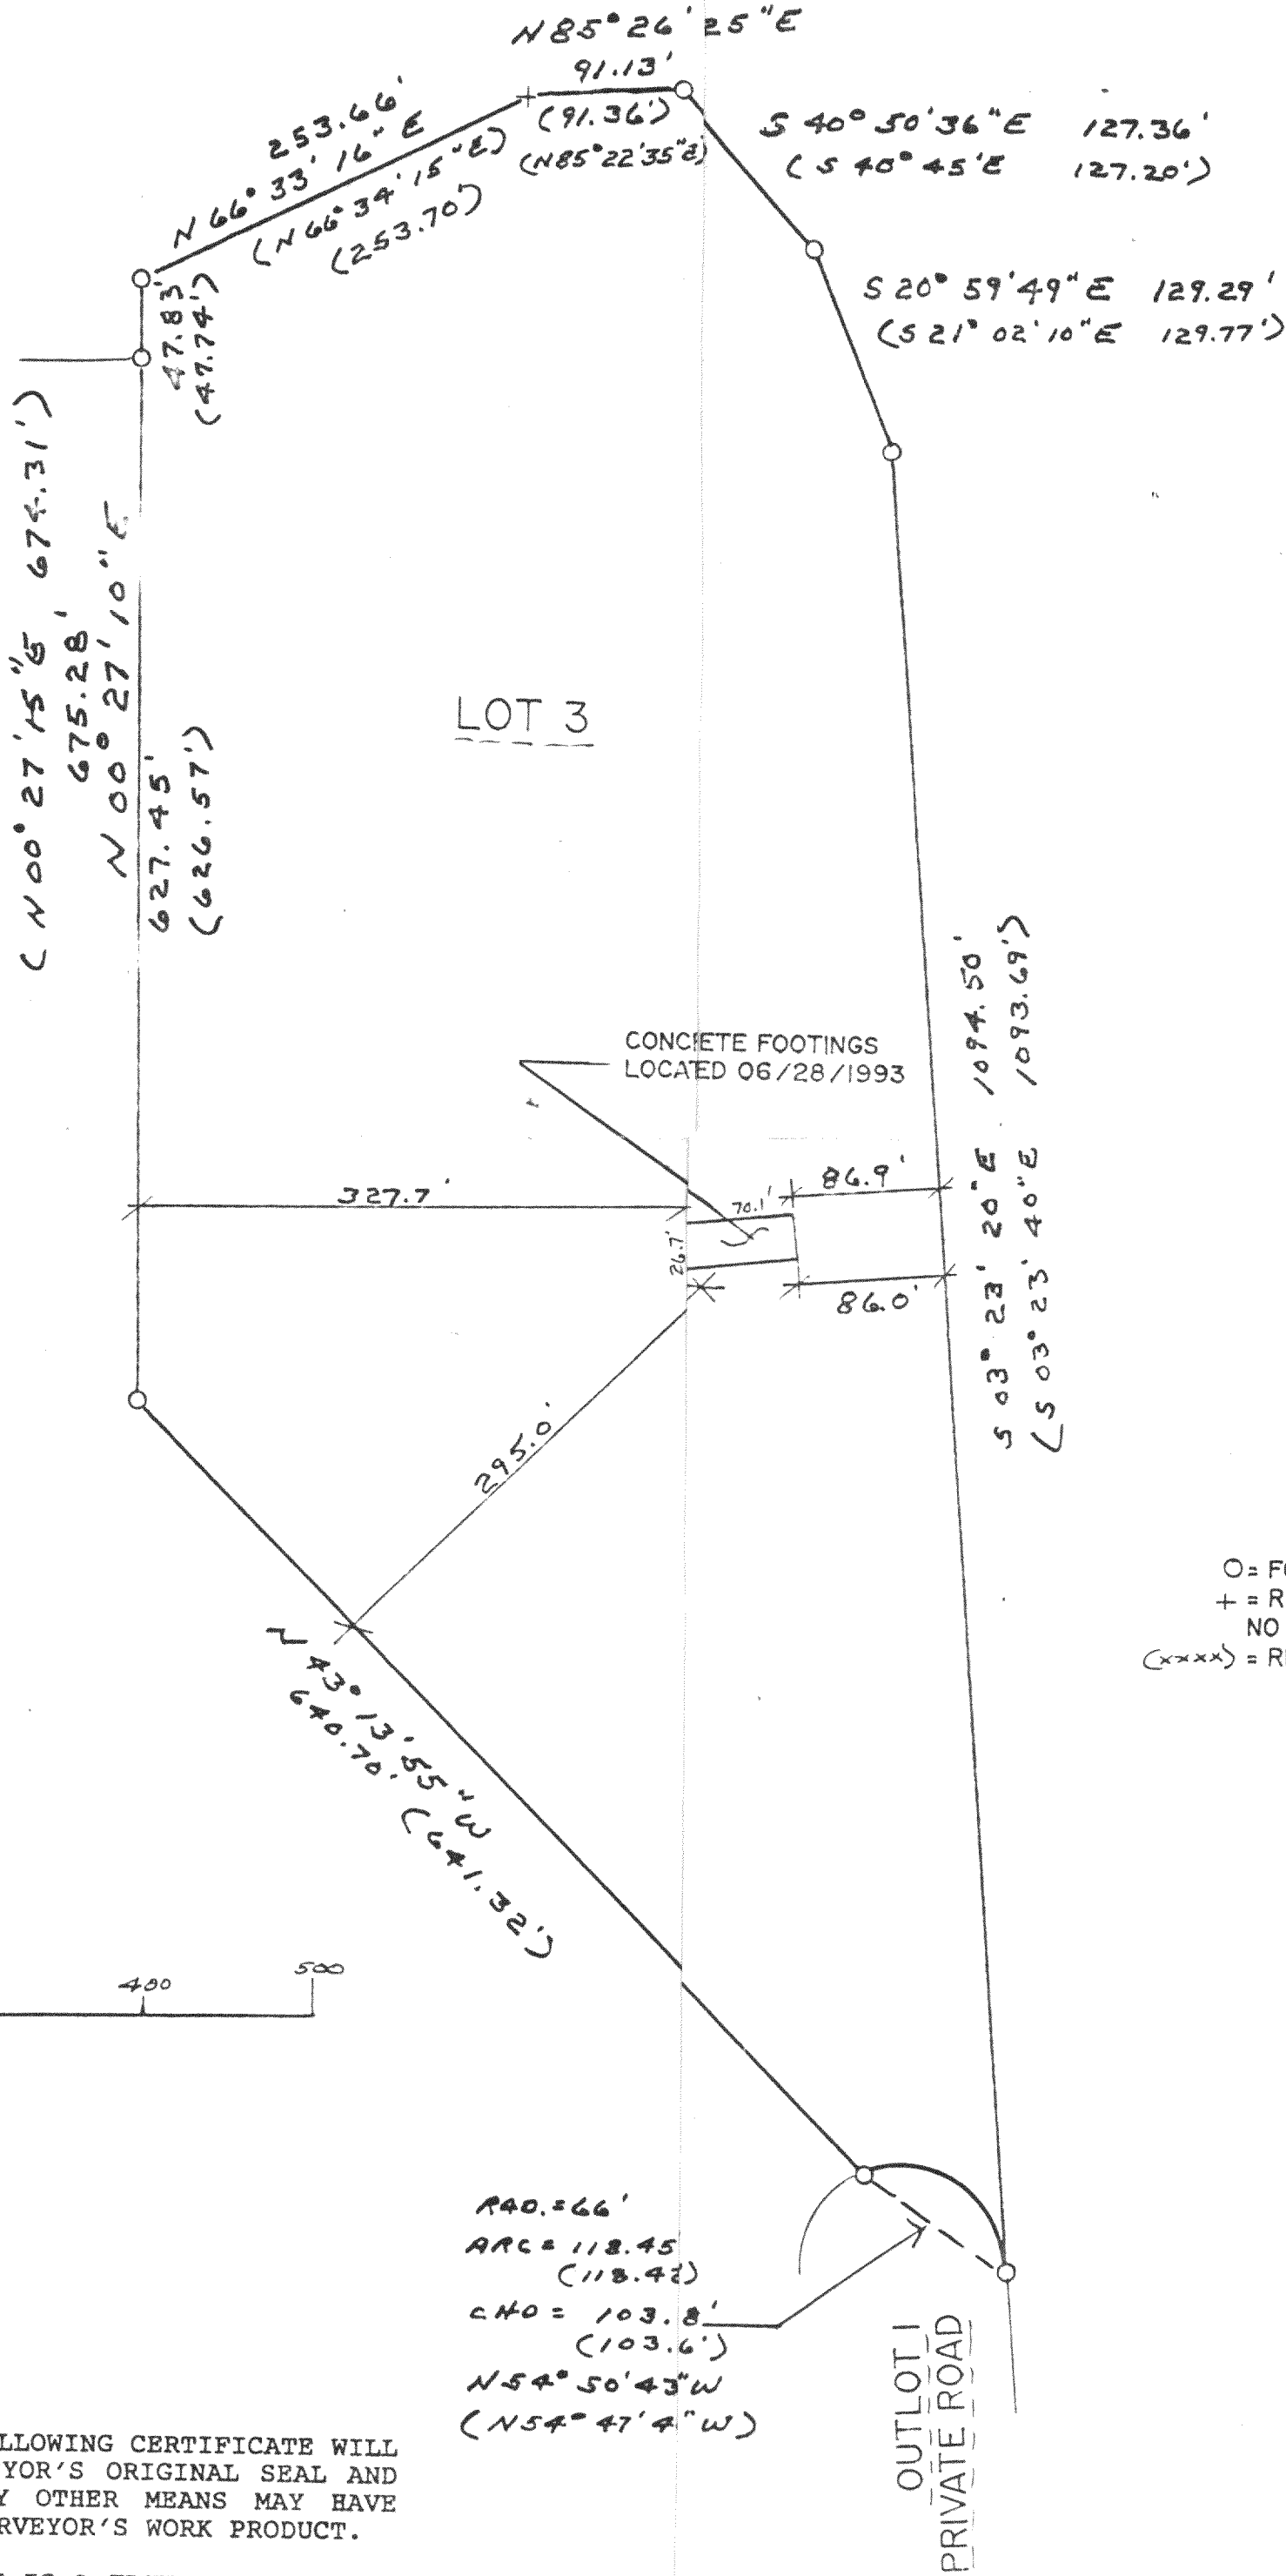

ASSIGNED SW LINE LOT 3
N 43° 13' 55" W
PER PLAT OF RECORD

LEGEND
O = FOUND IRON PIPE STAKE
+ = RECORD CORNER POSITION
NO MONUMENT FOUND
(xxx) = RECORDED AS


MAP SCALE IN FEET
1" = 100'

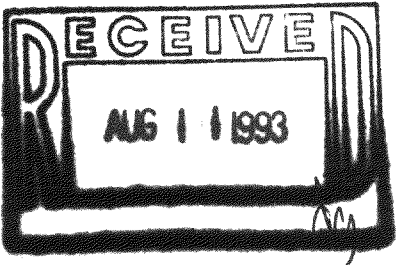

NOTE: COPIES OF THIS MAP TO WHICH THE FOLLOWING CERTIFICATE WILL APPLY ARE BLUE LINE PRINTS SHOWING SURVEYOR'S ORIGINAL SEAL AND SIGNATURE IN BLACK INK. COPIES BY ANY OTHER MEANS MAY HAVE ALTERATIONS WHICH DO NOT REPRESENT THE SURVEYOR'S WORK PRODUCT.

I HEREBY CERTIFY THAT THIS PLAT OF SURVEY IS A TRUE AND ACCURATE REPRESENTATION OF THE BOUNDARY LINES OF THE SUBJECT PARCEL AND SHOWS THE SIZE AND LOCATION OF THE CONCRETE FOOTINGS AS LOCATED ON JUNE 28, 1993 TO THE BEST OF MY KNOWLEDGE AND BELIEF. THIS SURVEY IS MADE FOR THE USE OF THE PRESENT OWNERS OF THE PROPERTY, AND ALSO THOSE WHO PURCHASE, MORTGAGE, OR GUARANTEE THE TITLE THERETO WITHIN ONE YEAR FROM THE DATE HEREOF.

DATED: 06/29/1993
PETER S. GORDON RLS 2101

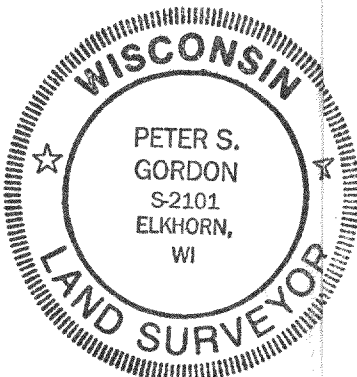

WORK ORDERED BY: RUTH ANN PETITT

PLAT OF SURVEY
LOT 3 OF CERTIFIED SURVEY MAP NO. 1351
REC. IN VOL. 6 ON PG. 185
LOCATED IN THE NE 1/4 SEC. 21
T. 4 N., R. 17 E.
WALWORTH COUNTY, WISCONSIN

WORK ORDERED BY:
RUTH ANN PETITT
PO BOX 212
E. TROY, WI.

FARRIS, HANSEN & ASSOCIATES, INC.
Engineering, Architecture, Surveying
7 Ridgeway Court P.O. Box 437
ELKHORN, WISCONSIN 53121
Office: (414) 723-2098
Fax: (414) 723-5886

REVISIONS

PROJECT NO.
3867
DATE
06/29/93
SHEET NO.
1 OF 1

417-369