
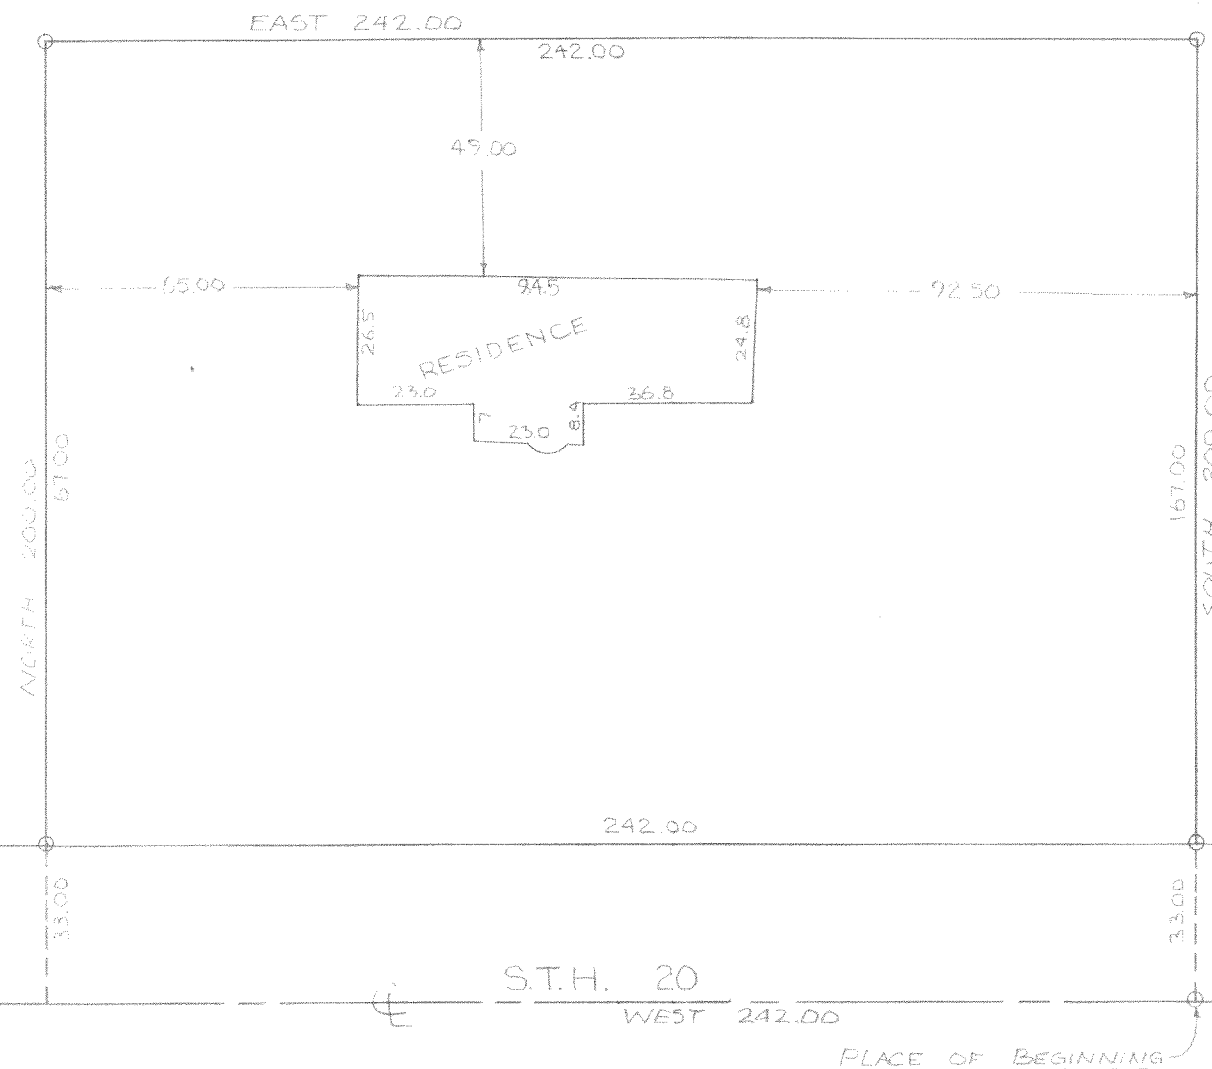


DESCRIPTION:
Commencing at the NE corner of Section 22 T9N, R17E, Walworth County Wisconsin; thence South 2628.70 feet, to a point in the centerline of S.T.H. #20, thence west along said centerline 191.37 feet to the Place of Beginning of the lands hereinafter described to-wit; thence continue west along said centerline 242.00 feet, thence North 200.00 feet, thence East 242.00 feet, thence South 200.00 feet to the place of beginning containing 1.11 acres of land more or less. Total buildable area exclusive of the road is 40,414 square feet

Certificate: I Joseph M. Biagi surveyor do hereby certify that I have surveyed the above described property June 3rd 1974.

~~Joseph M. Biagi.~~
~~RLS #12~~

Elkhorn, Wisconsin.
Dated 6/3/74

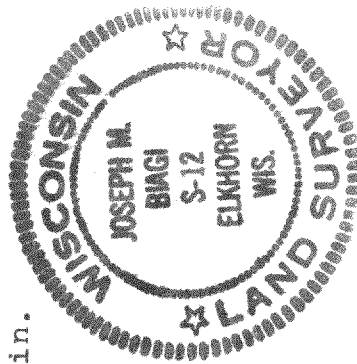


N.E. CORNER OF SECTION 22.
T4N - R17E.



SCALE 1" = 40'

⊙ — INDICATES IRON PIPE

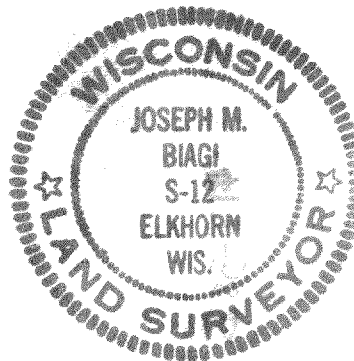

REVISIONS			HEALY MORTGAGE SURVEY		
NO.	DATE	BY			
1			TROY CENTER, WISC.		
2					
3			DRAWN BY JPK	SCALE 1"=40'	MATERIAL
4			CHK'D	DATE 5-29-74	DRAWING NO.
5			TRACED	APP'D	#35-74