


KOLB LAND CONSULTING, INC.

929 WILLIAMS STREET LAKE GENEVA, WI. 53147 414-248-3697

BM #1 ASSUMED ELEV.
100.00'

BM #2 TOP OF IRON PIPE
ELEV. 123.64'

FOUND IRON PIPE 0.7' SW OF LINE

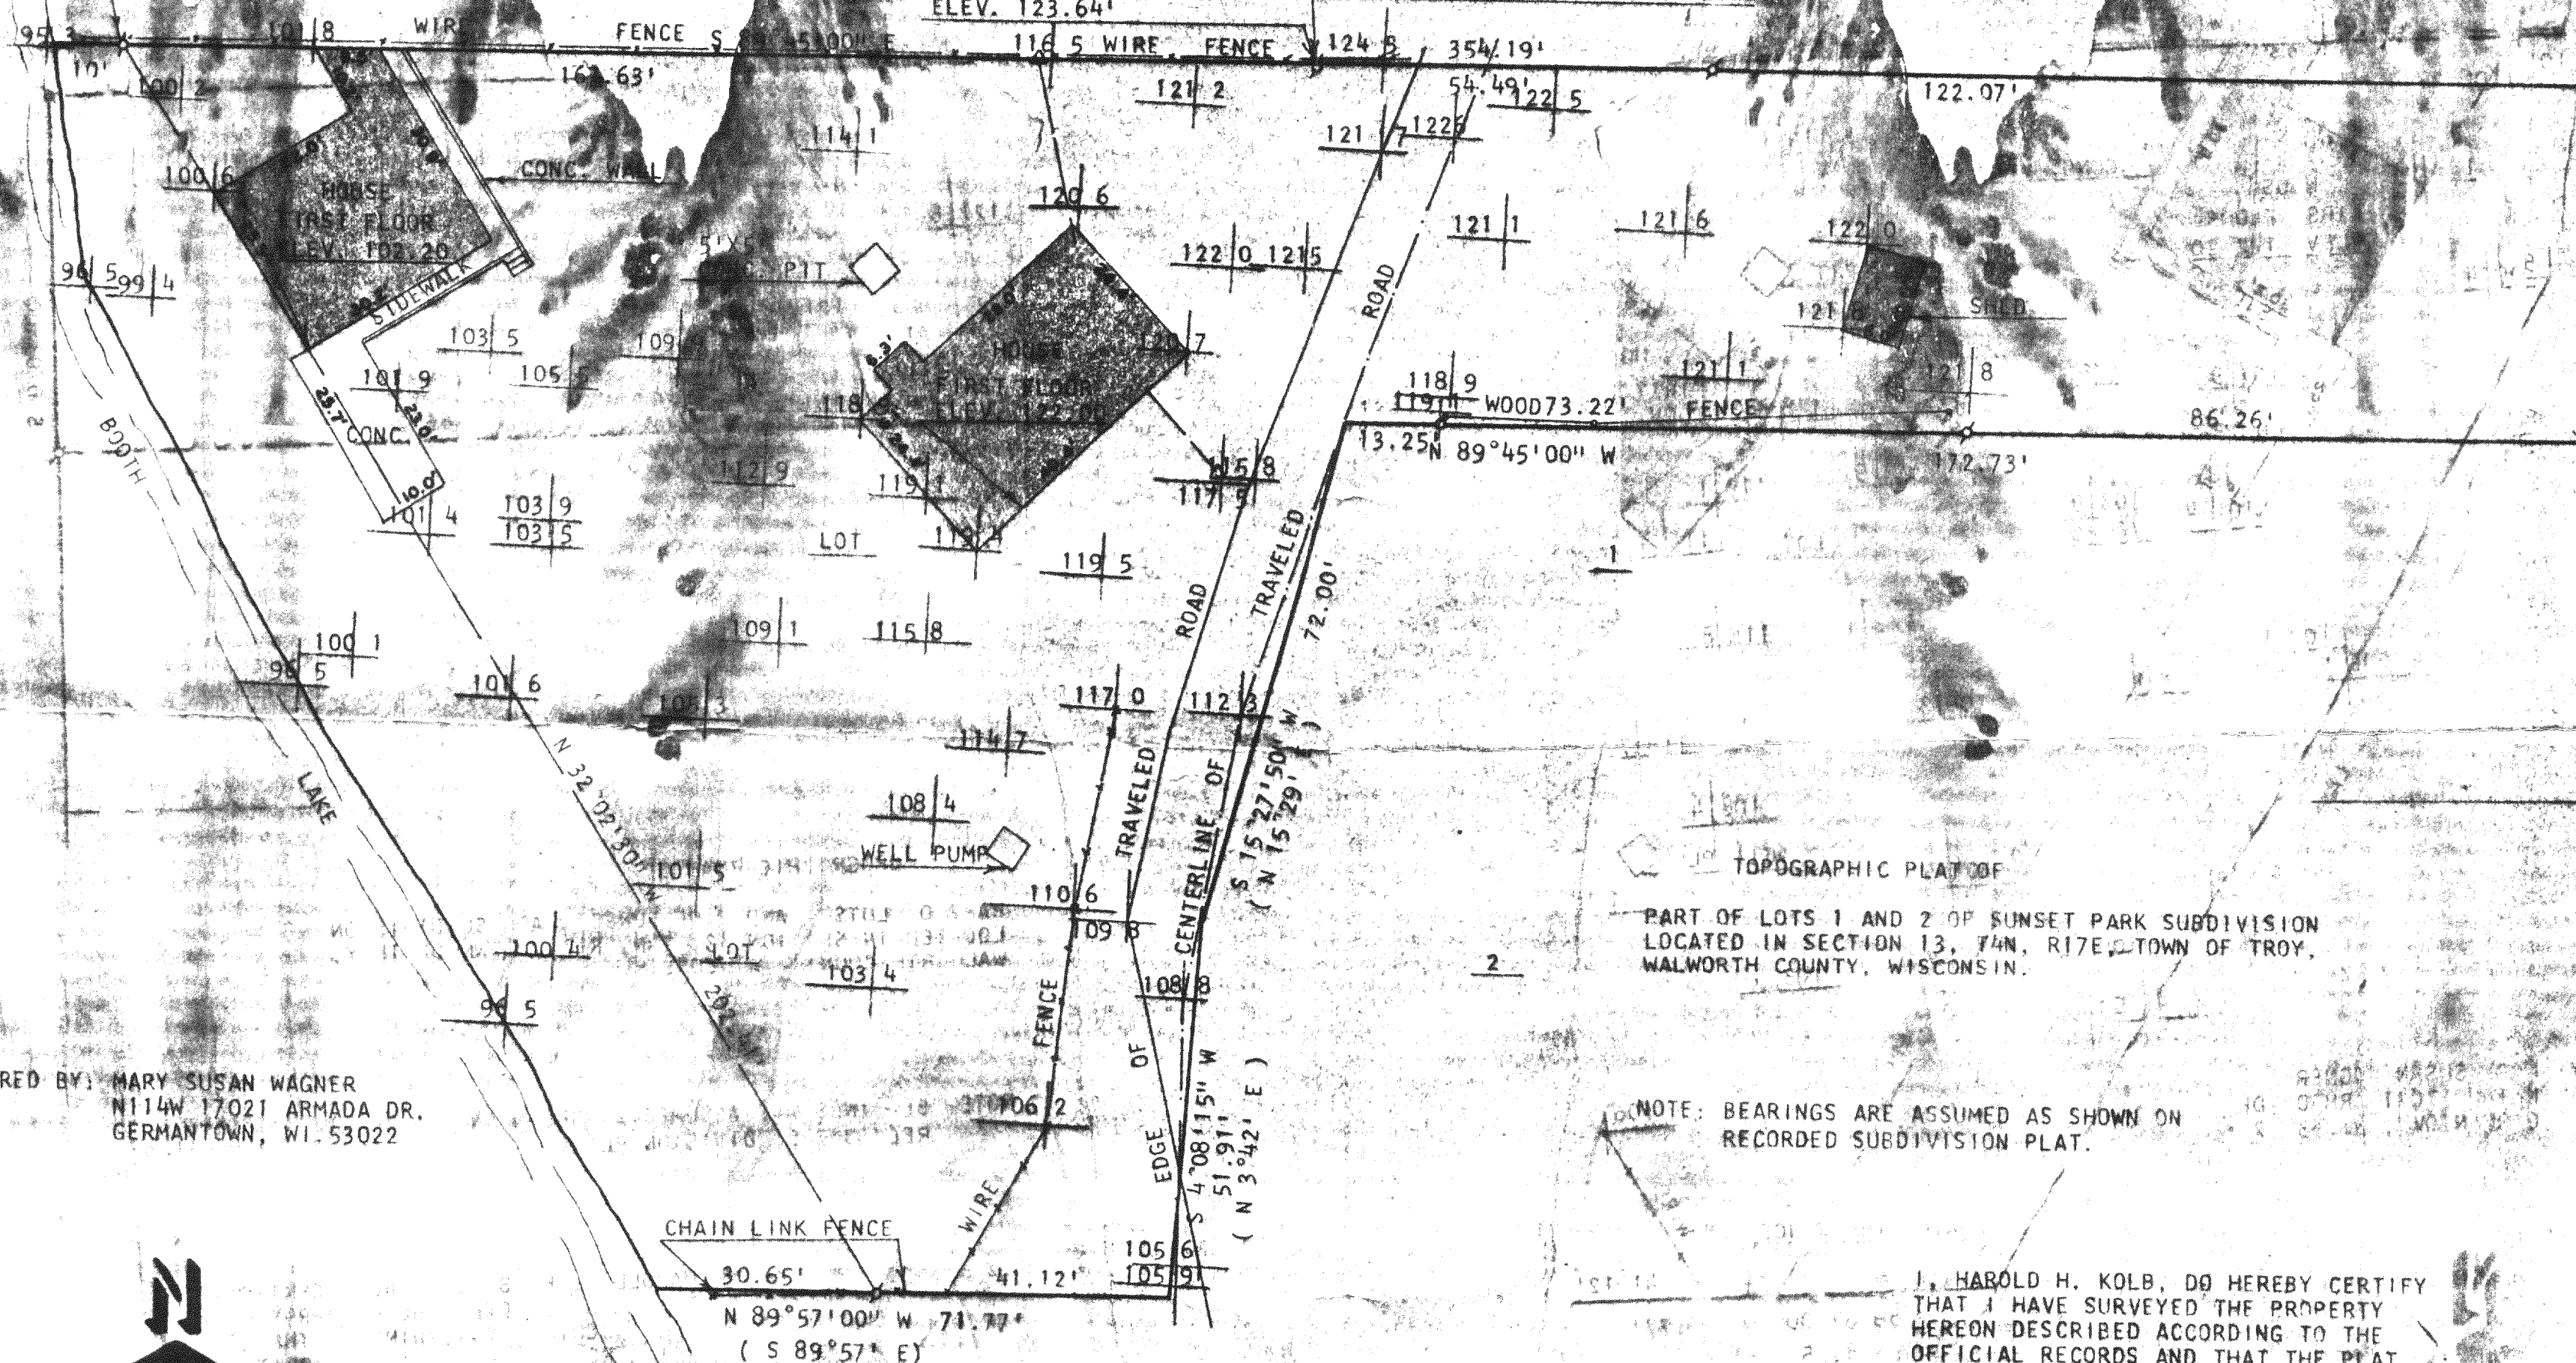


ORDERED BY: MARY SUSAN WAGNER
N114W 17021 ARMADA DR.
GERMANTOWN, WI. 53022



SCALE: 1" = 20'

LEGEND
d - IRON PIPE FOUND
o - IRON PIPE SET
() - AS RECORDED
BM - BENCHMARK
- IRON ROD FOUND

NOTE: BEARINGS ARE ASSUMED AS SHOWN ON
RECORDED SUBDIVISION PLAT.

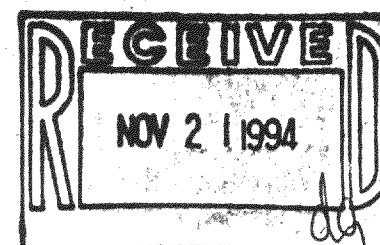

I, HAROLD H. KOLB, DO HEREBY CERTIFY
THAT I HAVE SURVEYED THE PROPERTY
HEREON DESCRIBED ACCORDING TO THE
OFFICIAL RECORDS AND THAT THE PLAT
HEREON IS A CORRECT REPRESENTATION
OF THE LOT LINES AND THE PRINCIPAL
LINES OF THE BUILDINGS TO THE BEST
OF MY KNOWLEDGE AND BELIEF. SURVEY
NOT VALID UNLESS SURVEYOR'S SIGNATURE
IS IN RED.

HAROLD H. KOLB
WISCONSIN REGISTERED LAND SURVEYOR, S-187

DATE: DECEMBER 23, 1993

LAS-1

417-402

