


Plat of Survey

Known as Kittie Court, in Town of Troy, Wisconsin
 Lot 1 in CERTIFIED SURVEY MAP, being a part of the SE 1/4 of Section 12 and the NE 1/4 of
 Section 13, T 4 N, R 17 E, in the Town of Troy, Walworth County, Wisconsin


JUNE 16, 1978

SURVEY NO. 142853-M

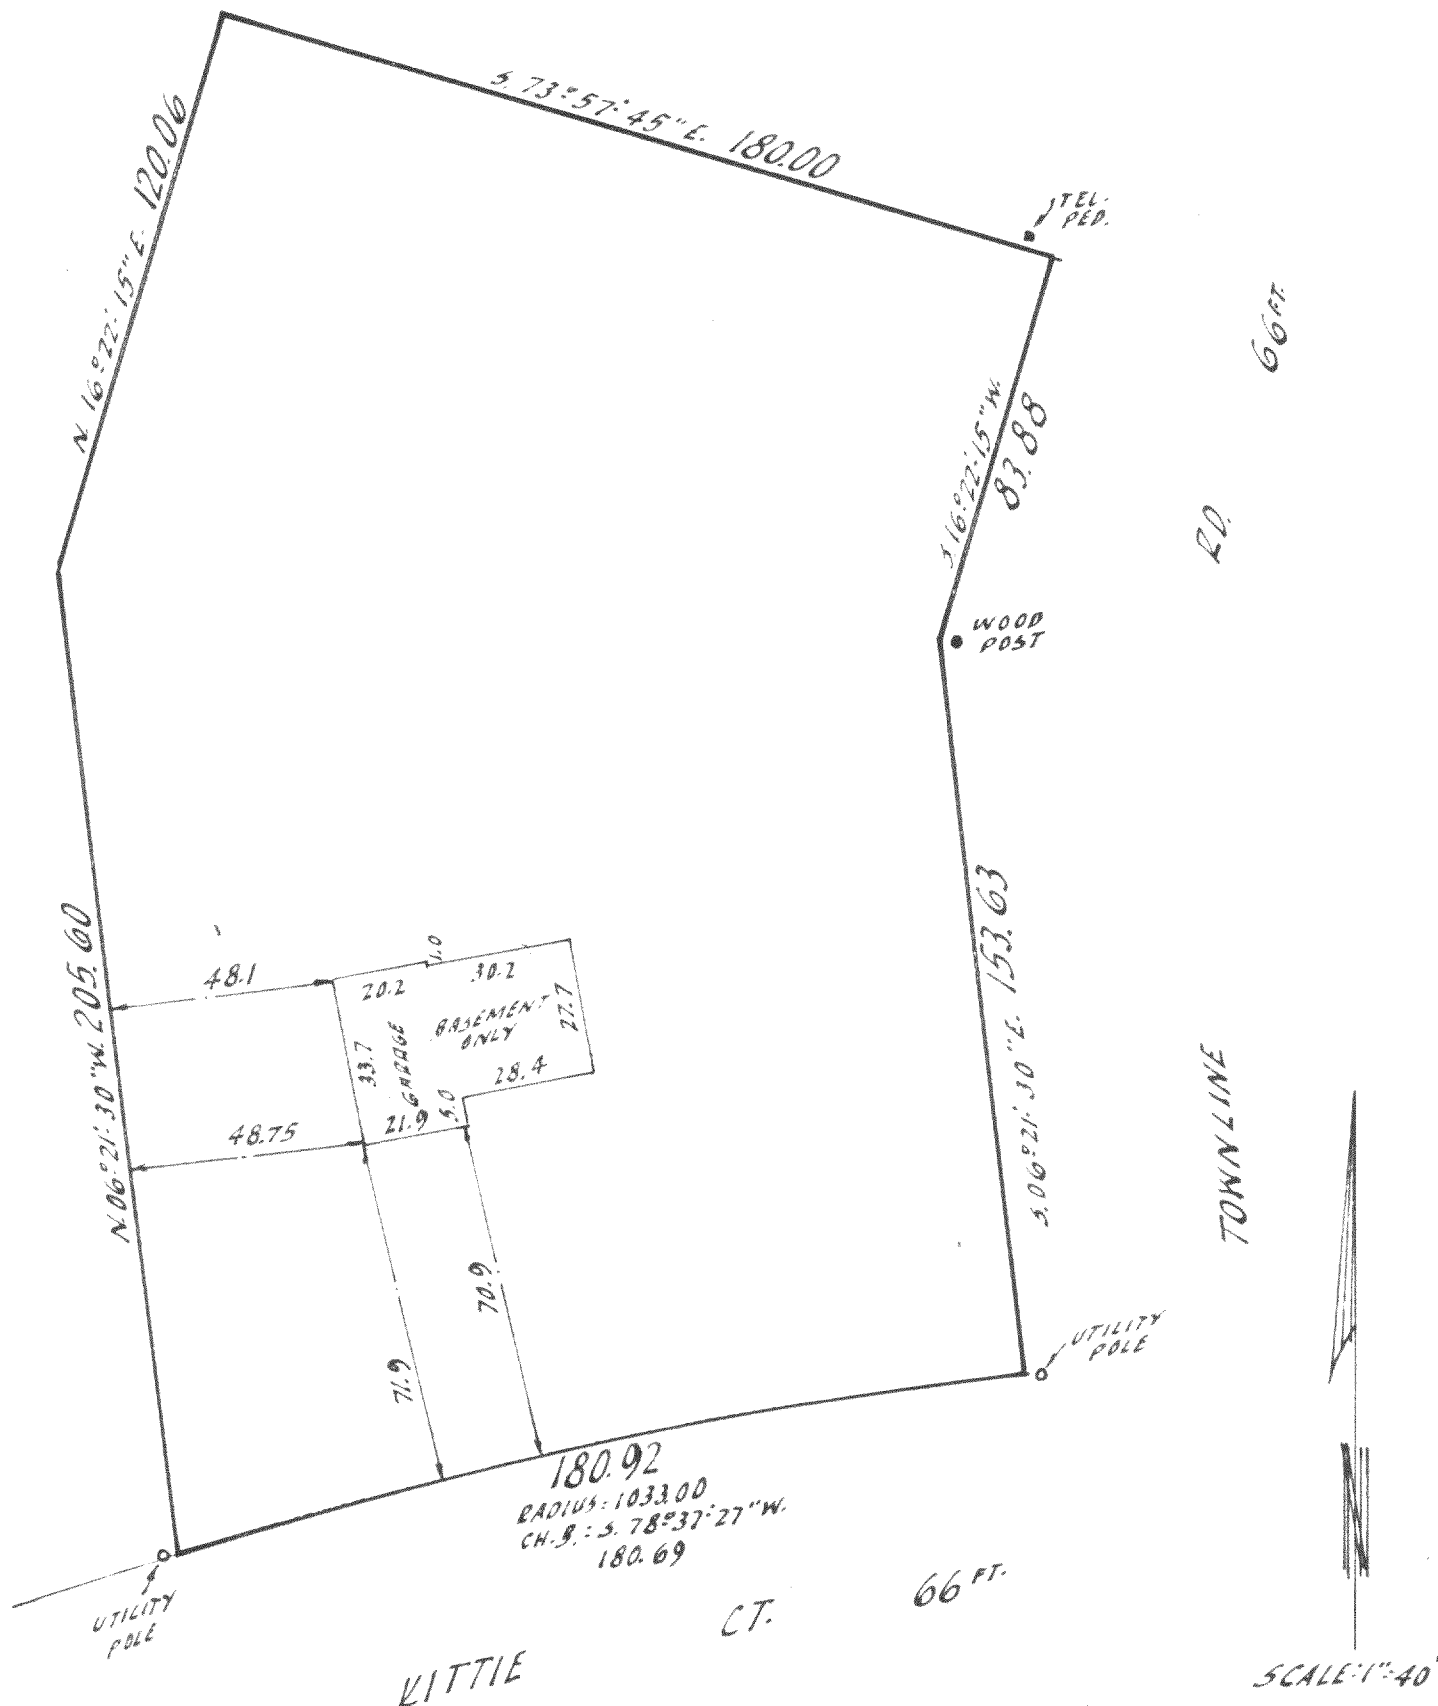

I Certify that I have surveyed the above described property (Property), and the above map is a true representation thereof and shows the size and location of the Property, its exterior boundaries, the location and dimensions of all visible structures thereon, boundary fences, apparent easements and roadways and visible encroachments, if any.

This survey is made for the exclusive use of the present owners of the Property, and also those who purchase, mortgage, or guarantee the title thereto, within one (1) year from date hereof.

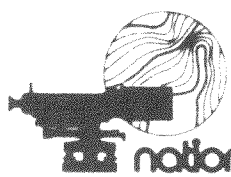


LS553

national survey & engineering

3470 north 127th street • p.o. box 444 • brookfield, wisconsin, 53005 • phone 414 / 781-1000

Kenneth E. Berke
 SURVEYOR

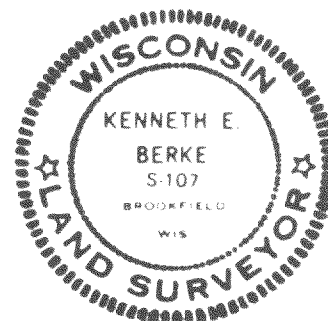

417-43