

SURVEY NO. 752 A

LOCATION: East side of PLEASANT LAKE ROAD, 1 mile East of the intersection of U.S. 12 & STH 61 (where STH 20) to Pleasant Lake Road, then South on Pleasant Lake Road 1/4 mile.

DESCRIPTION: PARCEL "A" A parcel of Land in the NW 1/4 Sec. 19-T4N-R17E in the Town of Troy, Walworth County, State of Wisconsin more particularly described as follows: Commencing at the Southwest corner of said 1/4 section, thence North on and along the West line of said 1/4 section (also being the West line of Sec. 19 and the center line of the Pleasant Lake Road), 6696.8 feet to the place of beginning of the land to be described; thence continuing North on and along the West line of said 1/4 section (and being the center line of the Pleasant Lake Road), 420 feet to a point; thence N 86° 02' E. and parallel with the South line of said 1/4 section, 1266.10 feet to a point on the West 1/16 line of said section 19; thence S 0° 15' W on and along said 1/16 line, 750 feet to a point on the South line of said NW 1/4 Sec. 19-4-17; thence N 79° 0' 15" W, 1270.03 feet to the point of beginning, containing 16.72 acres of Land.

PARCEL "B" A parcel of land in the NW 1/4 Sec. 19-T4N-R17E in the Town of Troy, Walworth County, State of Wisconsin more particularly described as follows: Commencing at the S.W. Corner of said 1/4 section; thence North on and along the West line of said 1/4 section (also being the West line of Section 19-4-17 and the center line of the Pleasant Lake Road), 6696.8 feet to a point; thence S 79° 0' 15" E, 1270.03' to a point on the West 1/16 line of said section 19; thence S 1° 15' W on and along the West 1/16 line of section 19, 341.50 feet to a point on the South line of said 1/4 section; thence S 86° 02' W on and along the South line of said 1/4 section, 1242.20' to the point of commencement, containing 14.576 acres of Land.


Survey for Richard & Beverly Good and present Owner of Farm.

State of Wisconsin ss
County of Milwaukee)


I hereby certify that I have accurately surveyed the above described property and that the above drawn plat is a correct representation thereof and shows the exterior boundary lines and location of present residence and other improvements on said property, and the correct measurements thereof dated this 6th day of August, 1971

Registered Prof. Eng. - Land Surveyor

NOTE: Present owner of farm is now constructing his new residence on Parcel "B" and shown in its approximate location and size

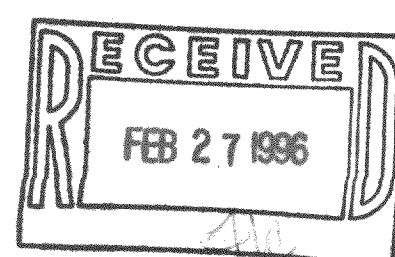

LT-19-8
LT-19-8A
LT-19-10

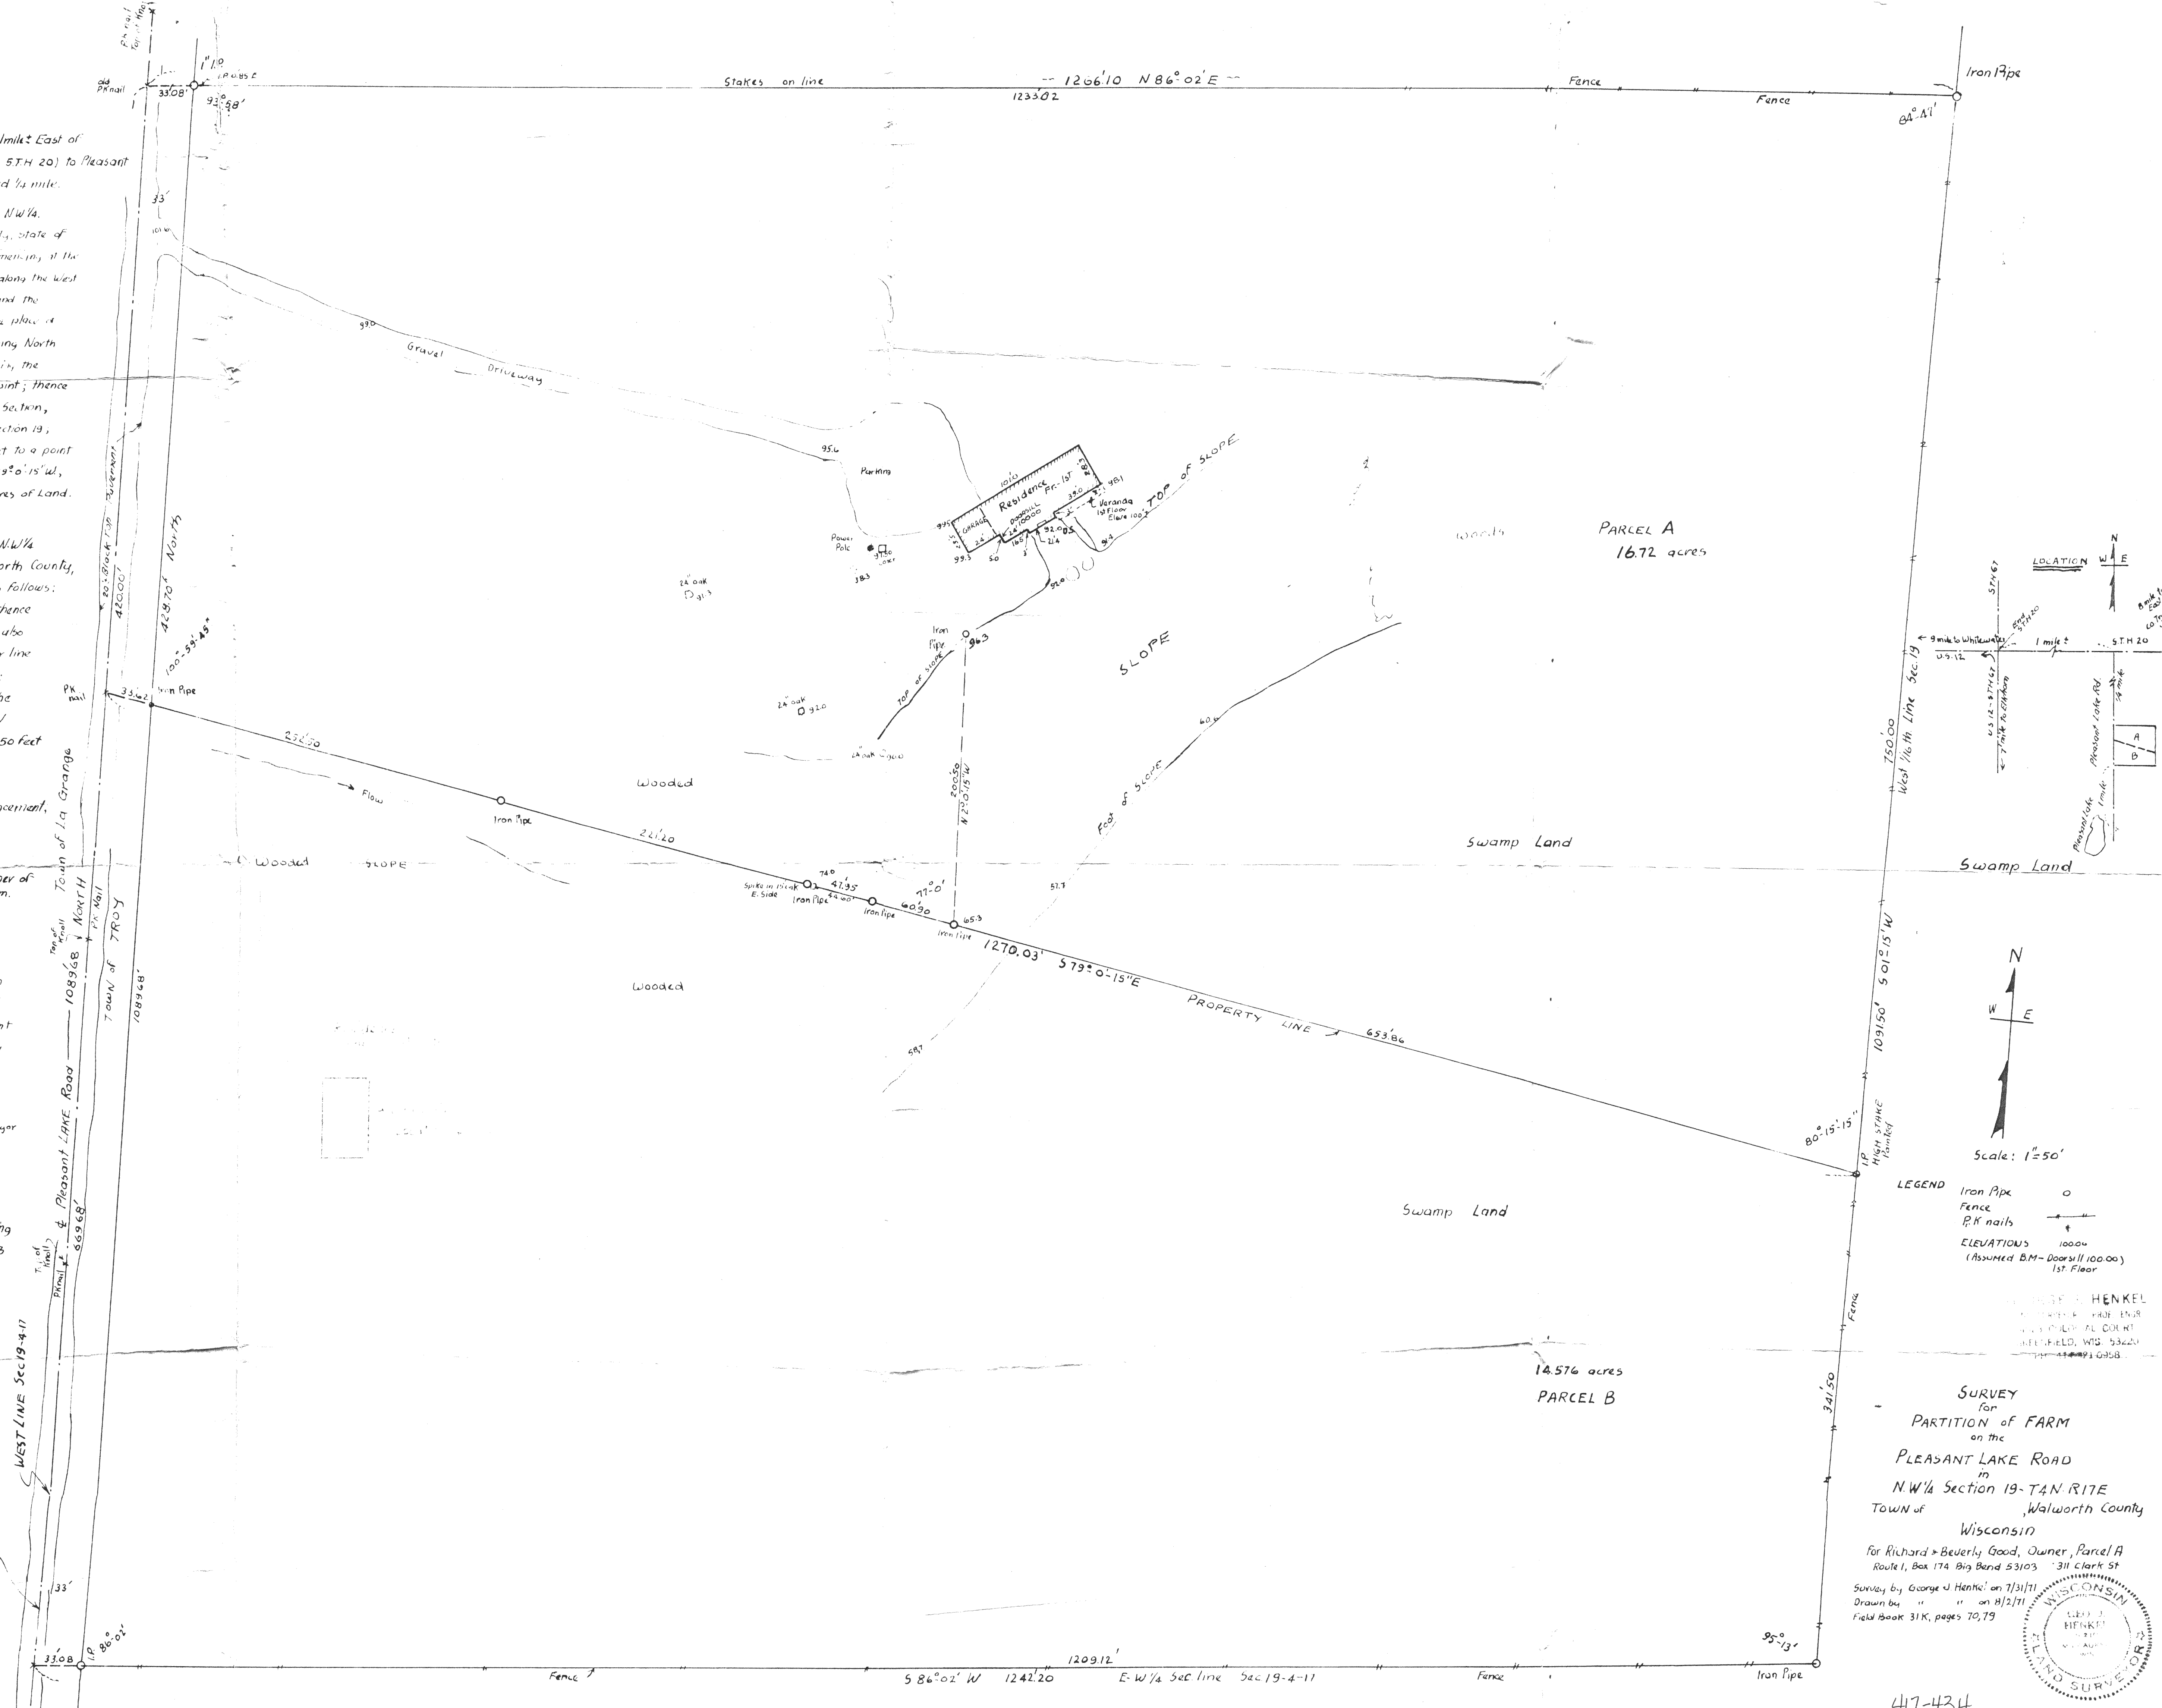

LEGEND
Iron Pipe $\circ$
Fence $---$
P.K. nails $+$
ELEVATIONS 1000.00
(Assumed B.M. - Doorsill 100.00)
1st Floor

JOSEPH HENKEL
REGISTERED LAND SURVEYOR
WISCONSIN
1111 CLARK ST.
MILWAUKEE, WIS. 53202
TEL. 441-4911

SURVEY
for
PARTITION of FARM
on the
PLEASANT LAKE ROAD
in
NW 1/4 Section 19-T4N-R17E
Town of
Walworth County
Wisconsin
for Richard & Beverly Good, Owner, Parcel A
Route 1, Box 174 Big Bend 53103 311 Clark St
Survey by George J. Henkel on 7/31/71
Drawn by " " on 8/2/71
Field Book 31K, pages 70, 79



47-434