
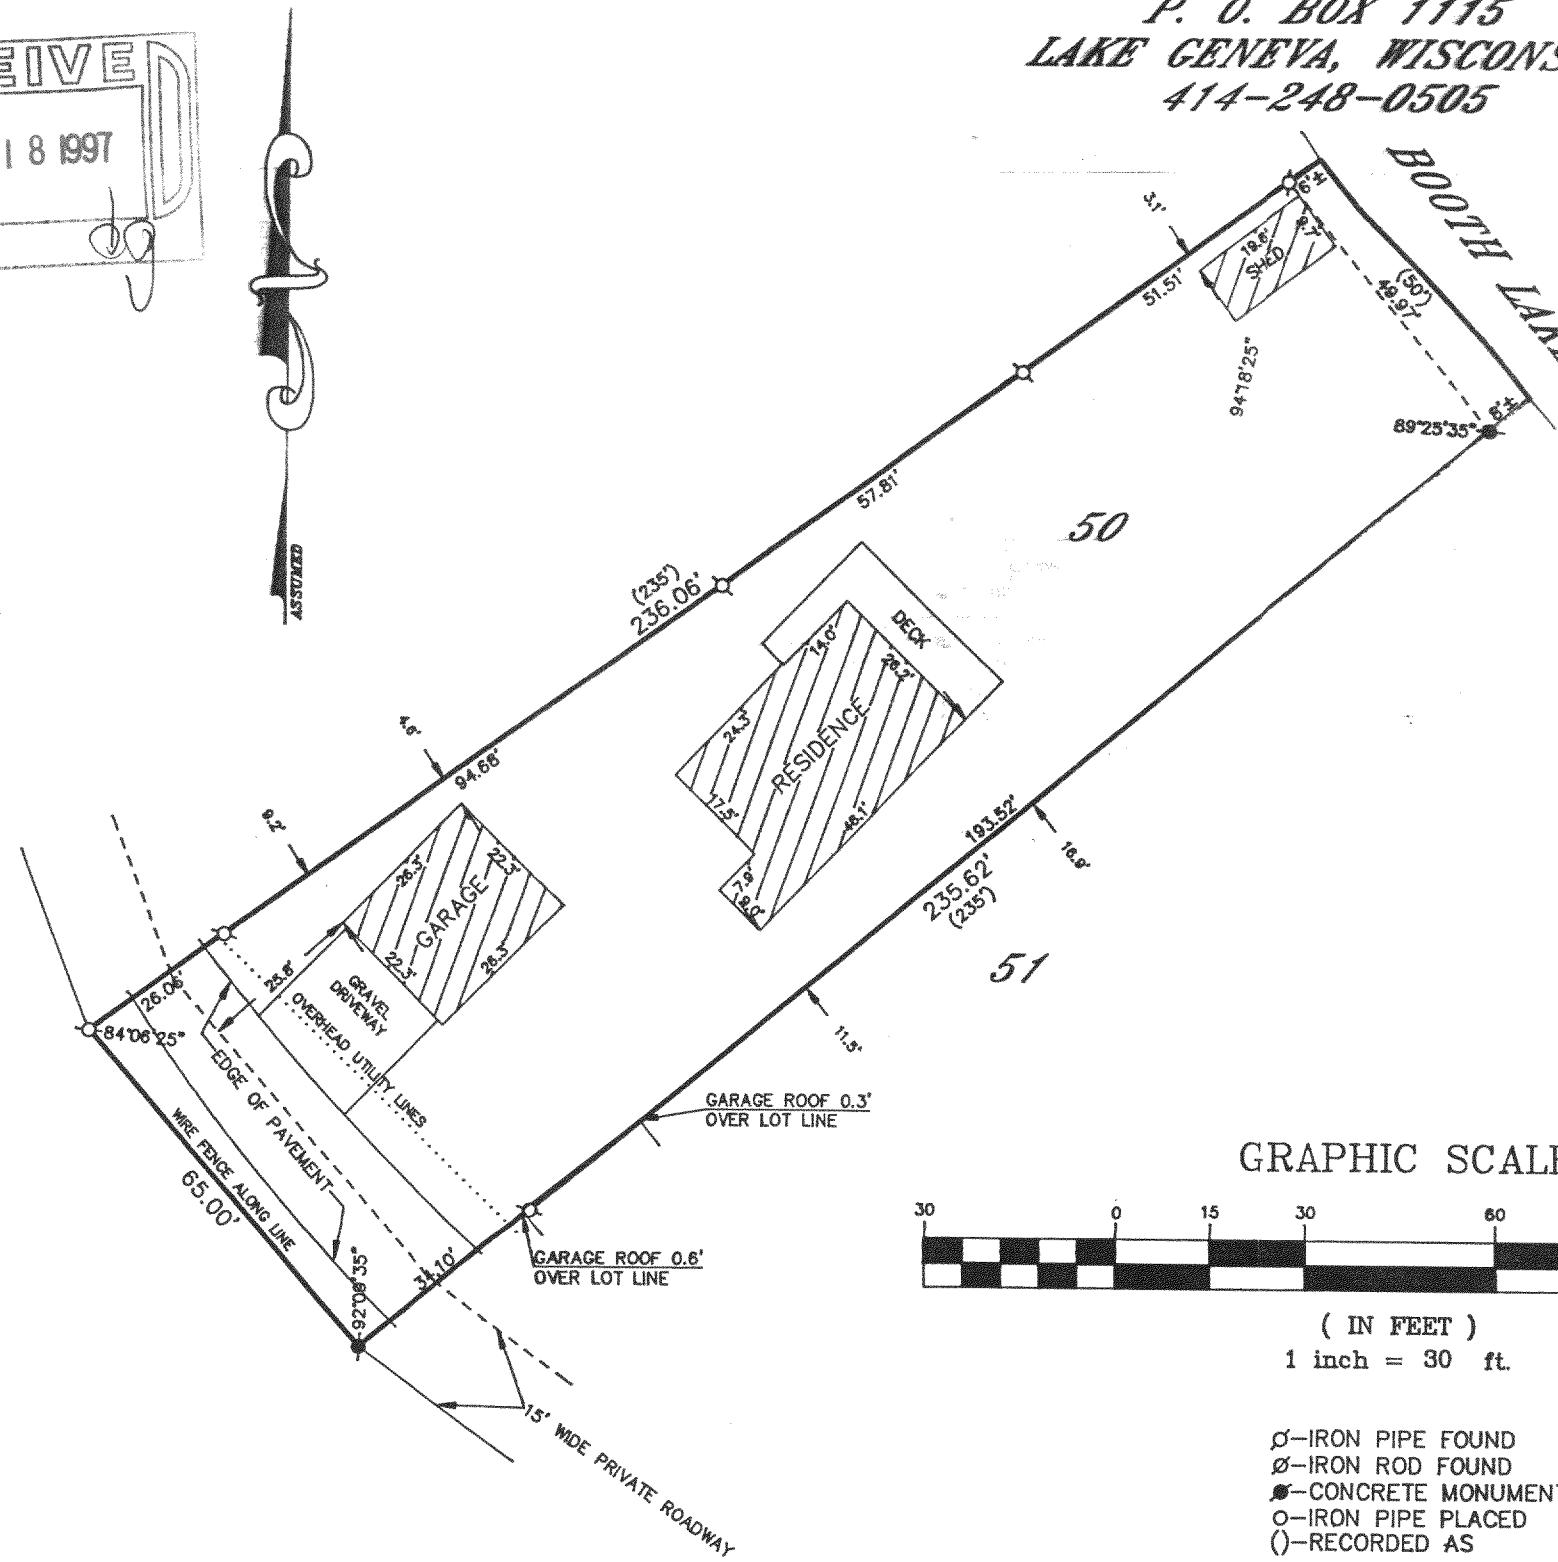


WALWORTH COUNTY
SURVEYING & MAPPING
P. O. BOX 1115
LAKE GENEVA, WISCONSIN
414-248-0505

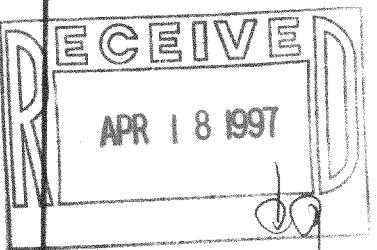

PLAT OF SURVEY OF

LOT 50 IN BOOTH LAKE HEIGHTS IN THE EAST 1/2 OF THE SOUTHWEST 1/4
AND THE WEST 1/2 OF THE SOUTHEAST 1/4 OF SECTION 13 AND THE WEST
1/2 OF THE NORTHWEST 1/4 OF SECTION 24, ALL IN T 4 N, T 17 E,
TOWNSHIP OF TROY, COUNTY OF WALWORTH AND STATE OF WISCONSIN.

ORDERED BY: RE/MAX GENEVA REALTY
101 BROAD STREET
LAKE GENEVA, WISCONSIN
53147

GRAPHIC SCALI



(IN FEET)

Ø-IRON PIPE FOUND
Ø-IRON ROD FOUND
█-CONCRETE MONUMENT FOUND
O-IRON PIPE PLACED
()-RECORDED AS

I HEREBY CERTIFY THAT I HAVE SURVEYED THE ABOVE DESCRIBED PROPERTY AND THAT THE ABOVE MAP IS A TRUE REPRESENTATION THEREOF AND SHOWS THE SIZE AND LOCATION OF THE PROPERTY, ITS EXTERIOR BOUNDARIES, THE LOCATION OF ALL VISIBLE STRUCTURES AND DIMENSIONS OF ALL PRINCIPAL BUILDINGS THEREON, BOUNDARY FENCES, APPARENT EASEMENTS, ROADWAYS AND VISIBLE ENCROACHMENTS, IF ANY, TO THE BEST OF MY KNOWLEDGE AND BELIEF.

THIS SURVEY IS MADE FOR THE USE OF THE PRESENT OWNERS OF THE PROPERTY AND ALSO THOSE WHO PURCHASE, MORTGAGE OR QUARANTEE THE TITLE THERETO WITHIN ONE (1) YEAR FROM DATE HEREOF.

ROBERT M. BAERENWALD
WISCONSIN REGISTERED LAND SURVEYOR, S-1502

DATE Nov. 2, 1996 JOB NO. 5274

NOTE: THIS IS NOT A CERTIFIED COPY UNLESS SEALED.

LBL- 43

417-499