



146-2-1

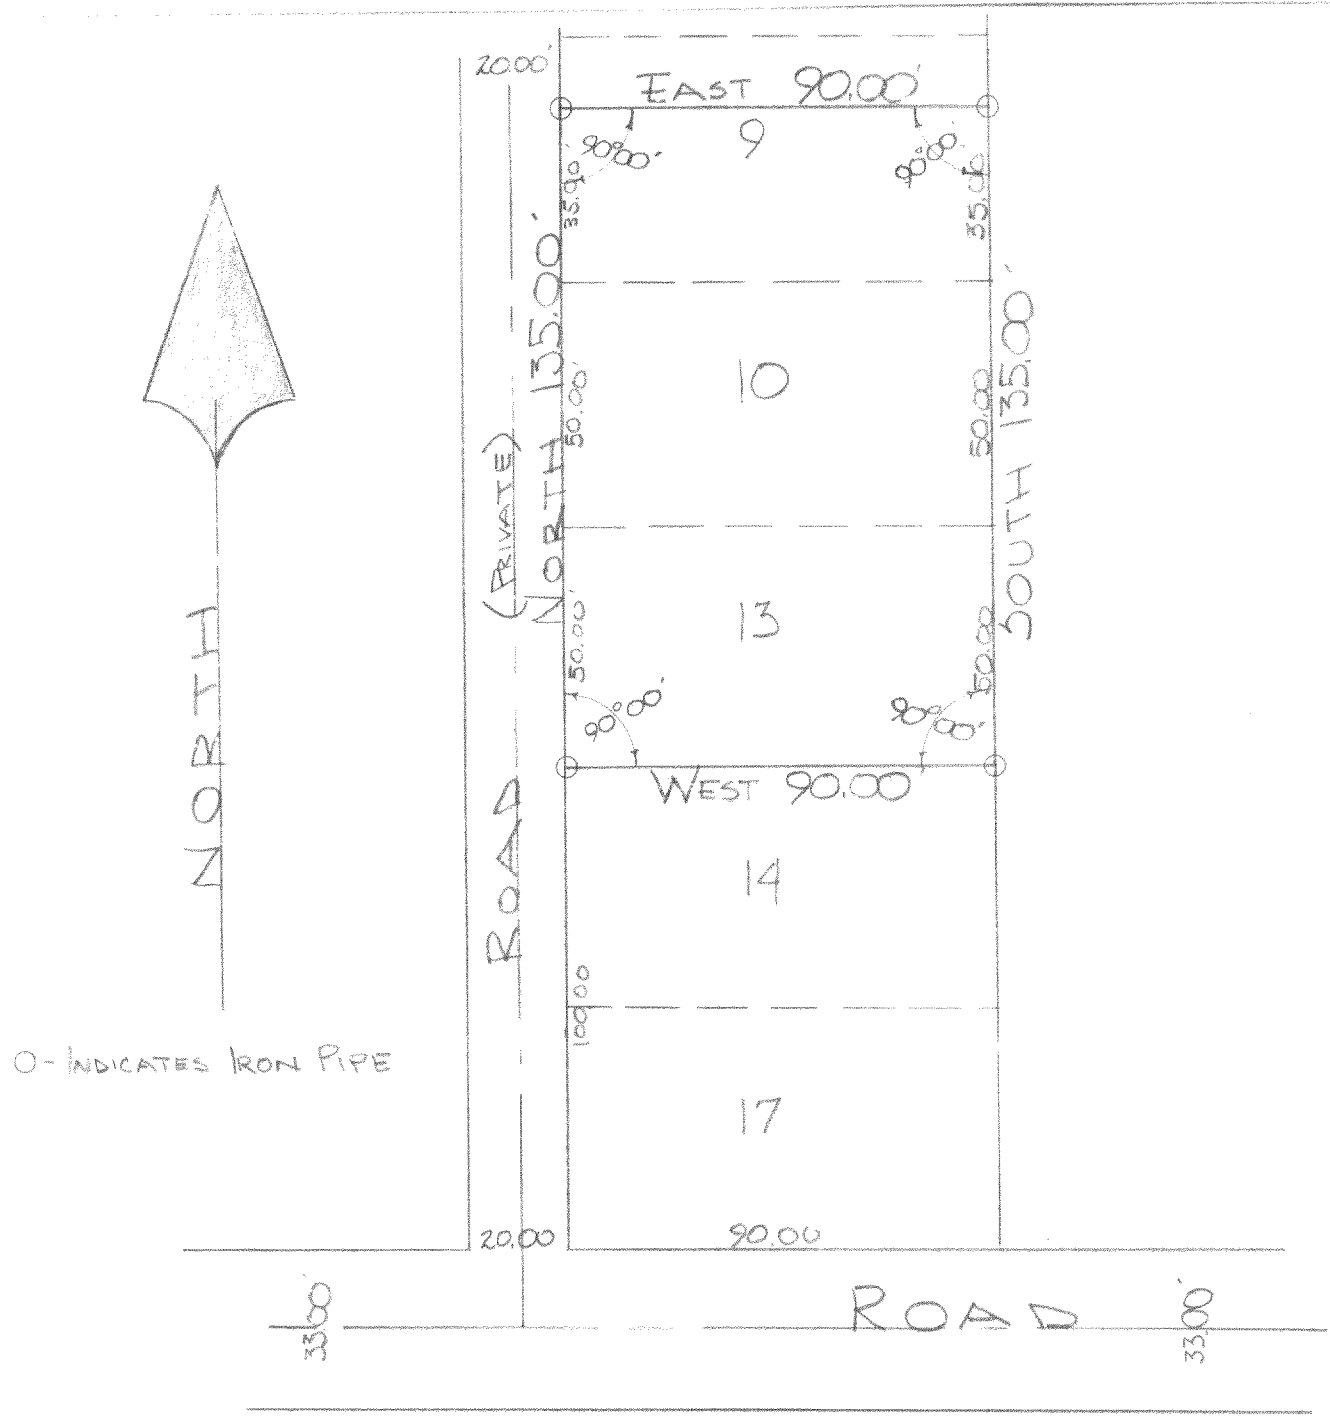

DESCRIPTION: Lots 13, 10, and the South 35.00 feet of Lot 9 in Fenlon's Addition, located in Section 24, T. 4 N., R. 17 E., (Town of Troy) Walworth County, Wisconsin.

CERTIFICATE: I, James F. Biagi, Surveyor, do hereby certify that I have surveyed the property hereon described on this 6th day of March, 1962.

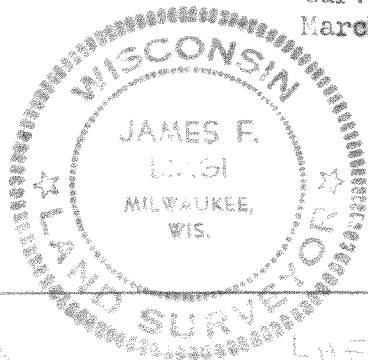

*James F. Biagi*

James F. Biagi, RLS 202

LHF-1C1

W - TE

LHF-2

417-4B